


Application No. *11-76086*
Permit No.


CERTIFICATE NO. 70073 79660

UNITED STATES
DEPARTMENT OF THE INTERIOR
GEOLOGICAL SURVEY

MEACHAM LAKE QUADRANGLE
OREGON
7.5 MINUTE SERIES (TOPOGRAPHIC)

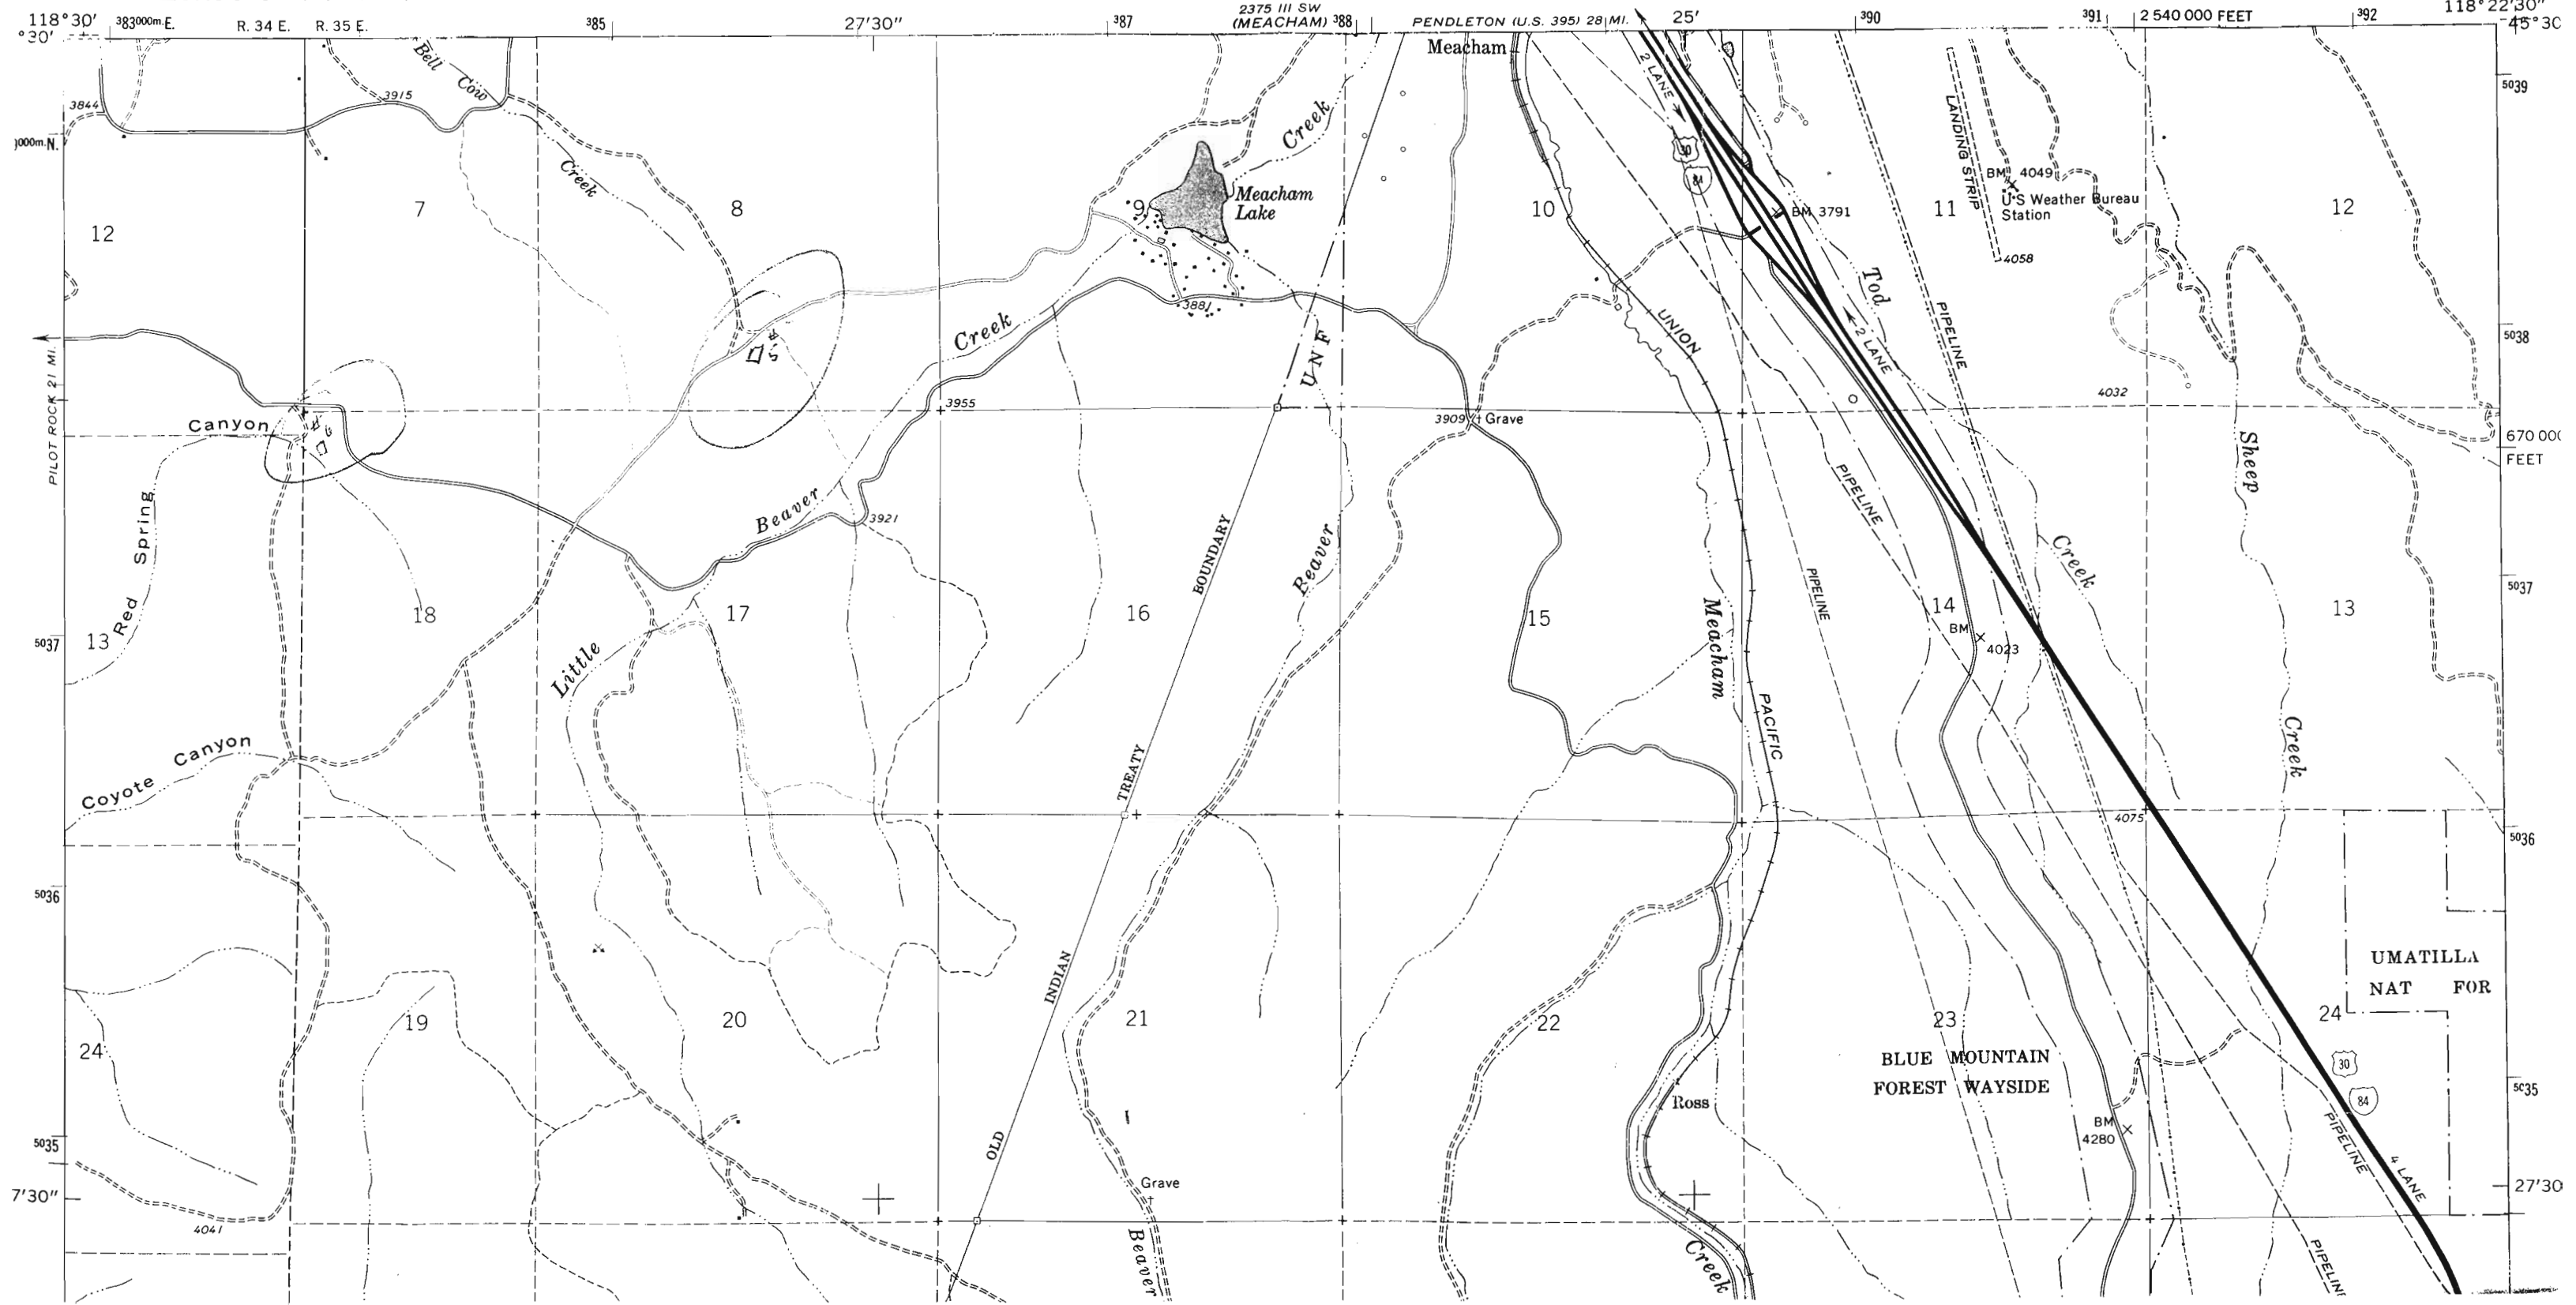

7'30" R 33 E PILOT ROCK 12 MI. R 34 E 375000m E. 376 35' 377 2275 11 SE (CABBAGE HILL) 379 32'30" MEACHAM 7 MI. 381 2510 000 FEET 382 118°30' 45'30"

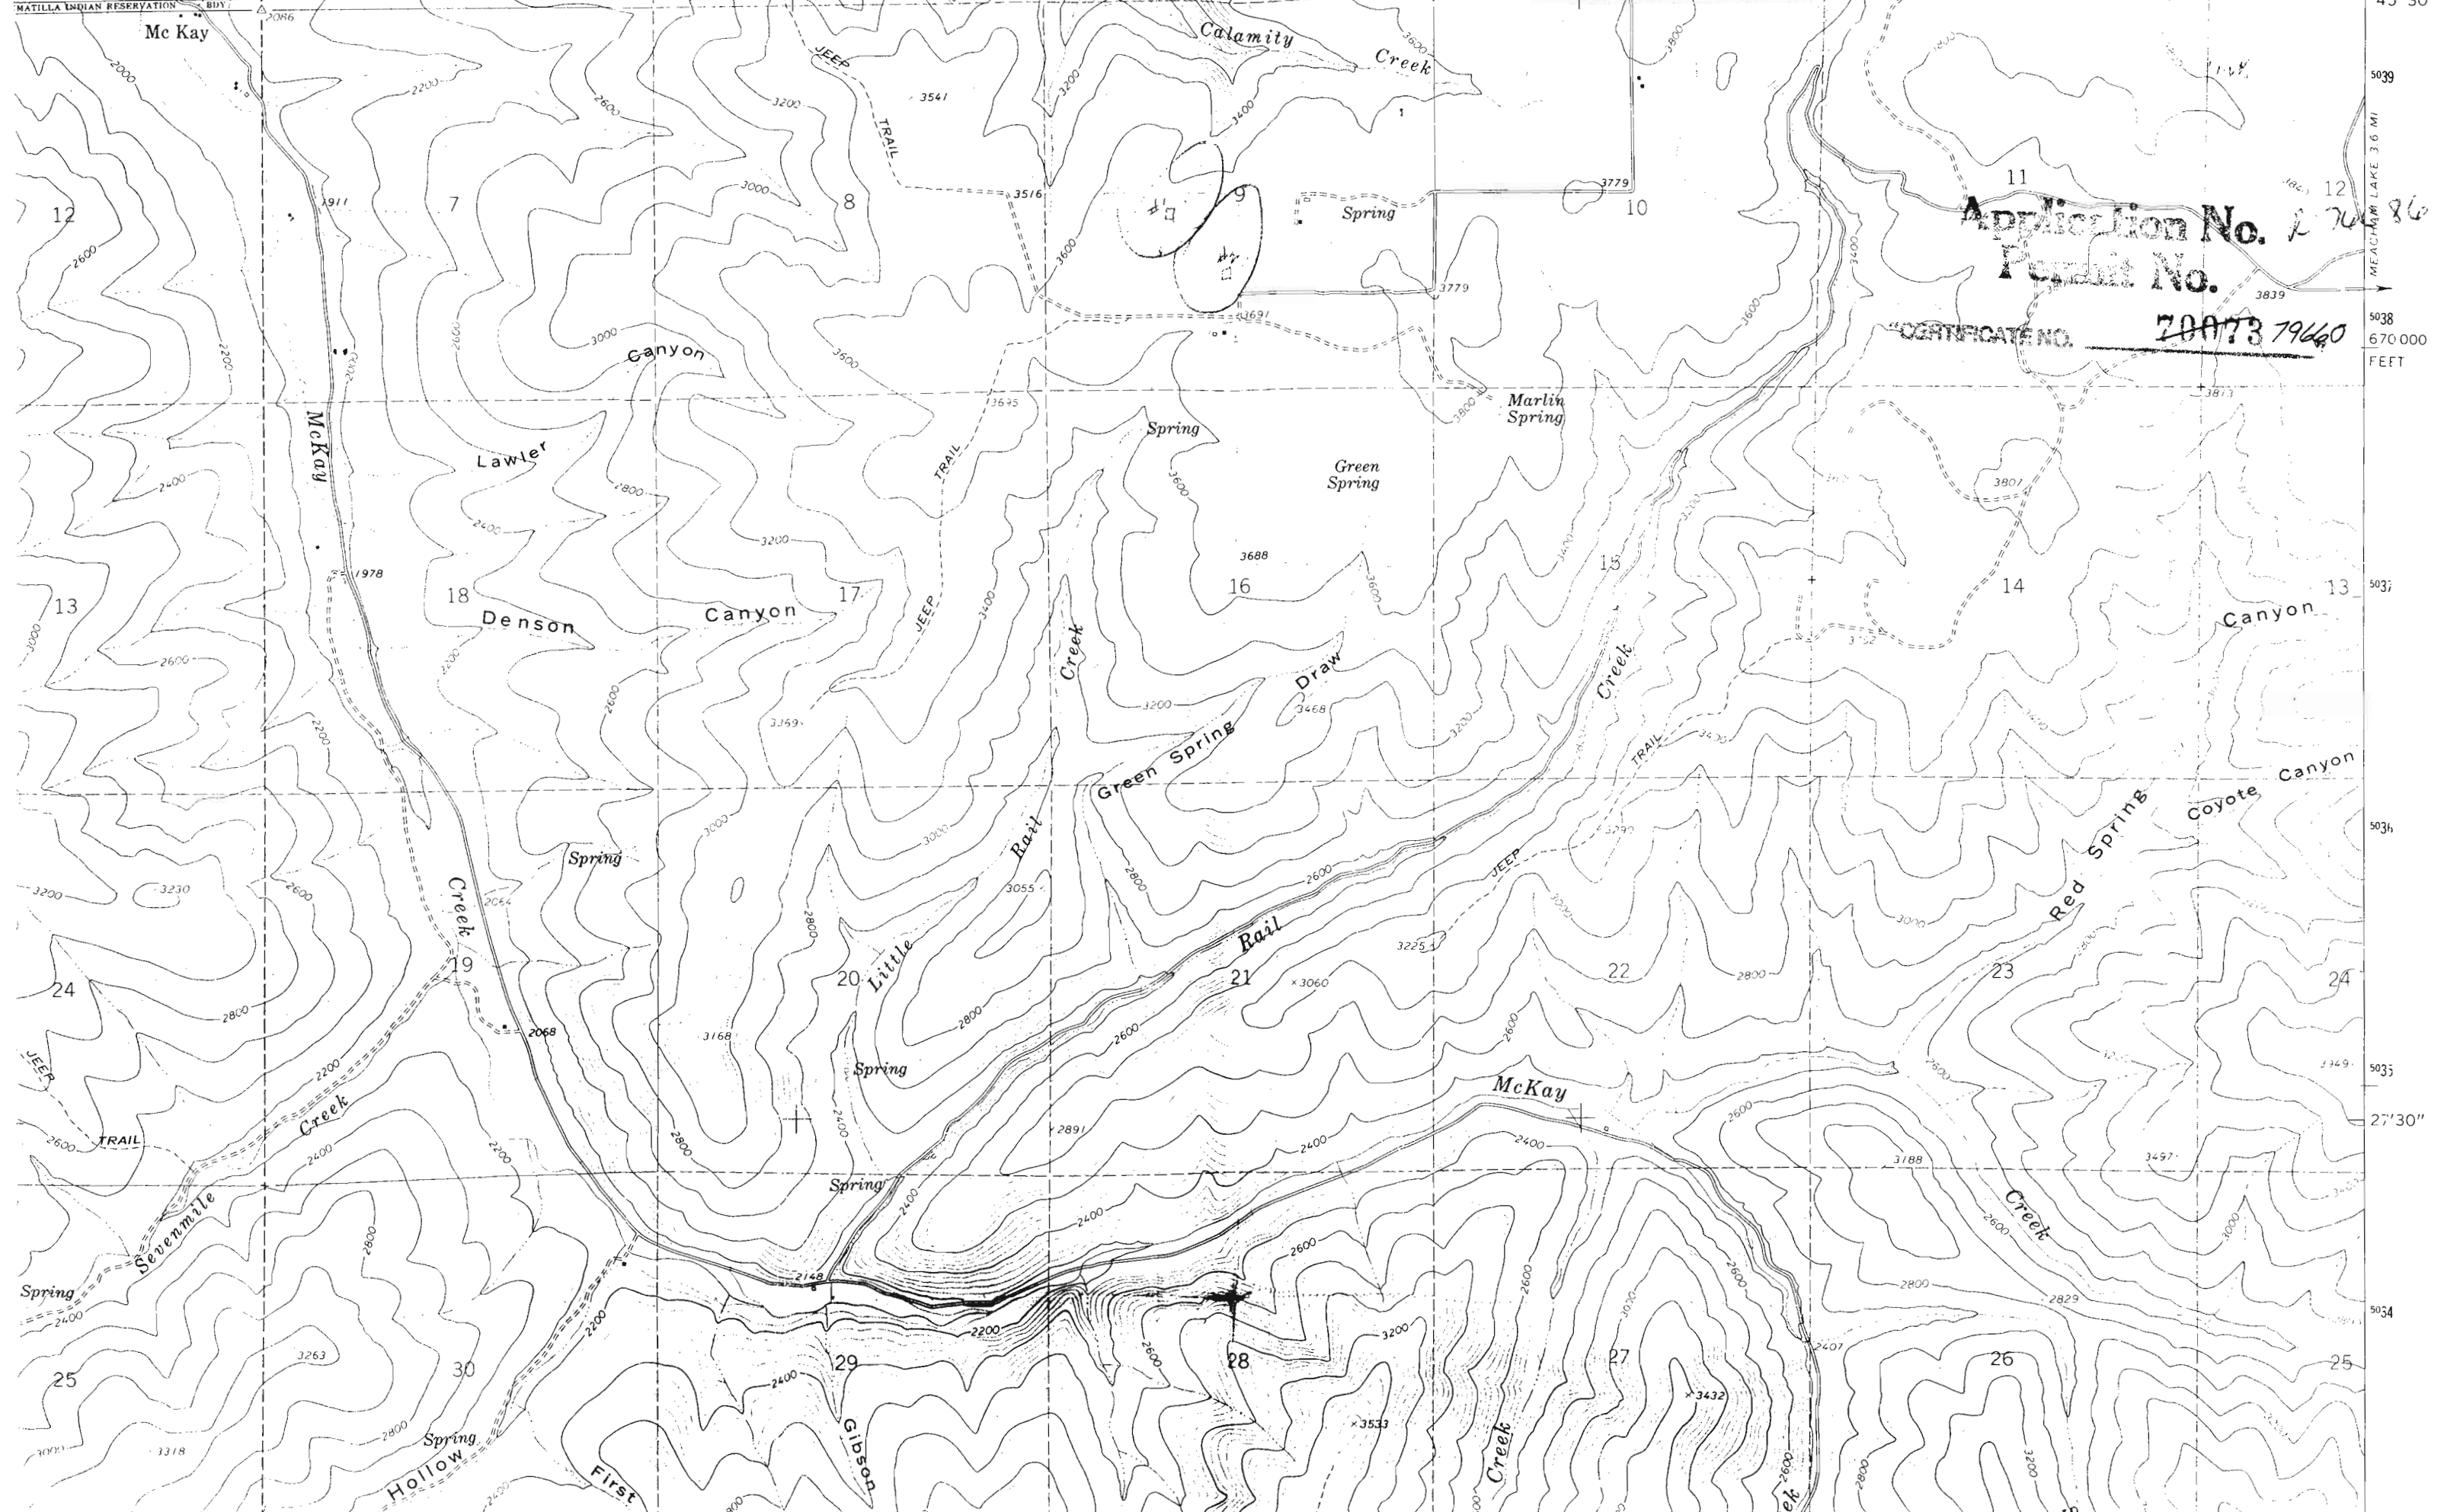

Application No. 27086
Permit No.

CERTIFICATE NO. 70073 79660

5039
MEACHAM LAKE 3.6 MI
5038
670 000
FEET

27'30"


5034

RECEIVED
DEC 29 1994
WATER RESOURCES DEPT
SALEM, OREGON


Application No. *12-76086*
Permit No. *70073 79660*

CERTIFICATE NO. *70073 79660*

Working Map

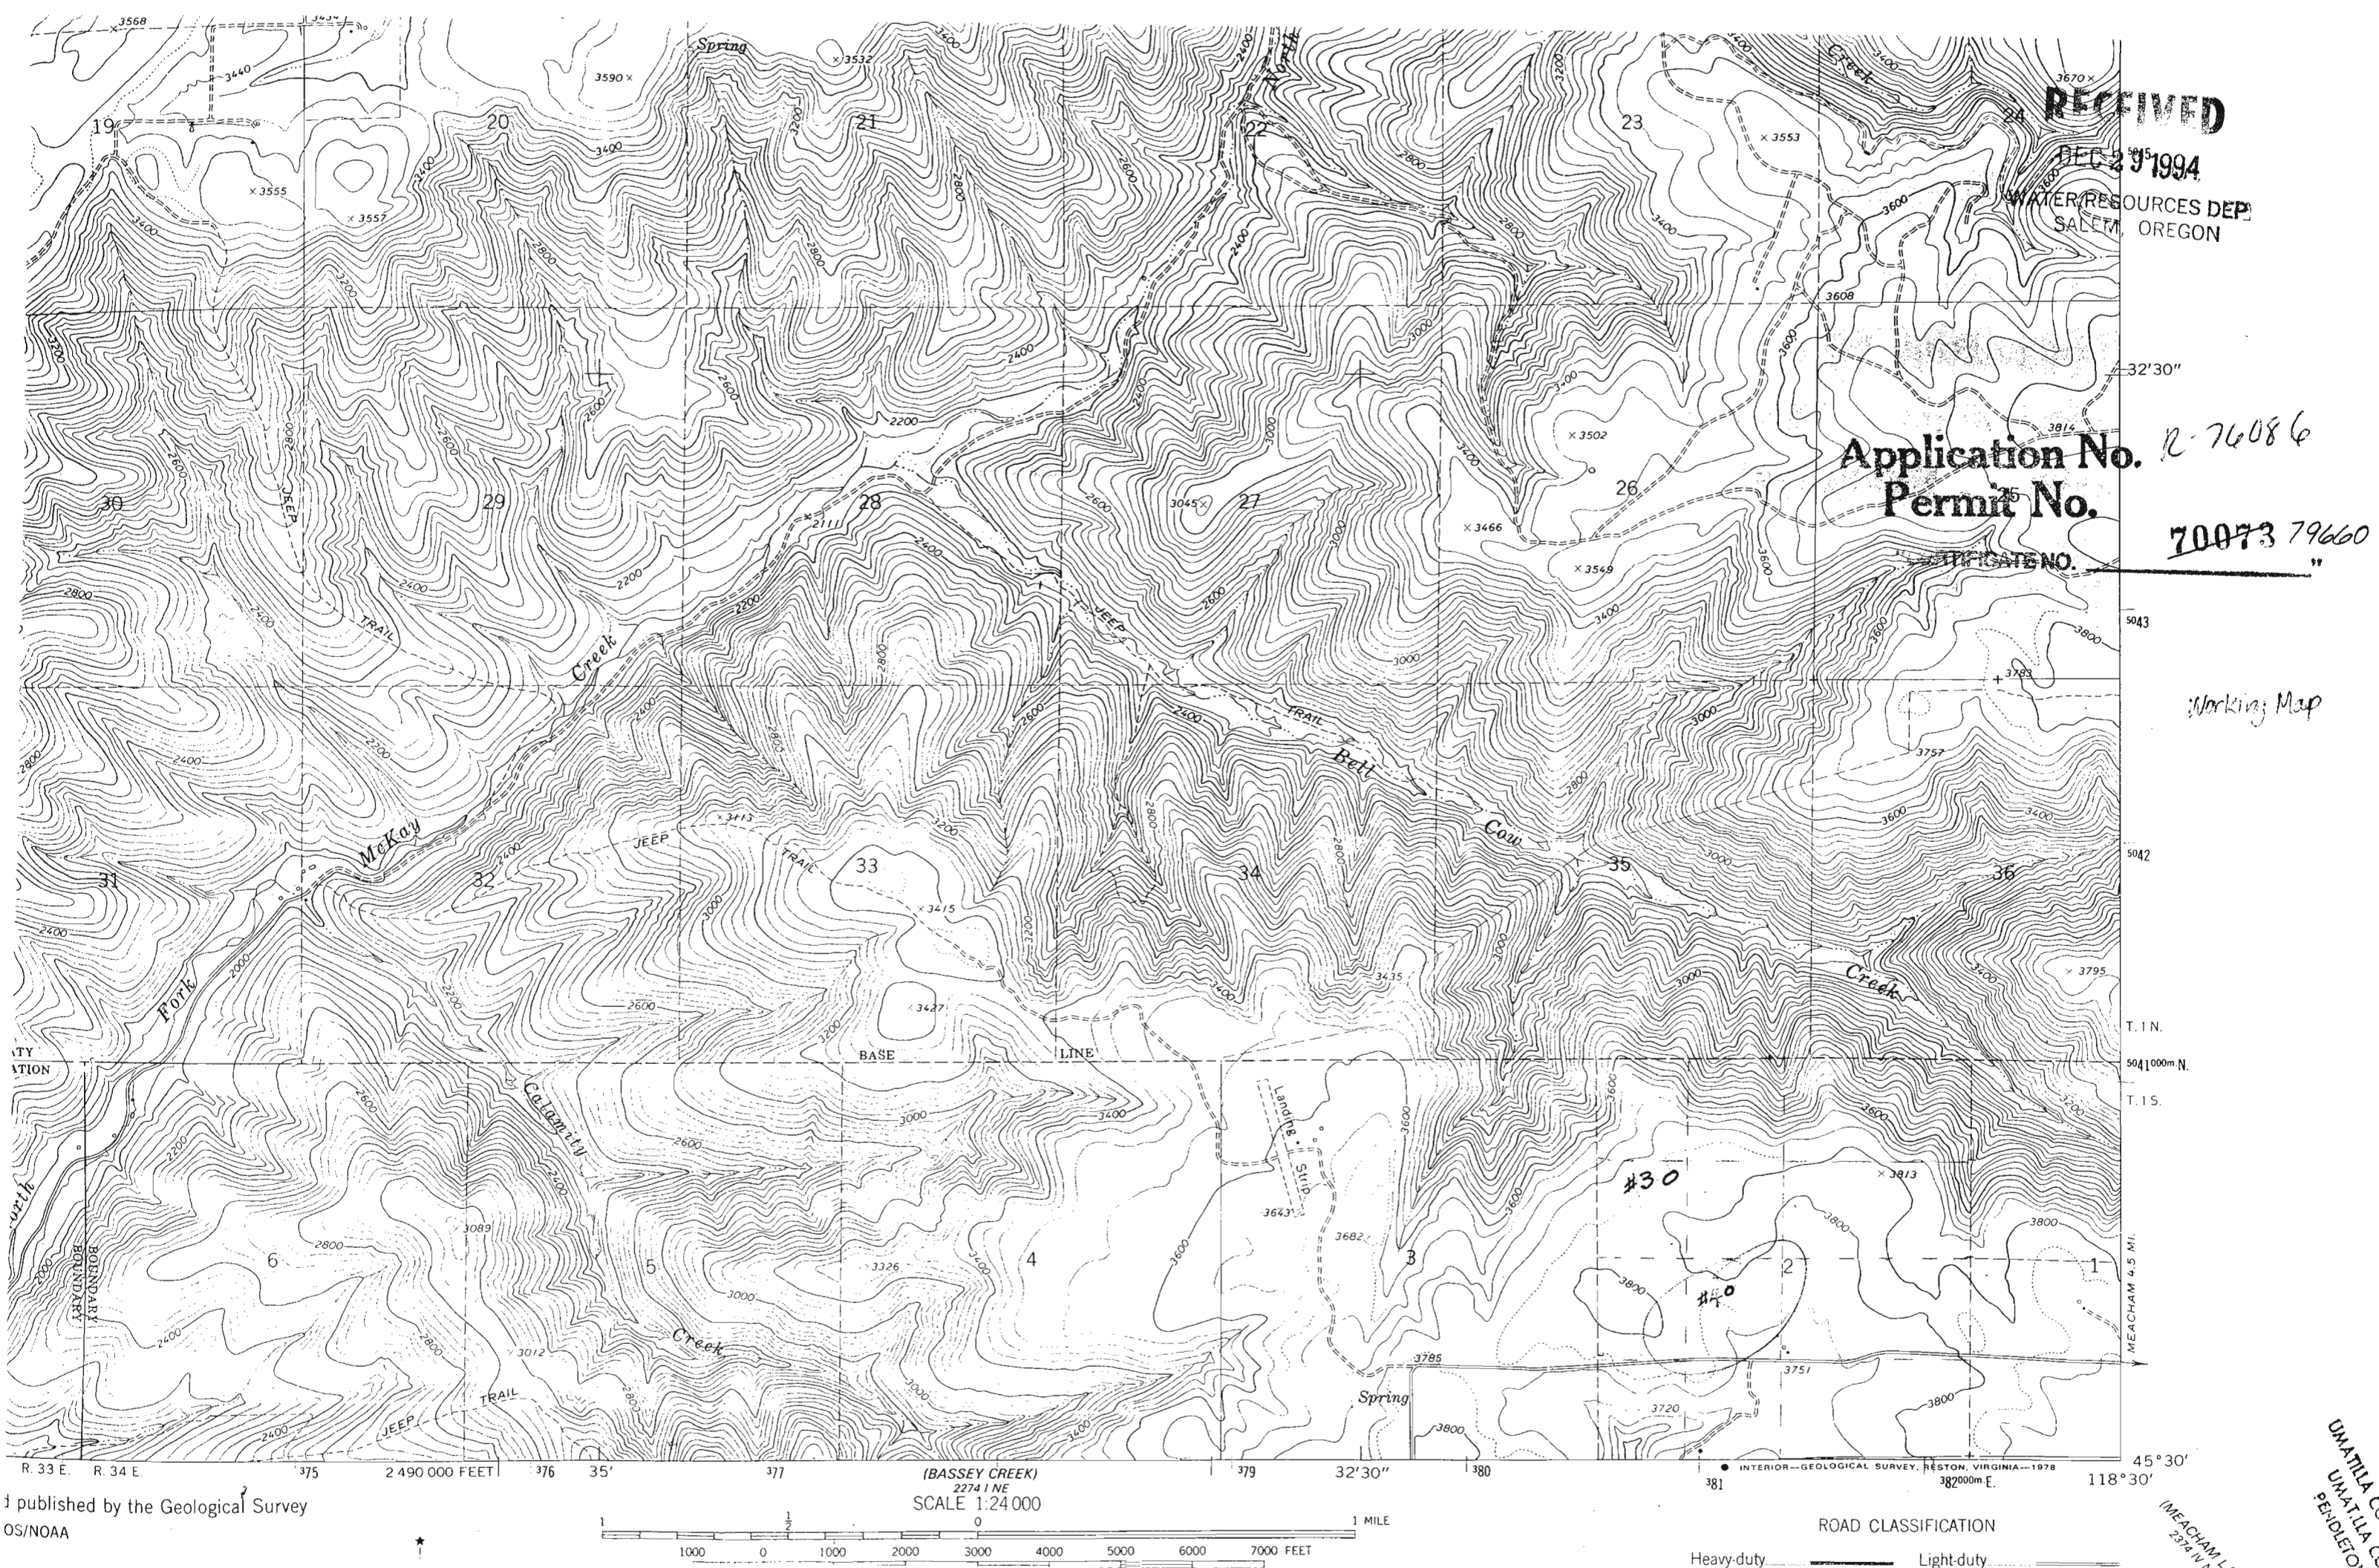

Published by the Geological Survey
OS/NOAA

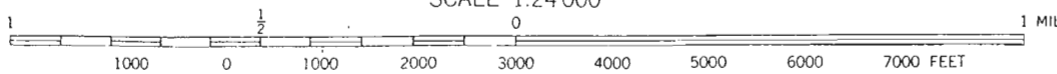

INTERIOR—GEOLOGICAL SURVEY, RESTON, VIRGINIA—1978
382000m E. 45° 30' 118° 30'

ROAD CLASSIFICATION

Heavy-duty Light-duty

UMATILA C
UMATILA C
PENDLETO