

5
T.34S. R.6W. W.M.

RECEIVED


NOV 24 1976

WM. DIST. 14
GRANTS PASS, ORE.

RECEIVED

DEC 29 1994

WATER RESOURCES
SALEM, OREGON

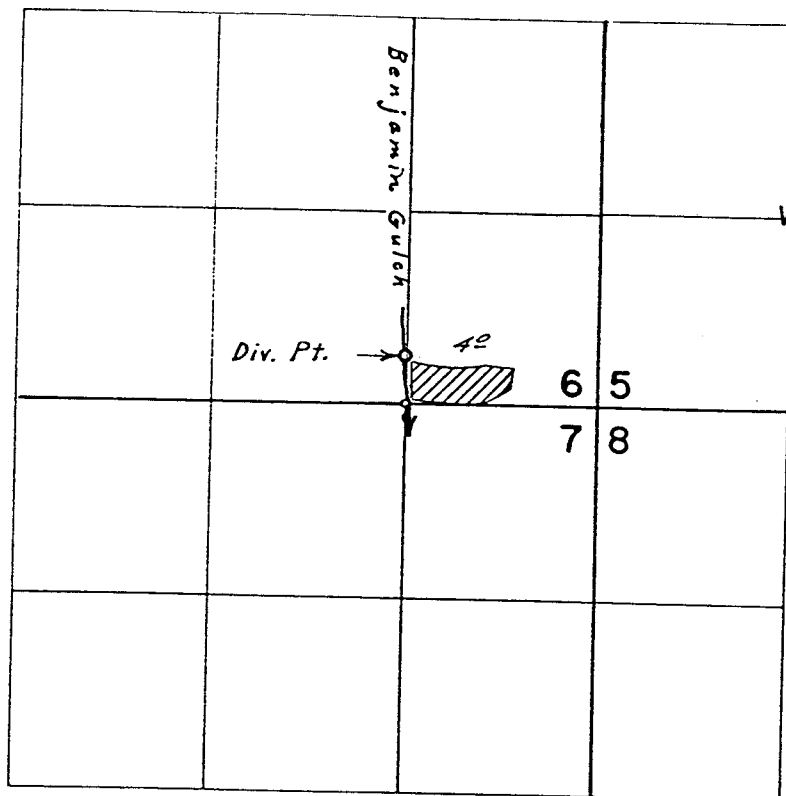

Div. Pt. located 330' N. & 10' W. from S.W. Cor. S.E. $\frac{1}{4}$ S.E. $\frac{1}{4}$ Sec. 6

"CERTIFICATE NO. 70074"

Application No. 2076087

Permit No.

FINAL PROOF SURVEY

UNDER

Application No. Transfer No. H-187
Permit No.

IN NAME OF

LLOYD L. & PHYLLIS E. HACKER

Surveyed April 20, 1974, by L. E. Gould

RECEIVED


DEC 29 1994

WATER RESOURCES DIVISION
SALEM, OREGON

Application No. R-76087
Permit No.

"CERTIFICATE NO.

70074

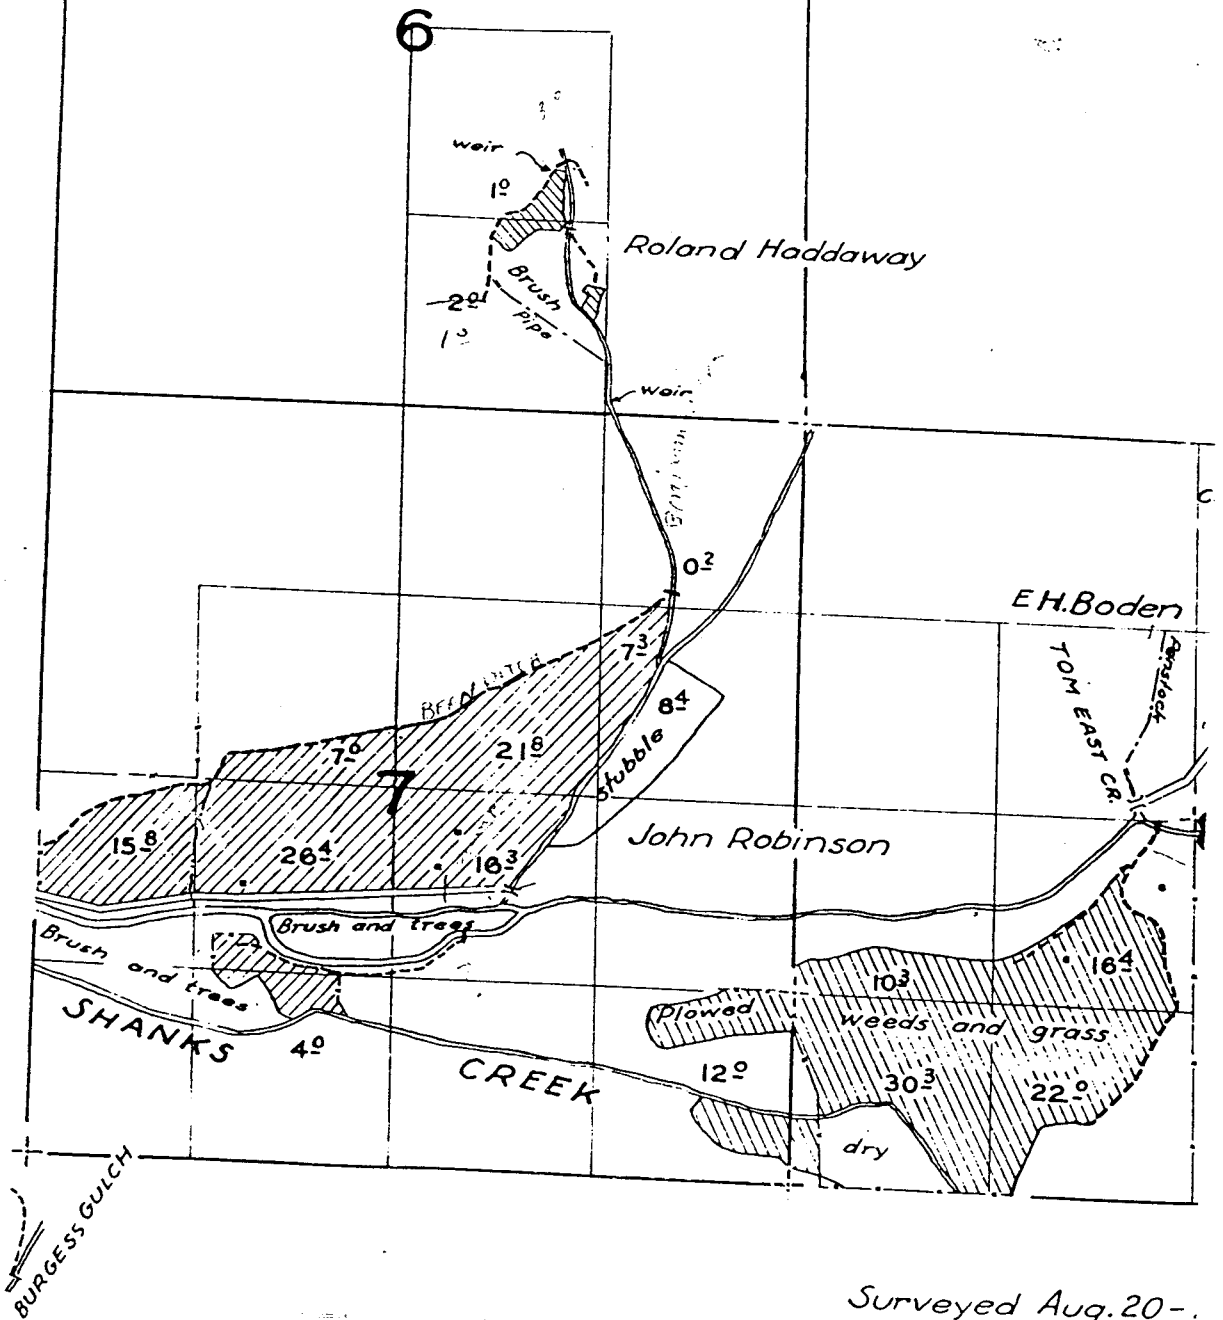

Include Map.

Surveyed Aug. 20-