

SECTION 28 T.24S. R.4W. W.M.
DOUGLAS COUNTY


1"=400'

SEE MAP 24 4 21

DEC 2 8 1994
WATER RESOURCES DEPT.
SALEM, OREGON

"CERTIFICATE NO. 70075"

THIS MAP WAS PREPARED FOR
ASSESSMENT PURPOSE ONLY.

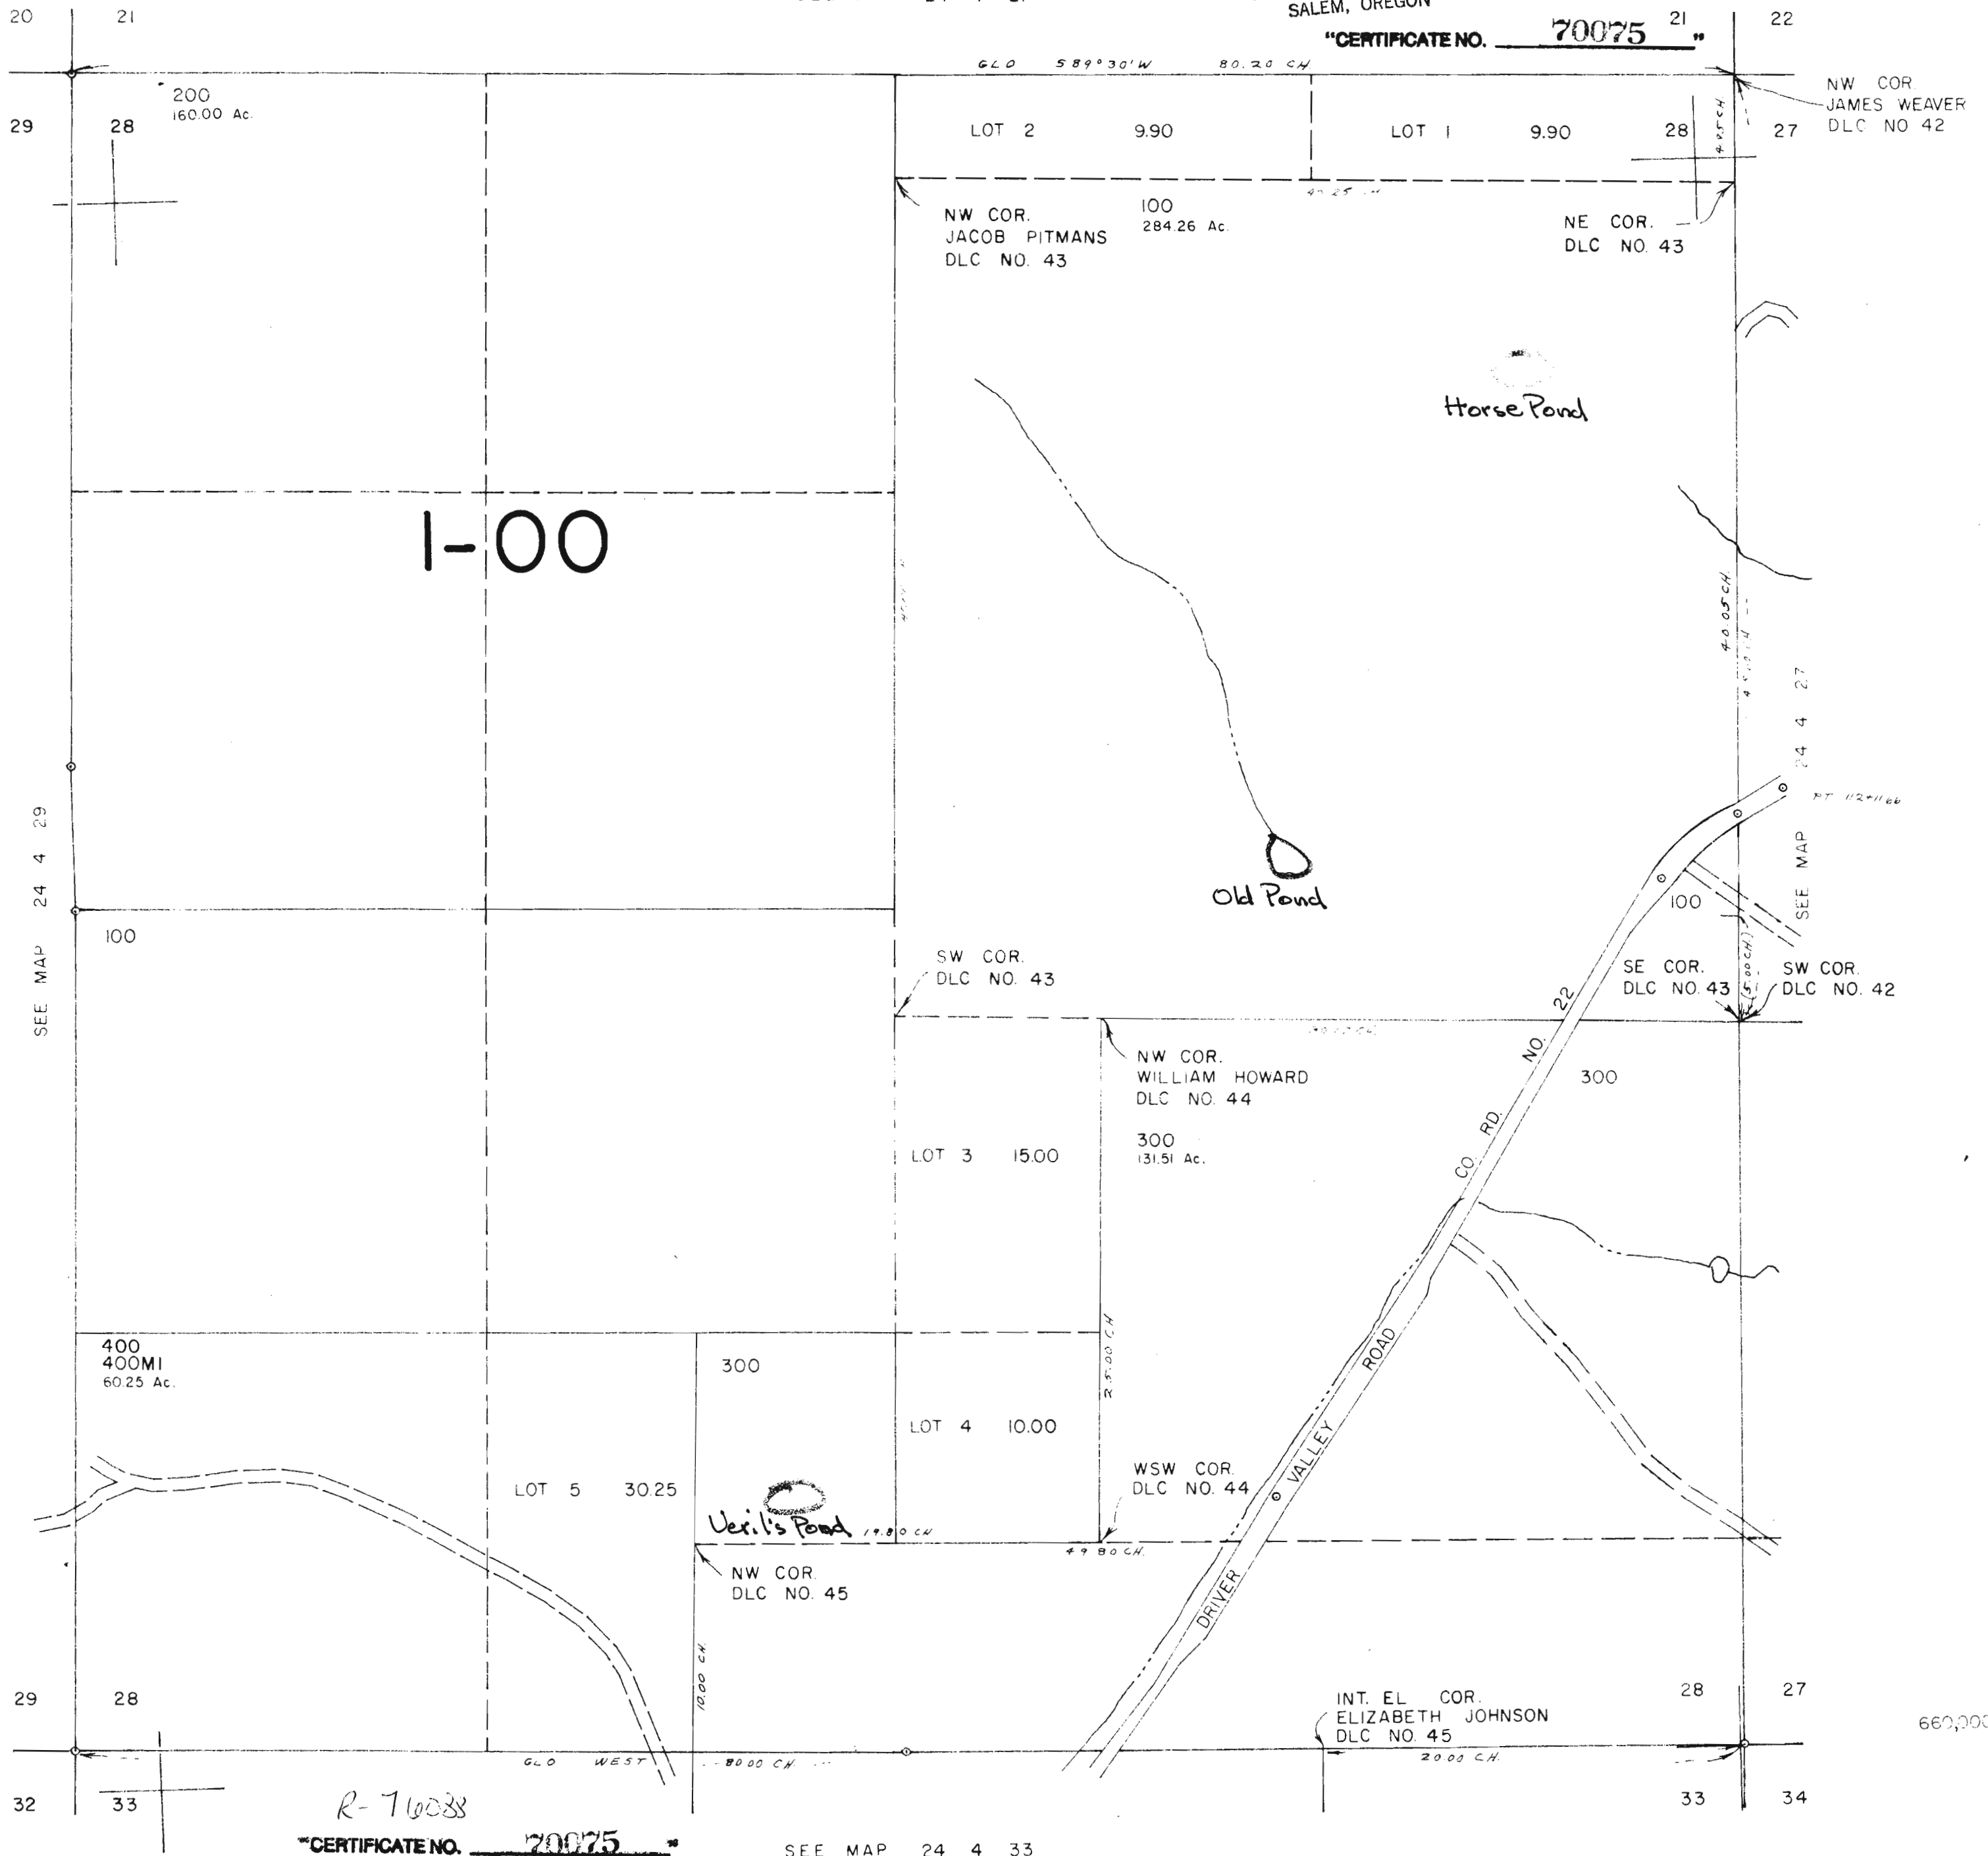


THIS MAP WAS PREPARED FOR
ASSESSMENT PURPOSE ONLY.

SECTION 33 T.24S. R.4W. W.M.
DOUGLAS COUNTY

1"=400'

Application No. R-76088
REVISED ON
7-19-94 Permit No.

24 4

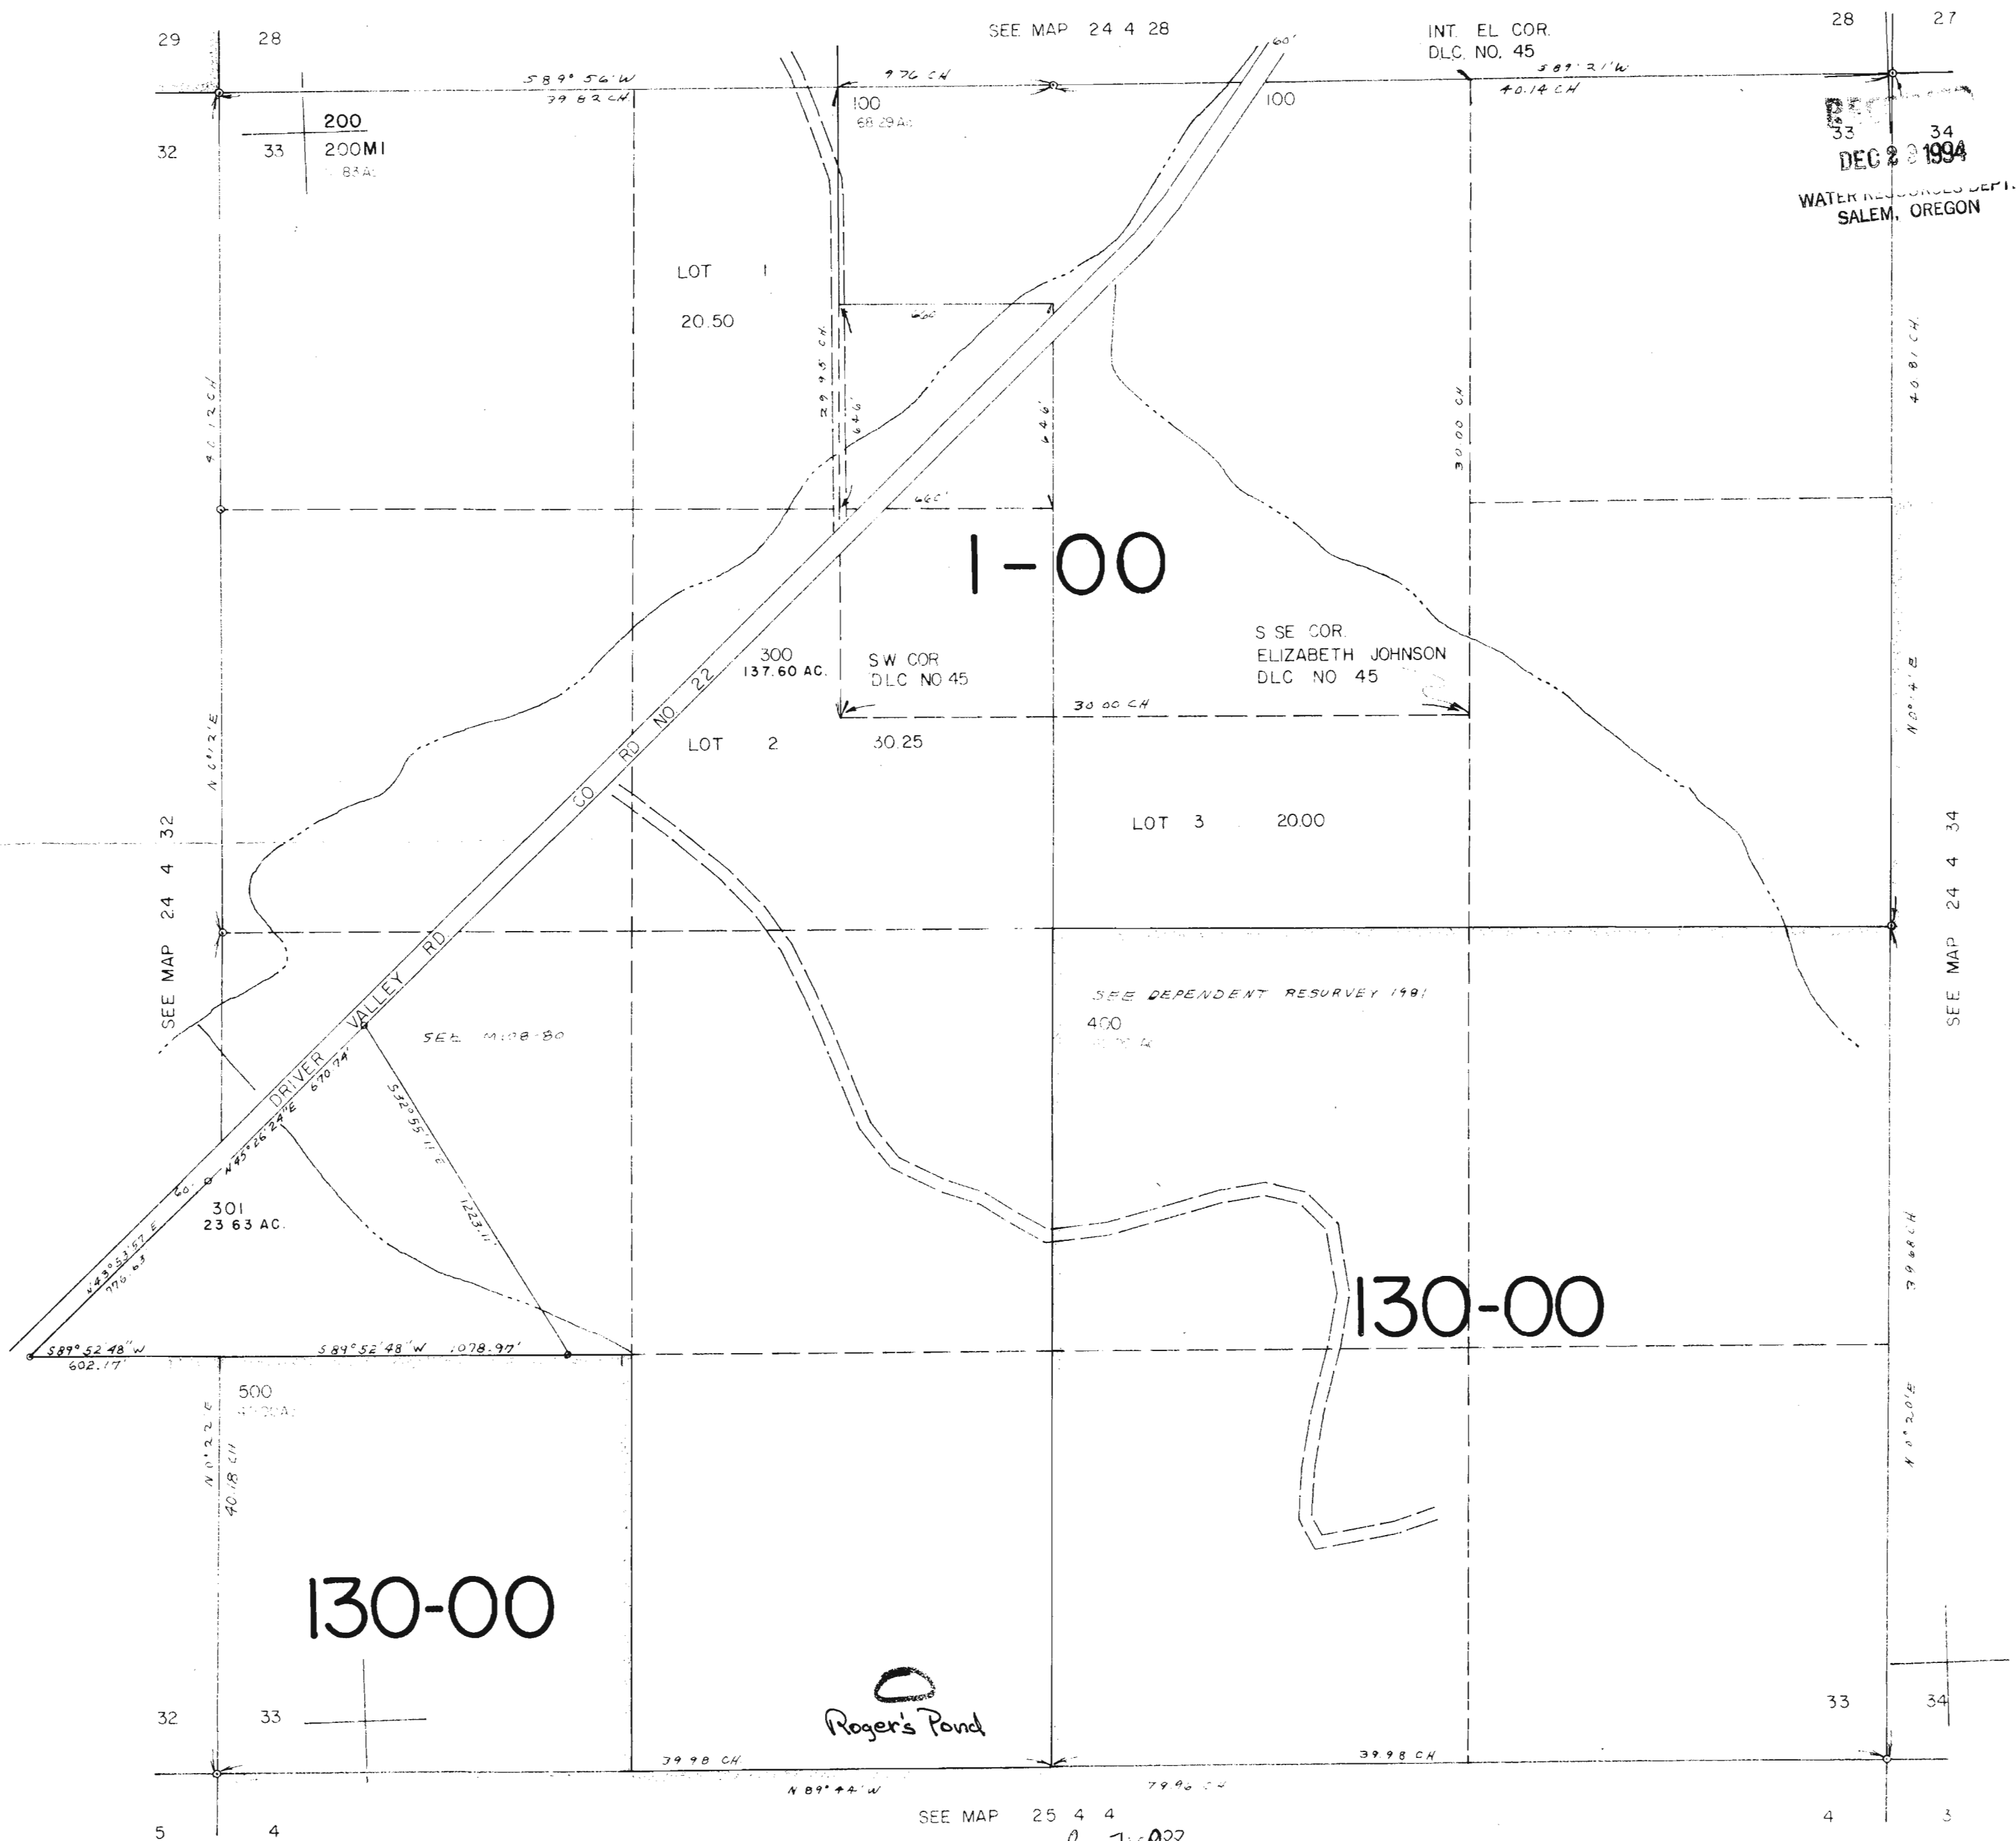

SECTION 27 T.24S. R.4W. W.M.
DOUGLAS COUNTY

1"=400'

THIS MAP WAS PREPARED FOR
ASSESSMENT PURPOSE ONLY.

SEE MAP 24 4 22

REC
DEC 23 1994
WATER RESOURCES DEPT.
SALEM, OREGON

