

REVISÉ EN
7-19-94

DEC - 9 1994

WATER RESOU
SALEM, OREGON

1"-400"


DEC 29 1994

WATER RESOURCES DEPT.
SALEM, OREGON

3 MAP WAS PREPARED FOR
ASSESSMENT PURPOSE ONLY.

"CERTIFICATE NO. 70076"

SEE MAP 24 4 21

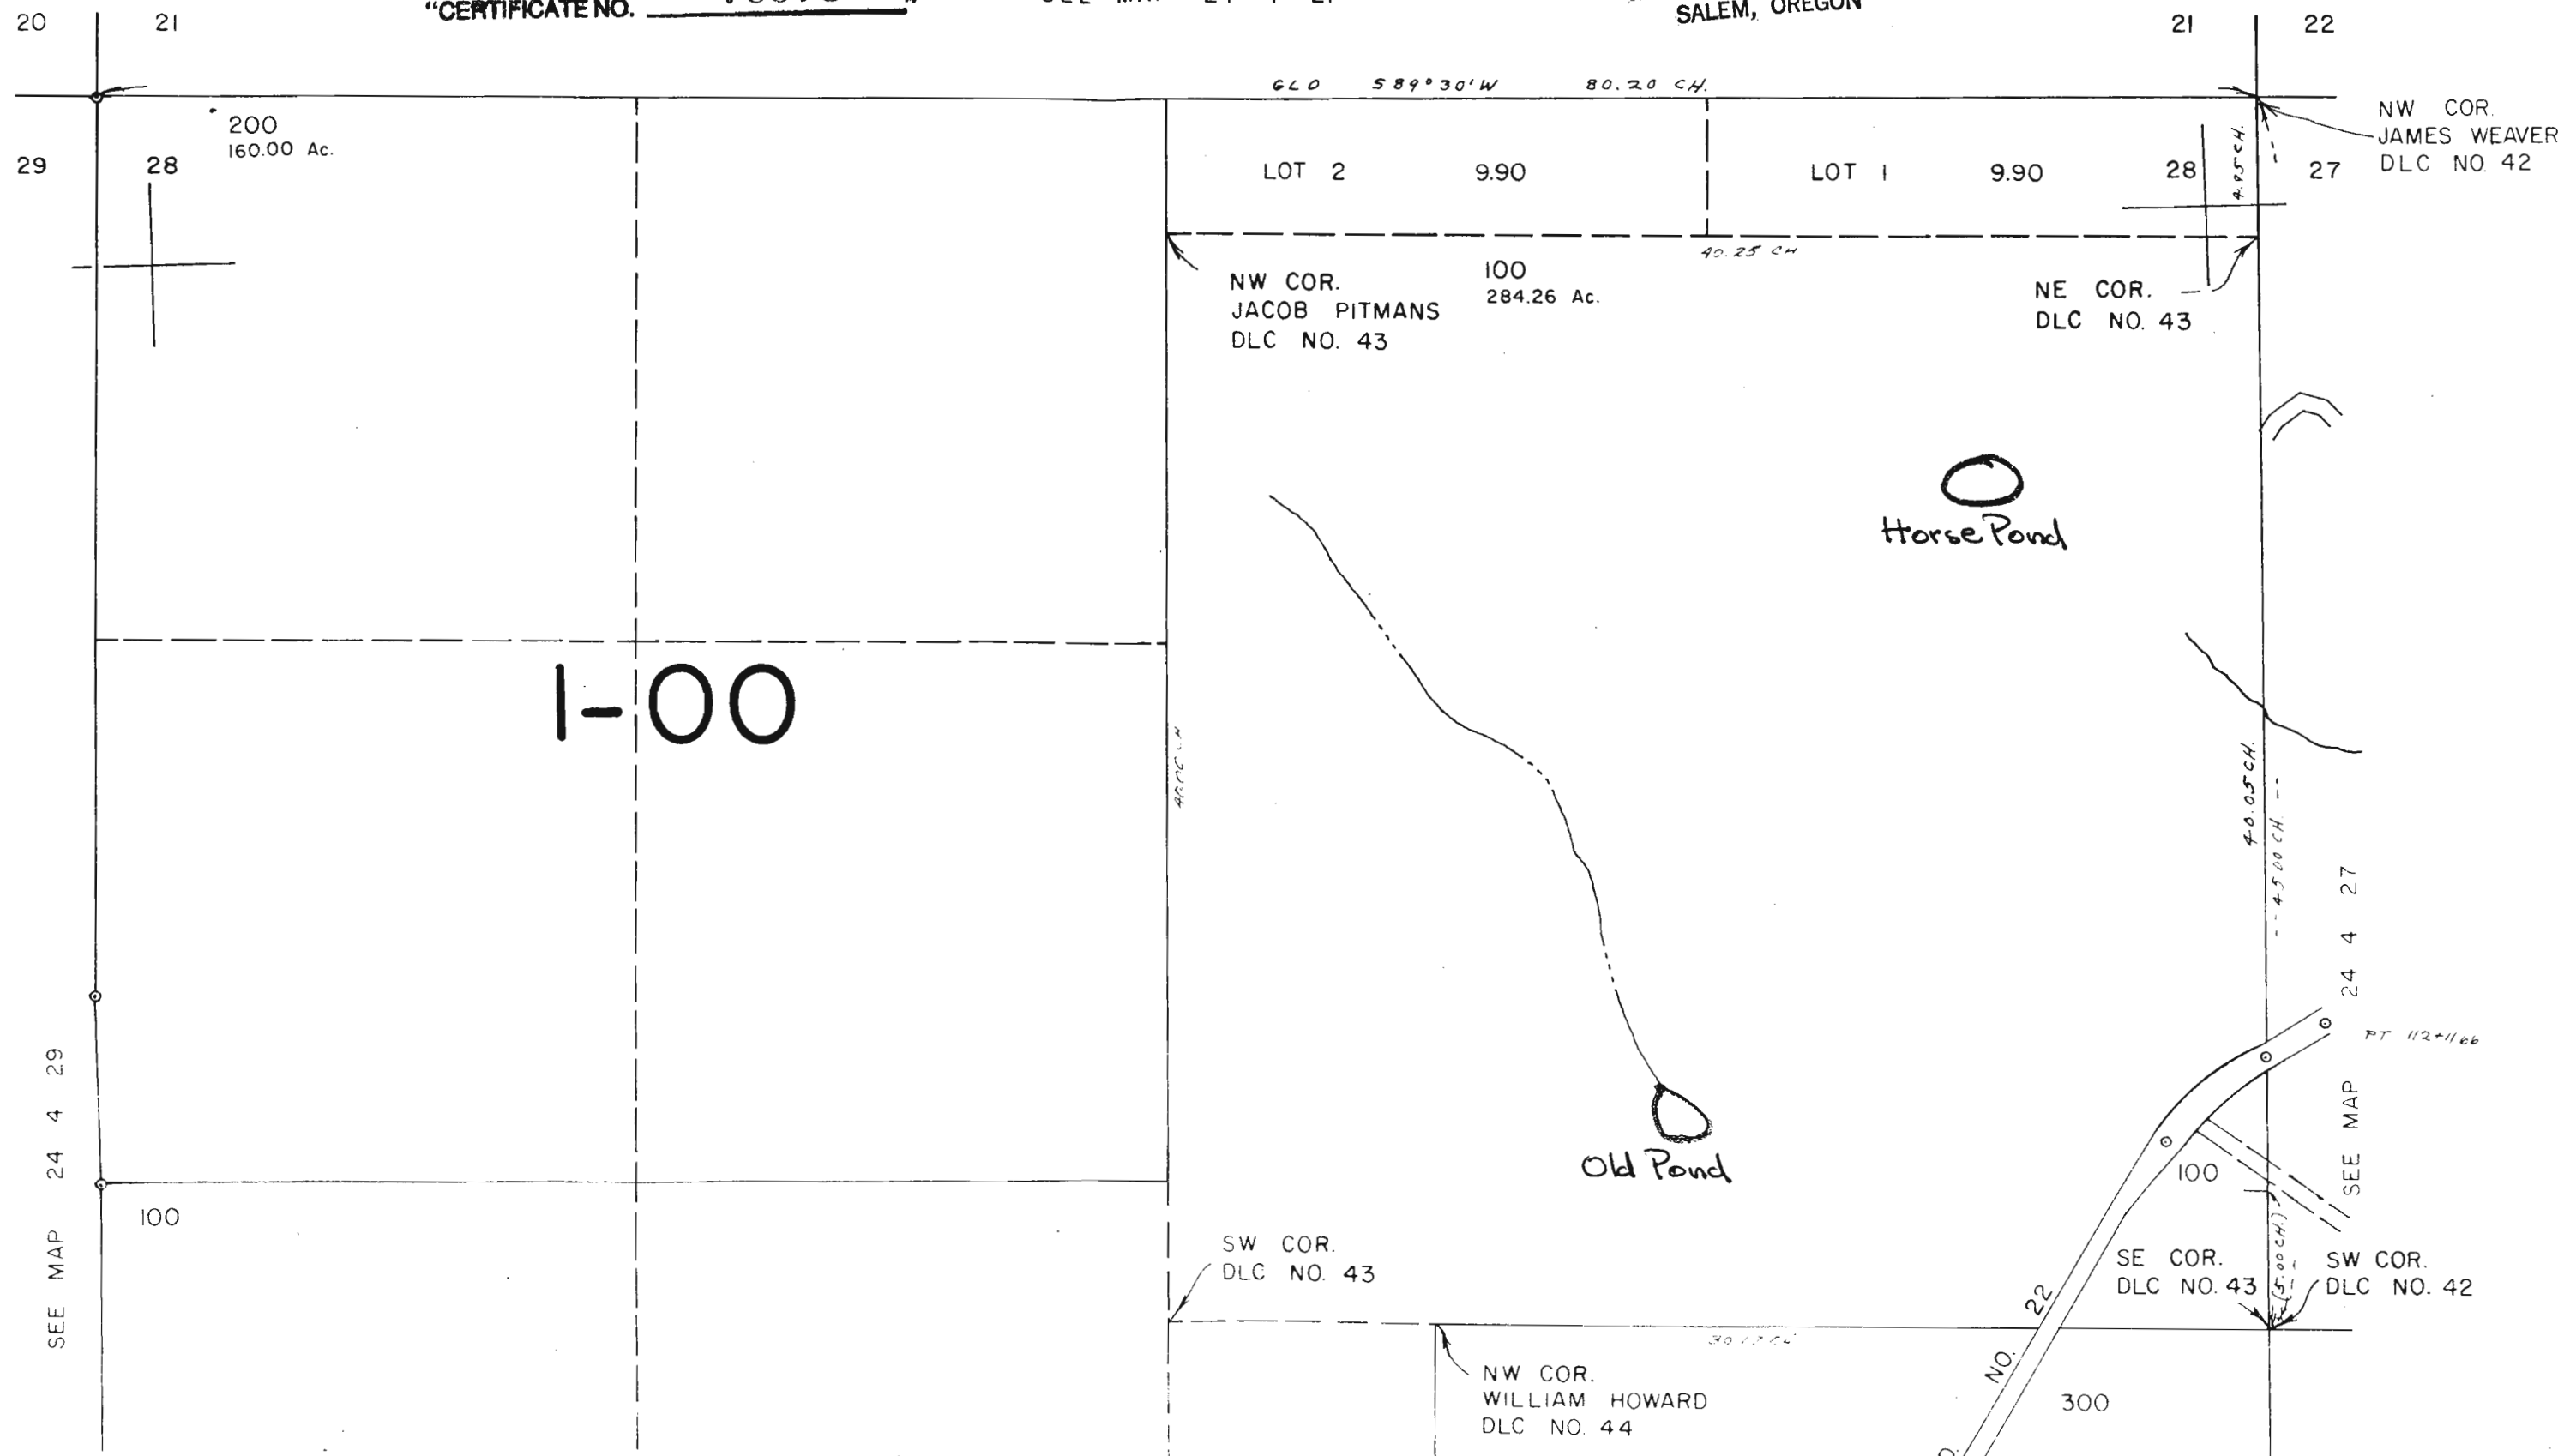

SEE MAP

Application No. *R-76089*
Permit No.

SW COR.
DLC NO. 43

SE COR.
DLC NO. 43

SW COR.
DLC NO. 42

NW COR.
WILLIAM HOWARD
DLC NO. 44

300
131.51 Ac.

LOT 3 15.00

LOT 4 10.00

LOT 5 30.25

400
400MI
60.25 Ac.

Veri's Pond

NW COR.
DLC NO. 45

WSW COR.
DLC NO. 44

INT. EL COR.
ELIZABETH JOHNSON
DLC NO. 45

SEE MAP 24 4 33

"CERTIFICATE NO. 70076"

292,000

SECTION 33 T.24S. R.4W. W.M.
DOUGLAS COUNTY

REVISED ON
7-19-94

24 4


THIS MAP WAS PREPARED FOR
ASSESSMENT PURPOSE ONLY.

1"=400'

Application No. *R-76089*
Permit No.

"CERTIFICATE NO. 70076"

DEC - 9 1994
WATER RESOURCES DEPT.
SALEM, OREGON

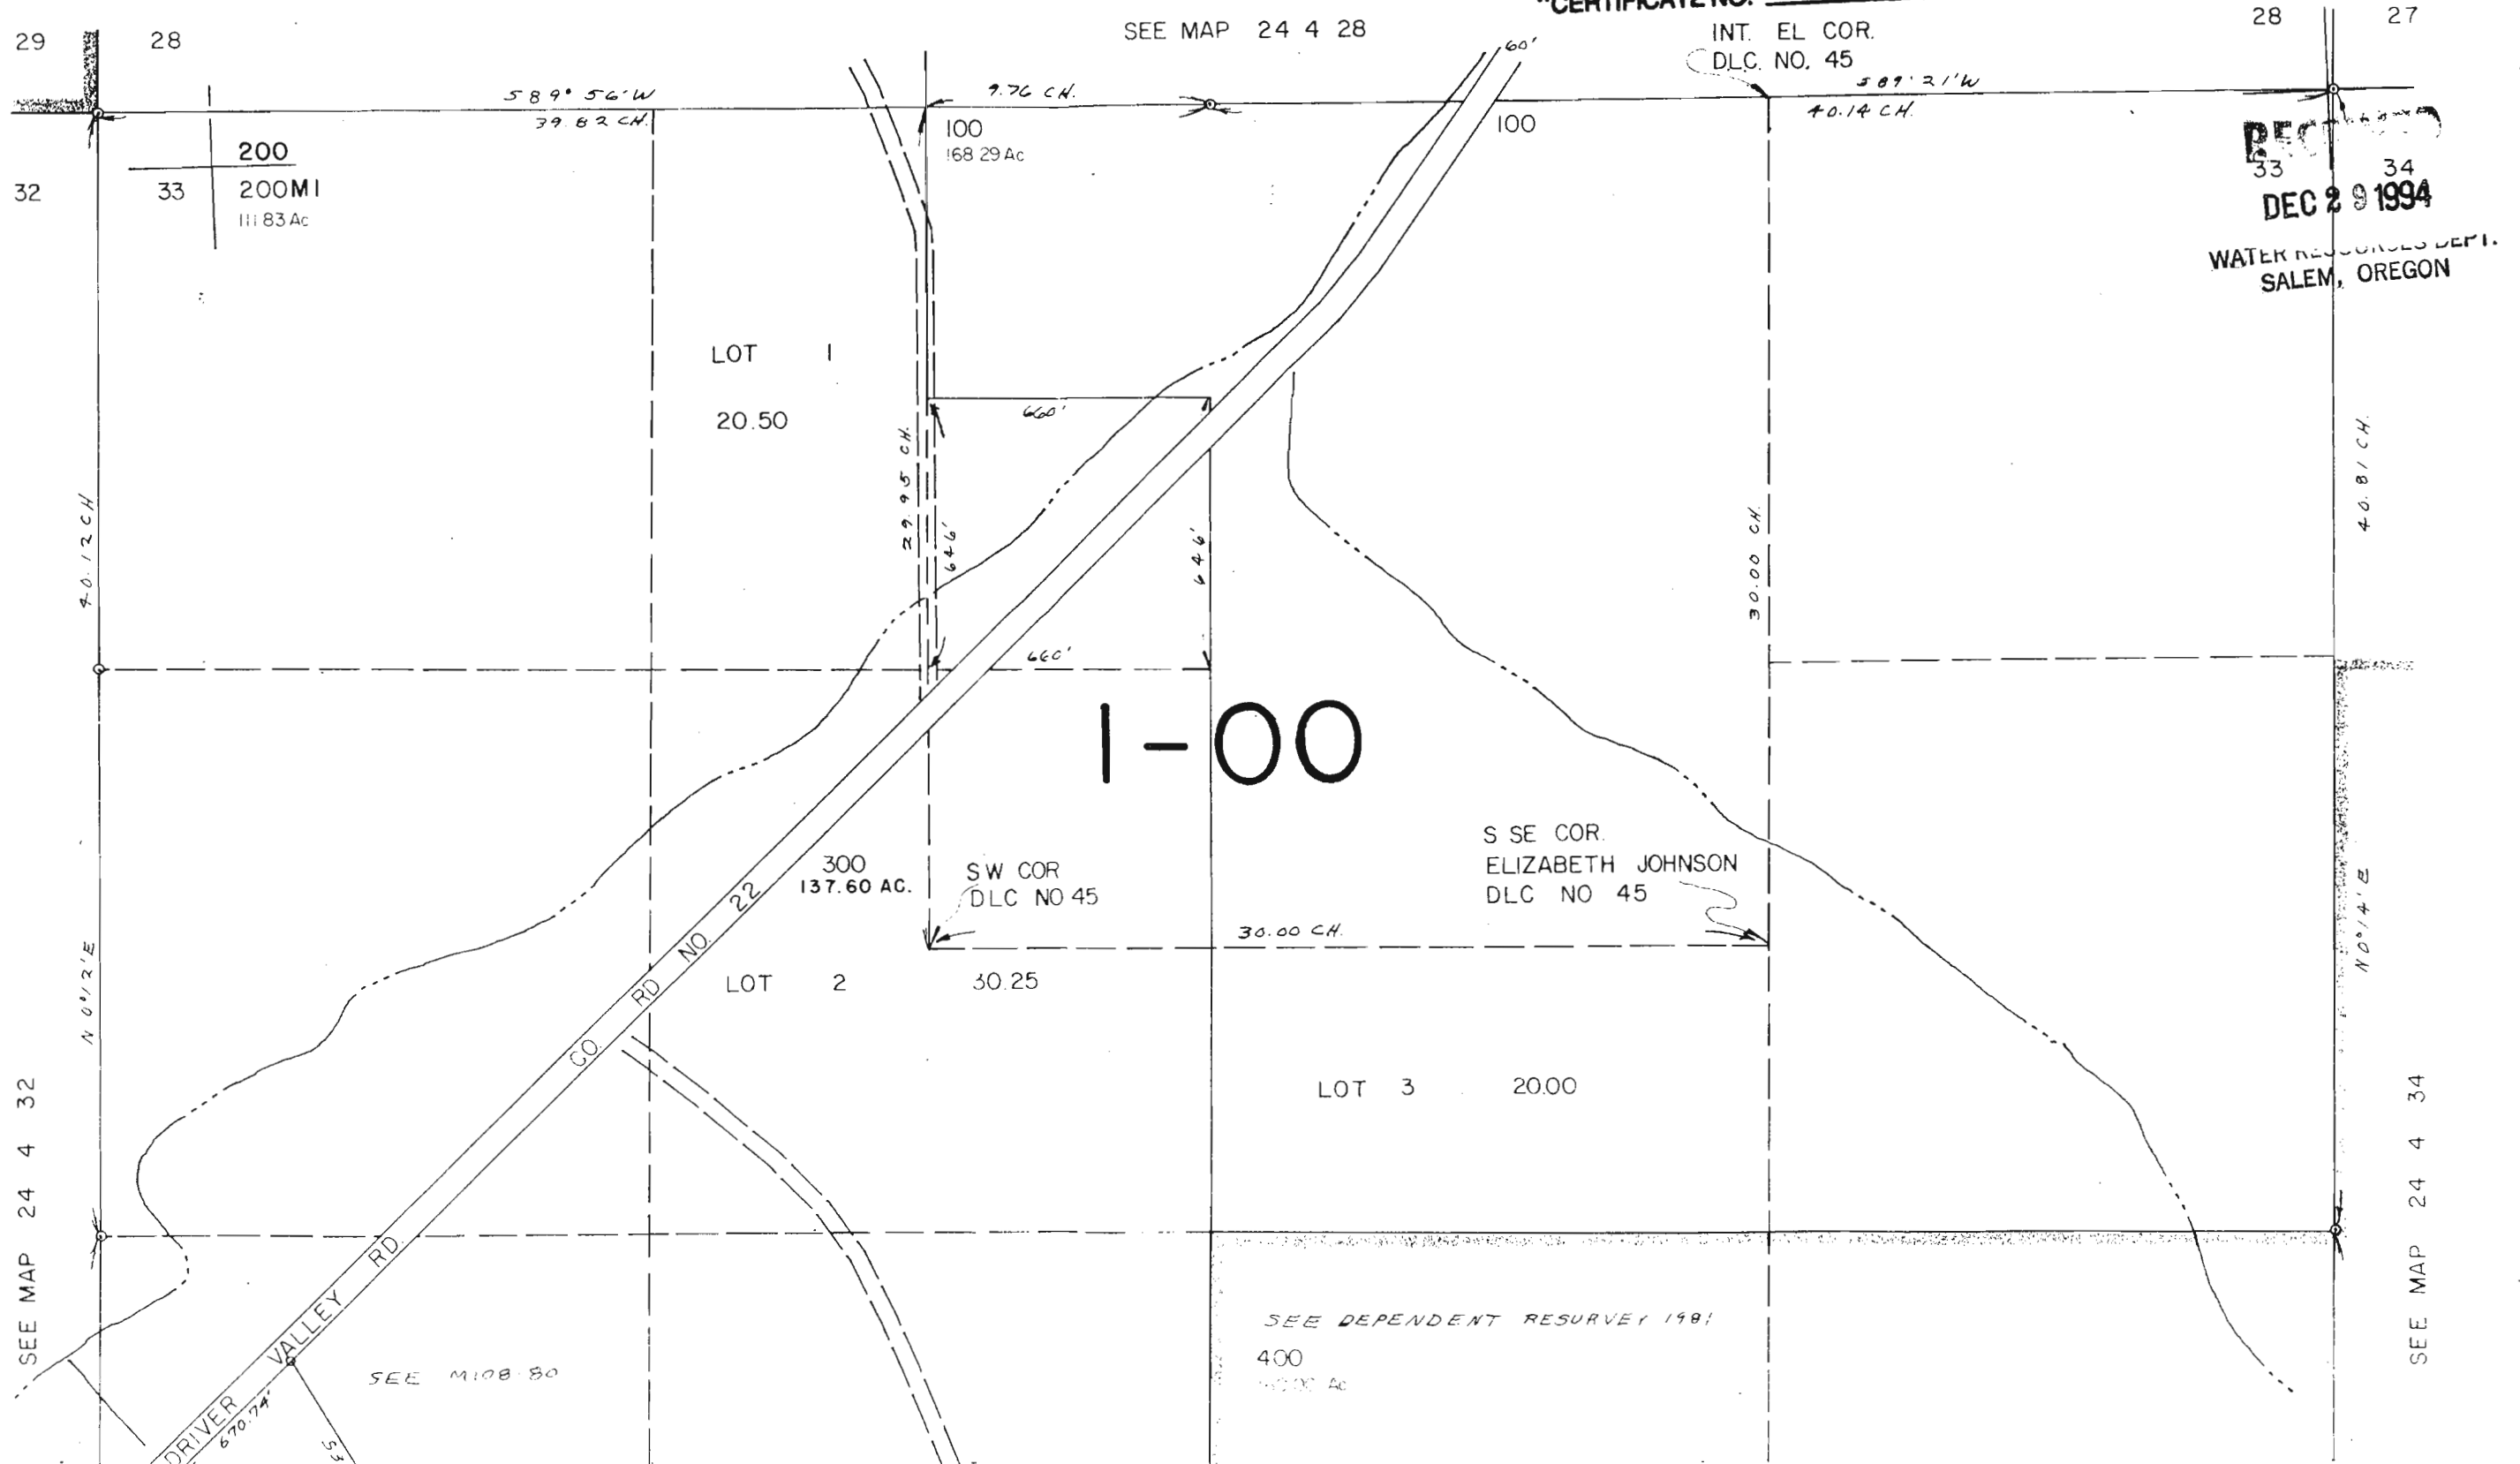

WAS PREPARED FOR
NT PURPOSE ONLY.

SECTION 27 T.24S. R.4W. W.M.
DOUGLAS COUNTY

1"=400'


Application No. *R-76089*
REVISID ON
4-11-94 Permit No.

24 4 27

"CERTIFICATE NO. 70076"

DEC 29 1994
WATER RESOURCES DEPT.
SALEM, OREGON


DEC - 9 1994
WATER RESOURCES DEPT.
SALEM, OREGON

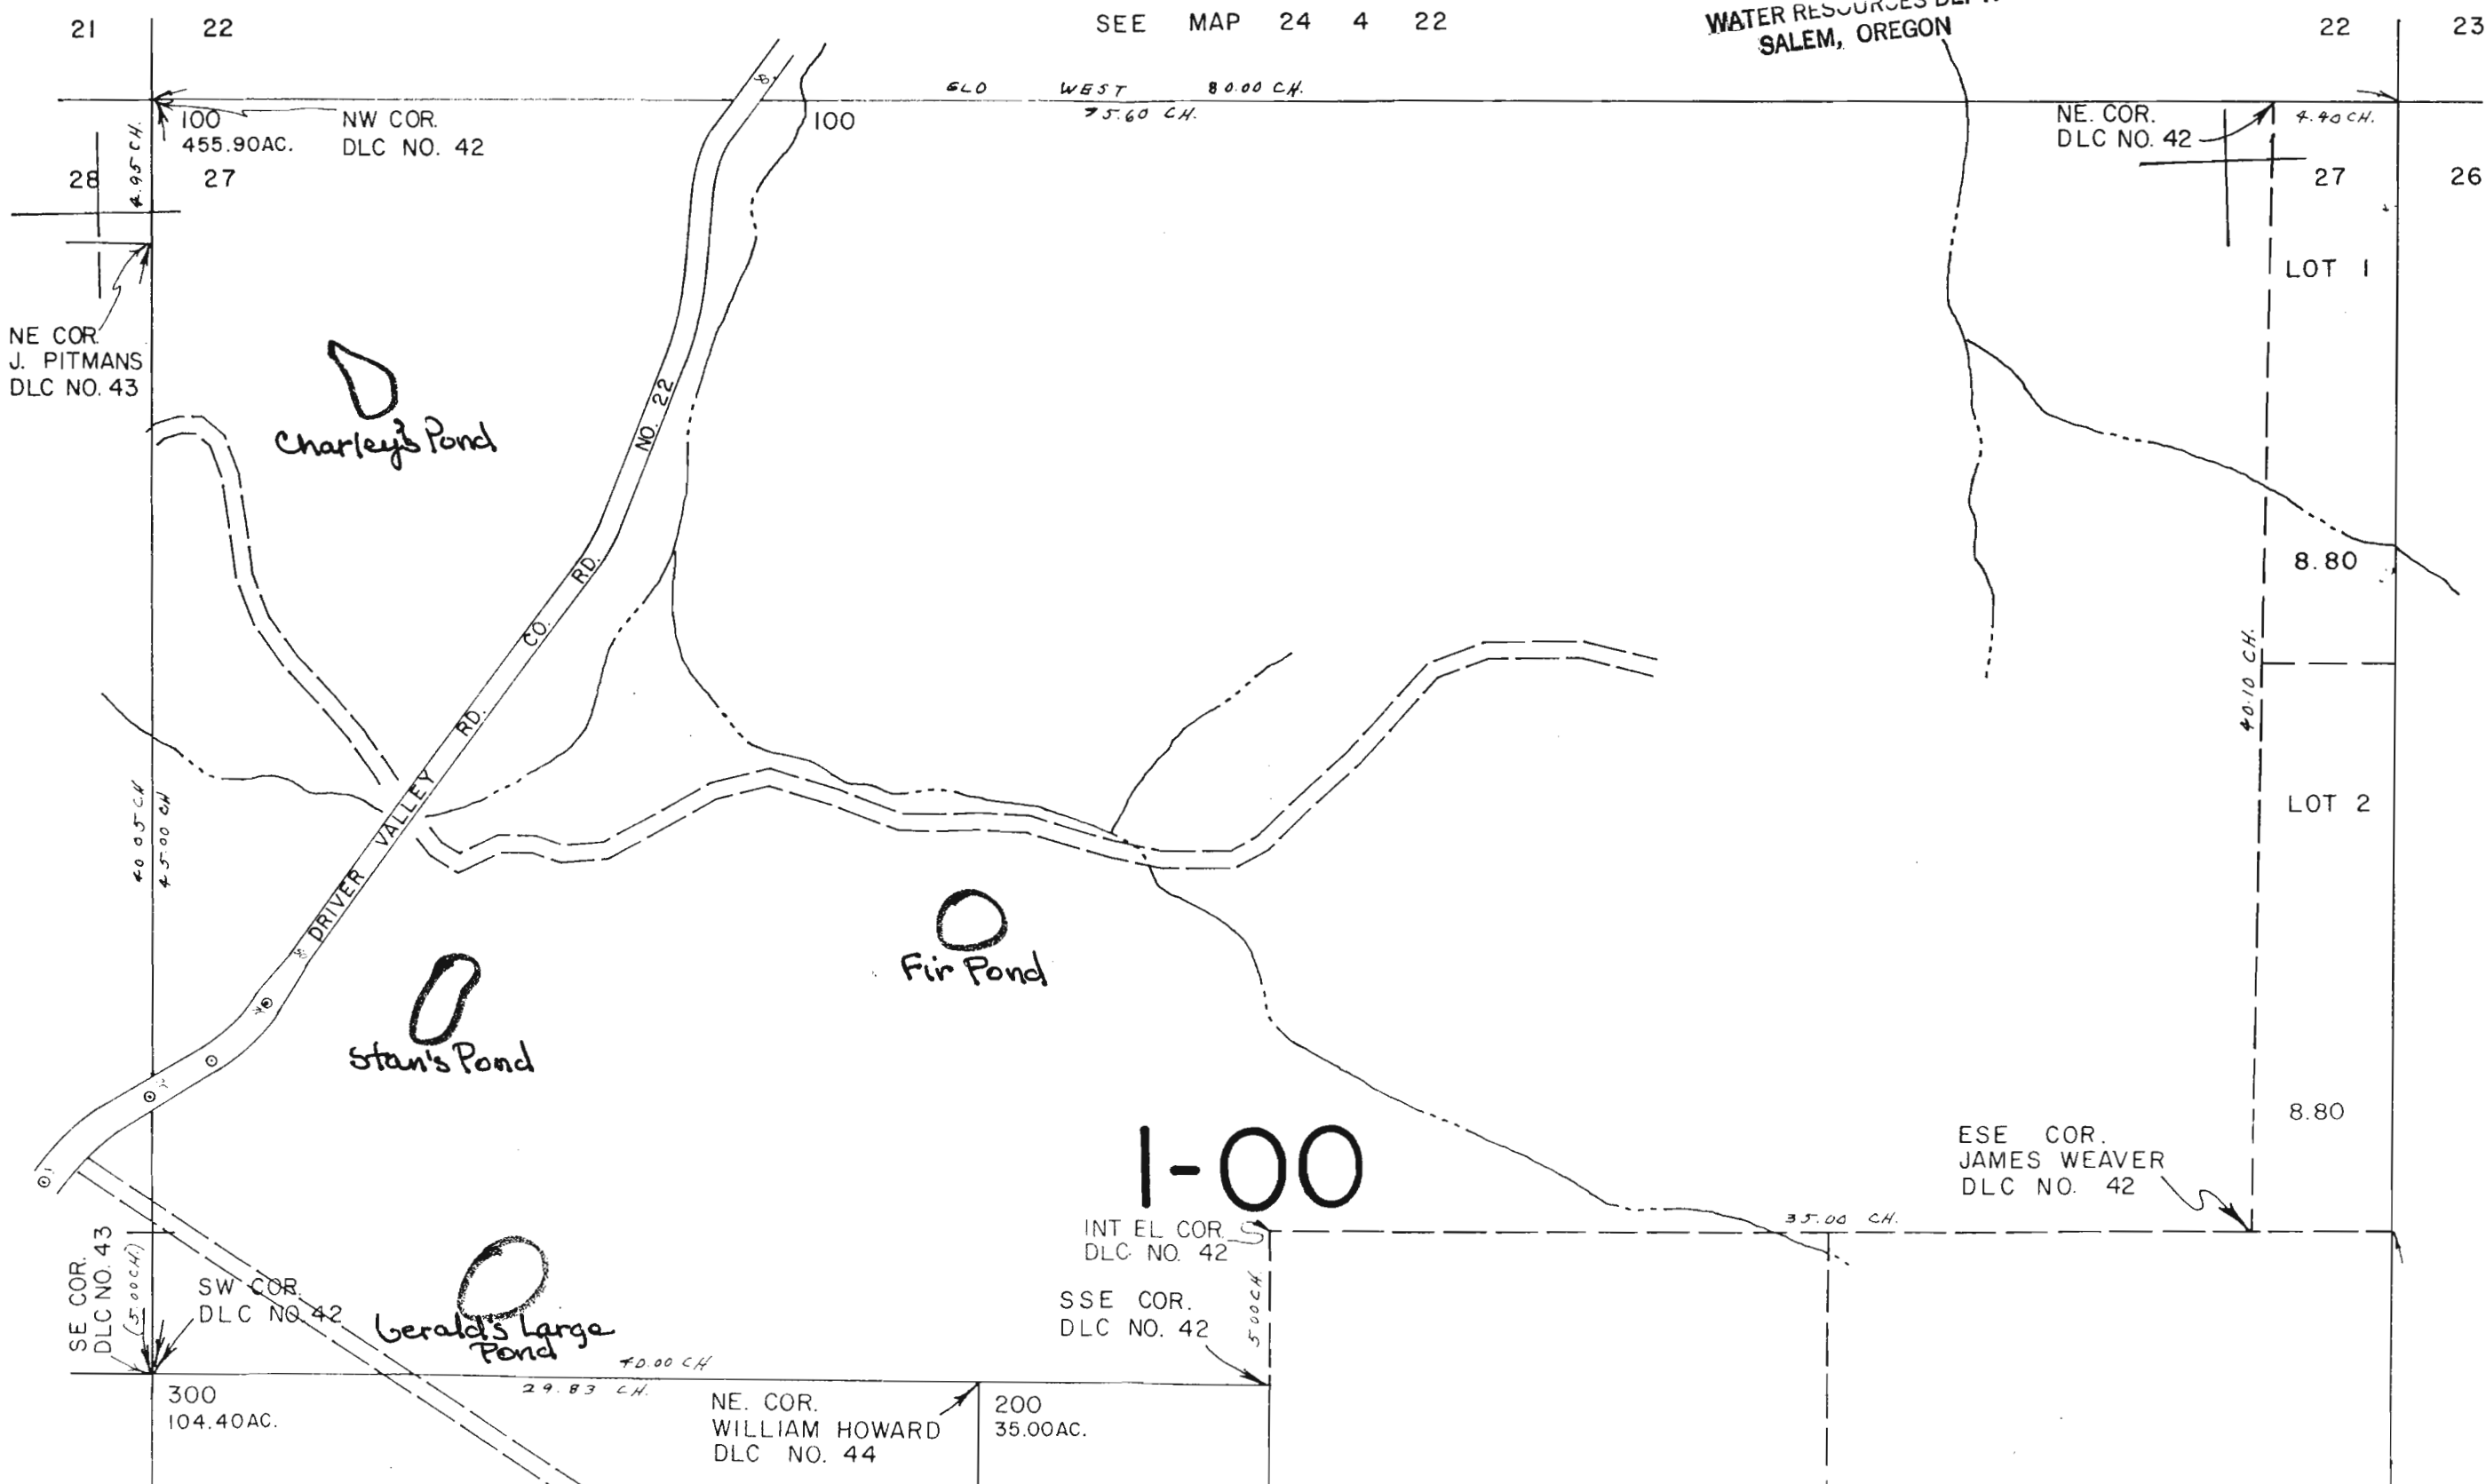

CANCELLED NO. S
400M2

SEE MAP 24 4 26

SEE MAP 24 4 28

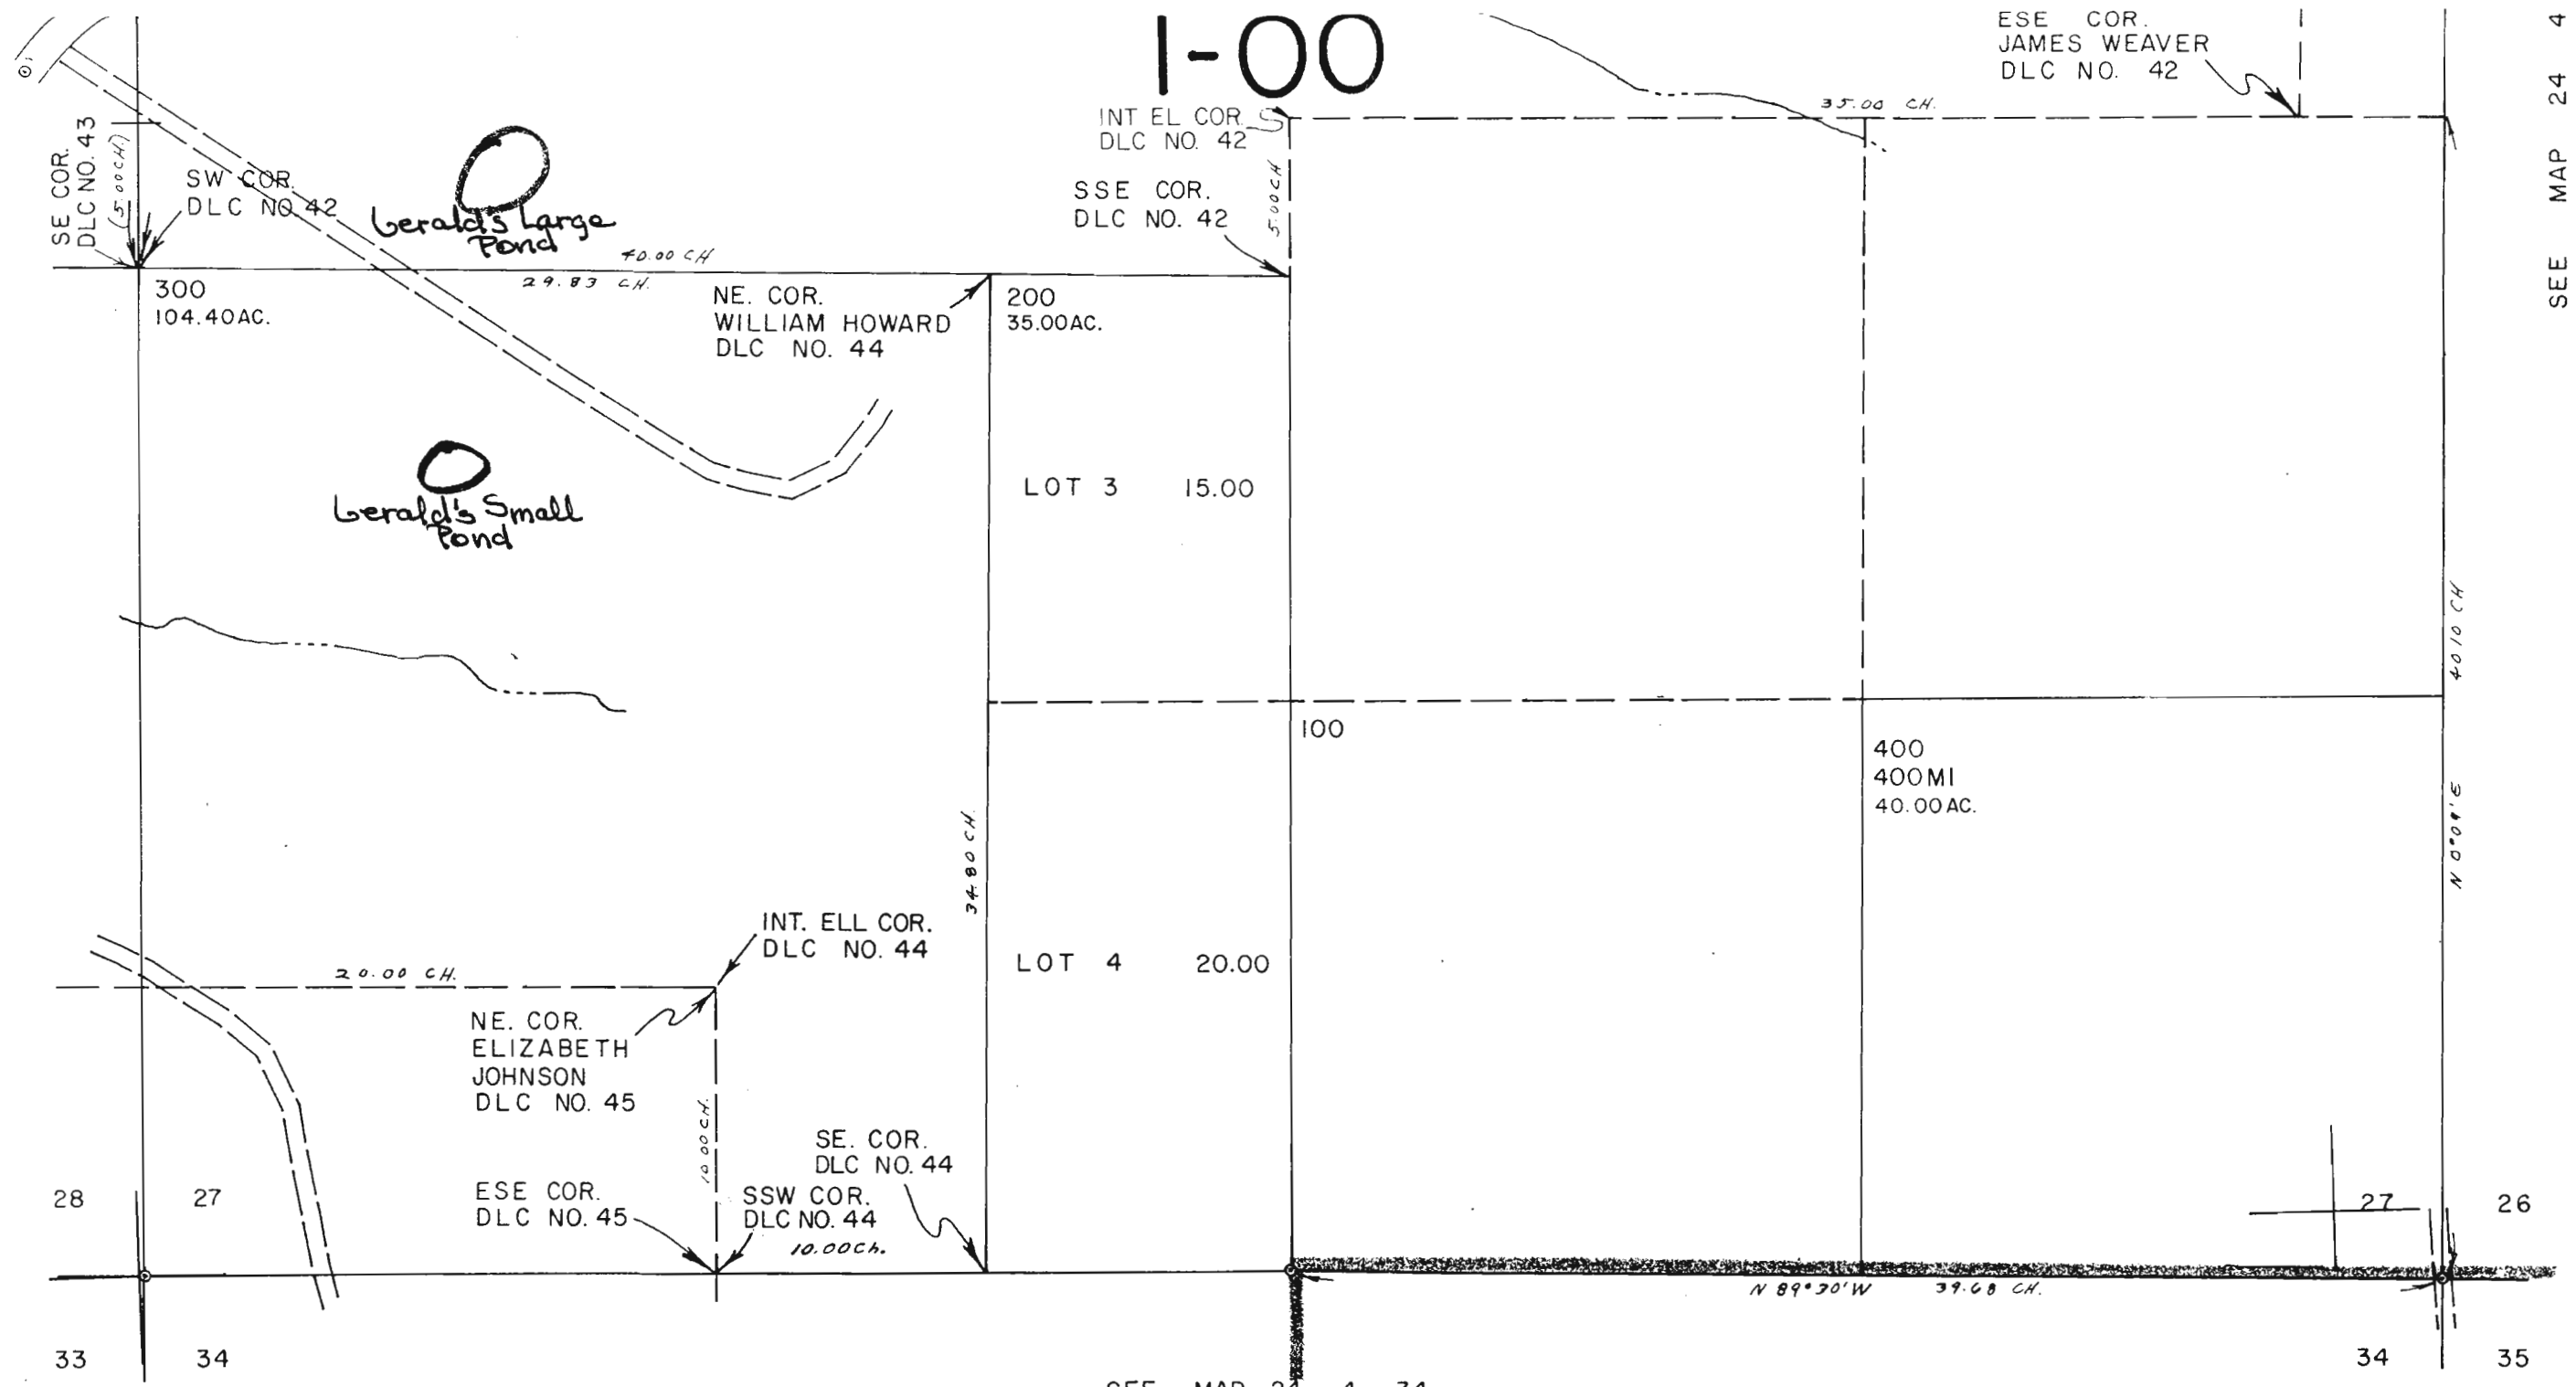

SEE MAP 24 4

SEE MAP 24 4 34