


Application No. *R-76091*
Permit No.


CERTIFICATE NO. 70078

DEC 23 1994

U.S. DEPARTMENT OF THE INTERIOR
BUREAU OF LAND MANAGEMENT

SALEM, OREGON
SHEAVILLE, OREGON
30 MINUTE SERIES

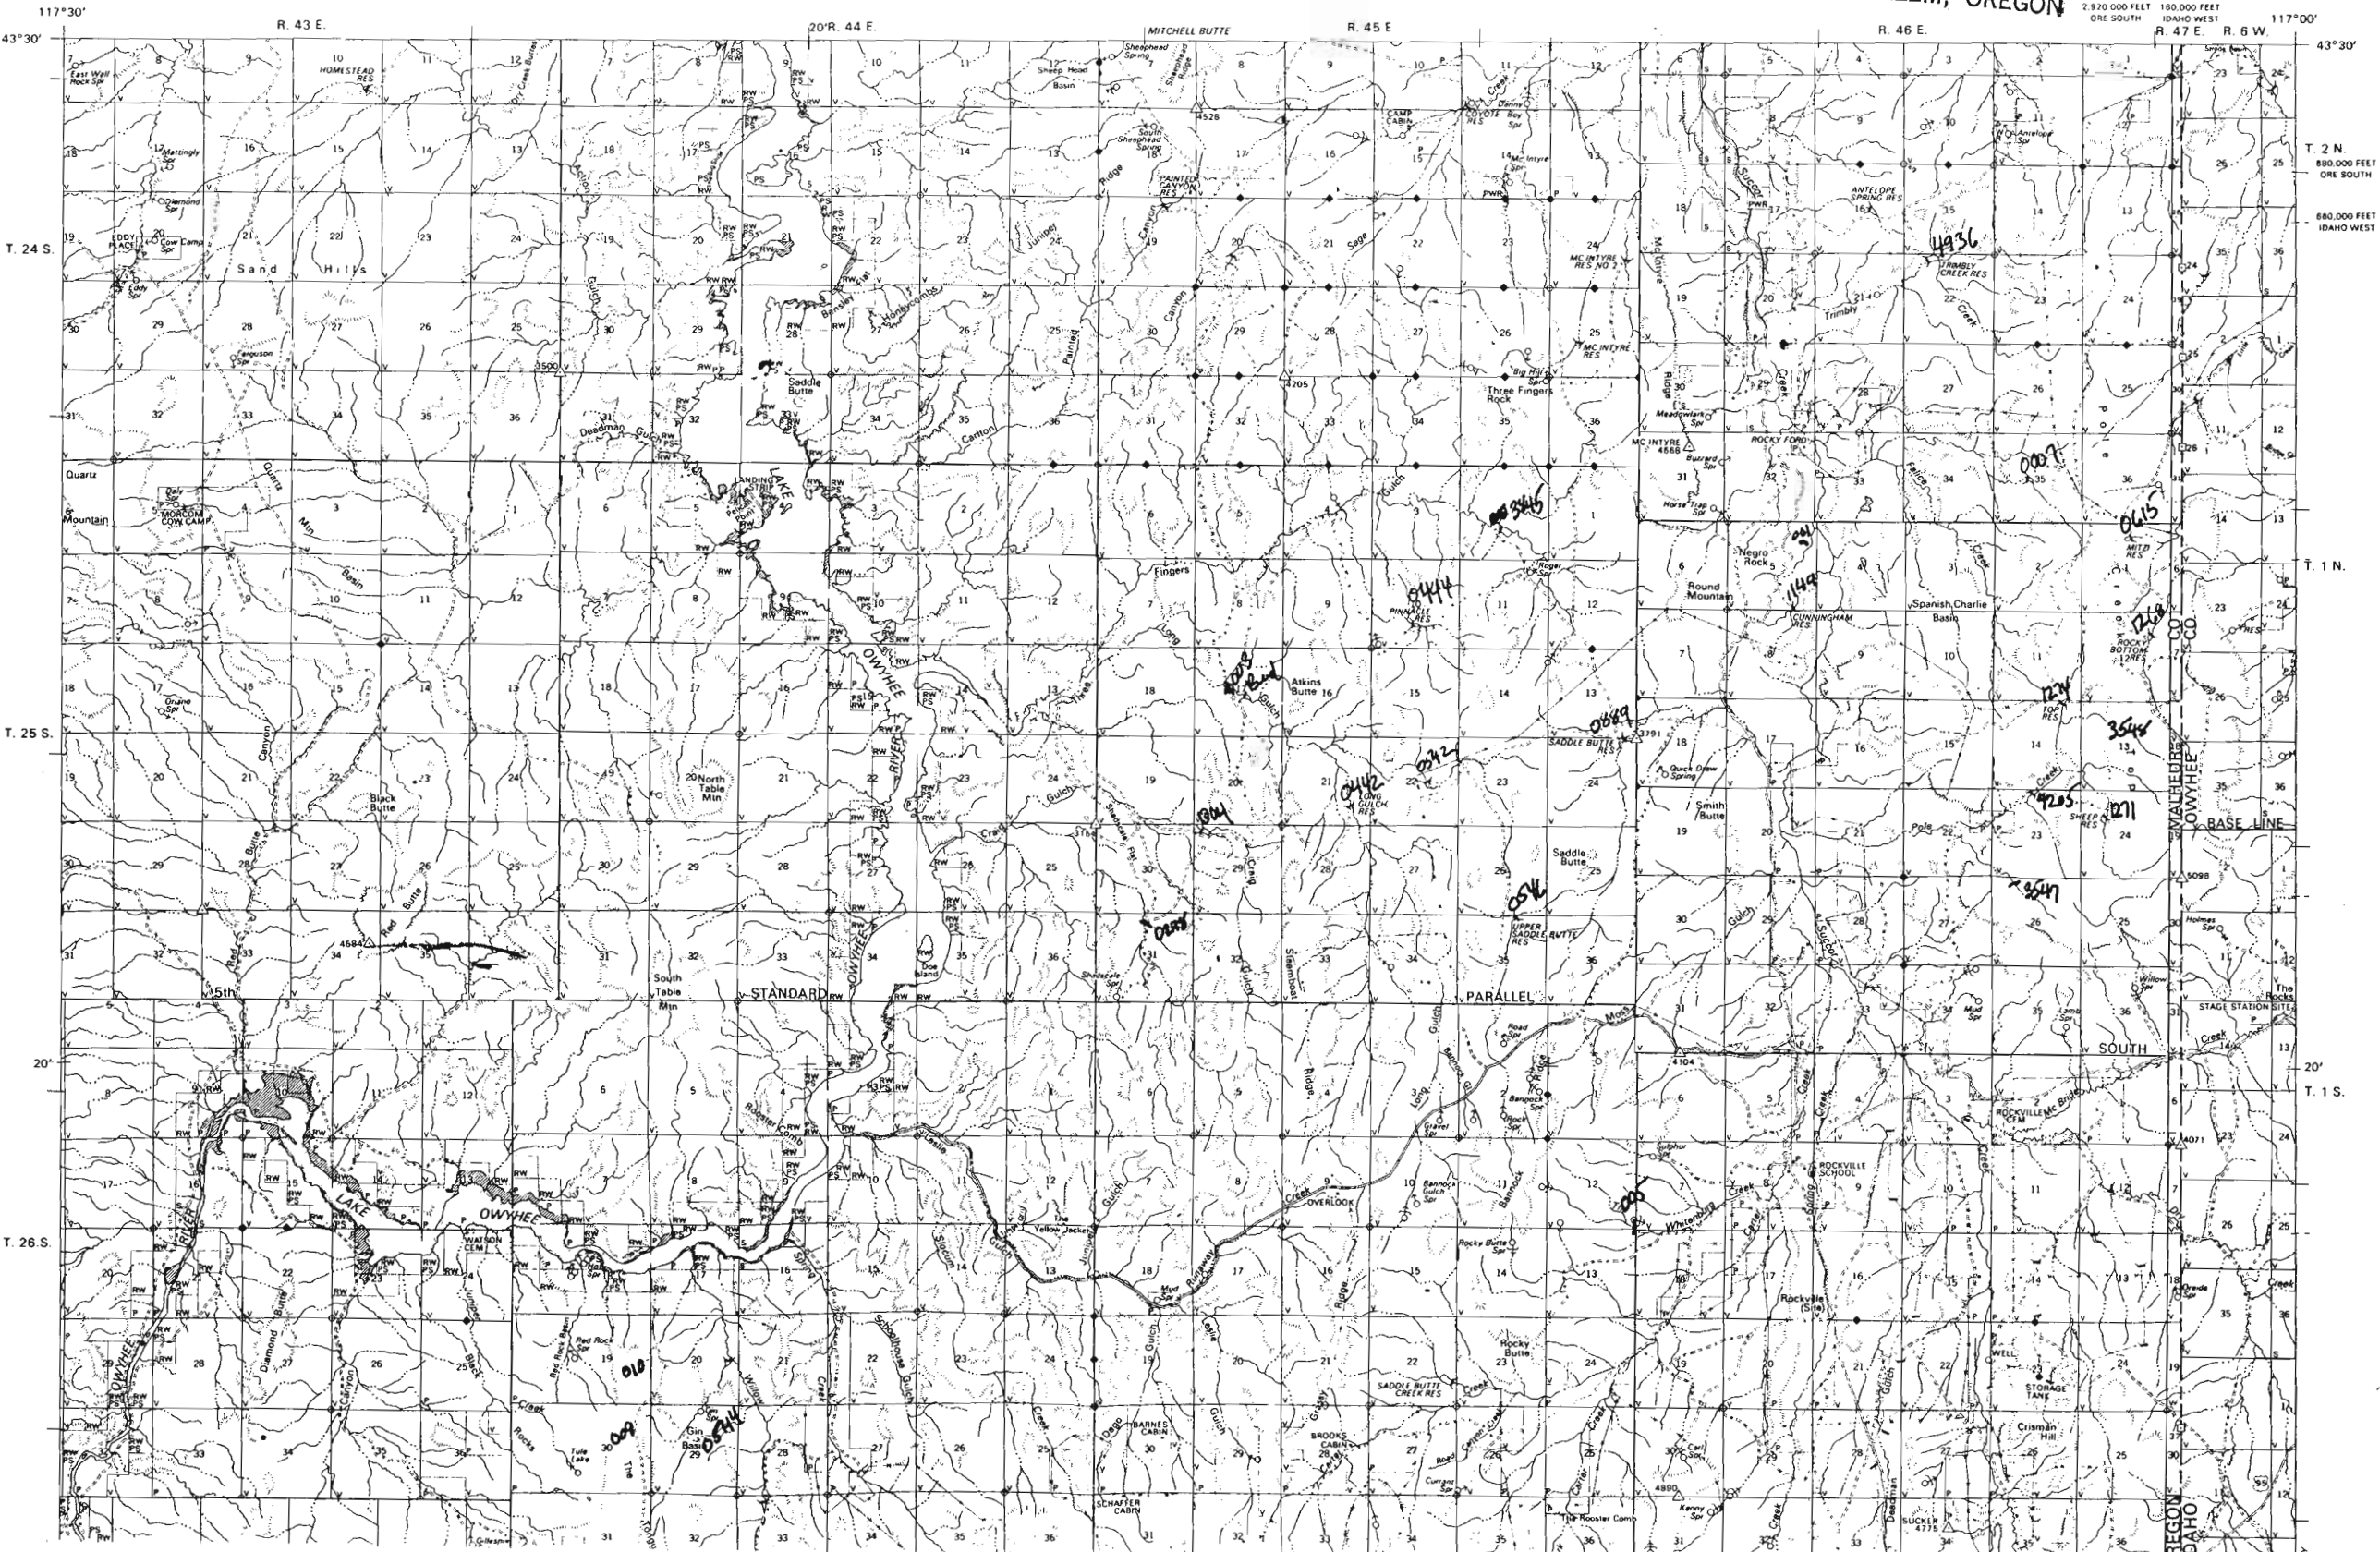

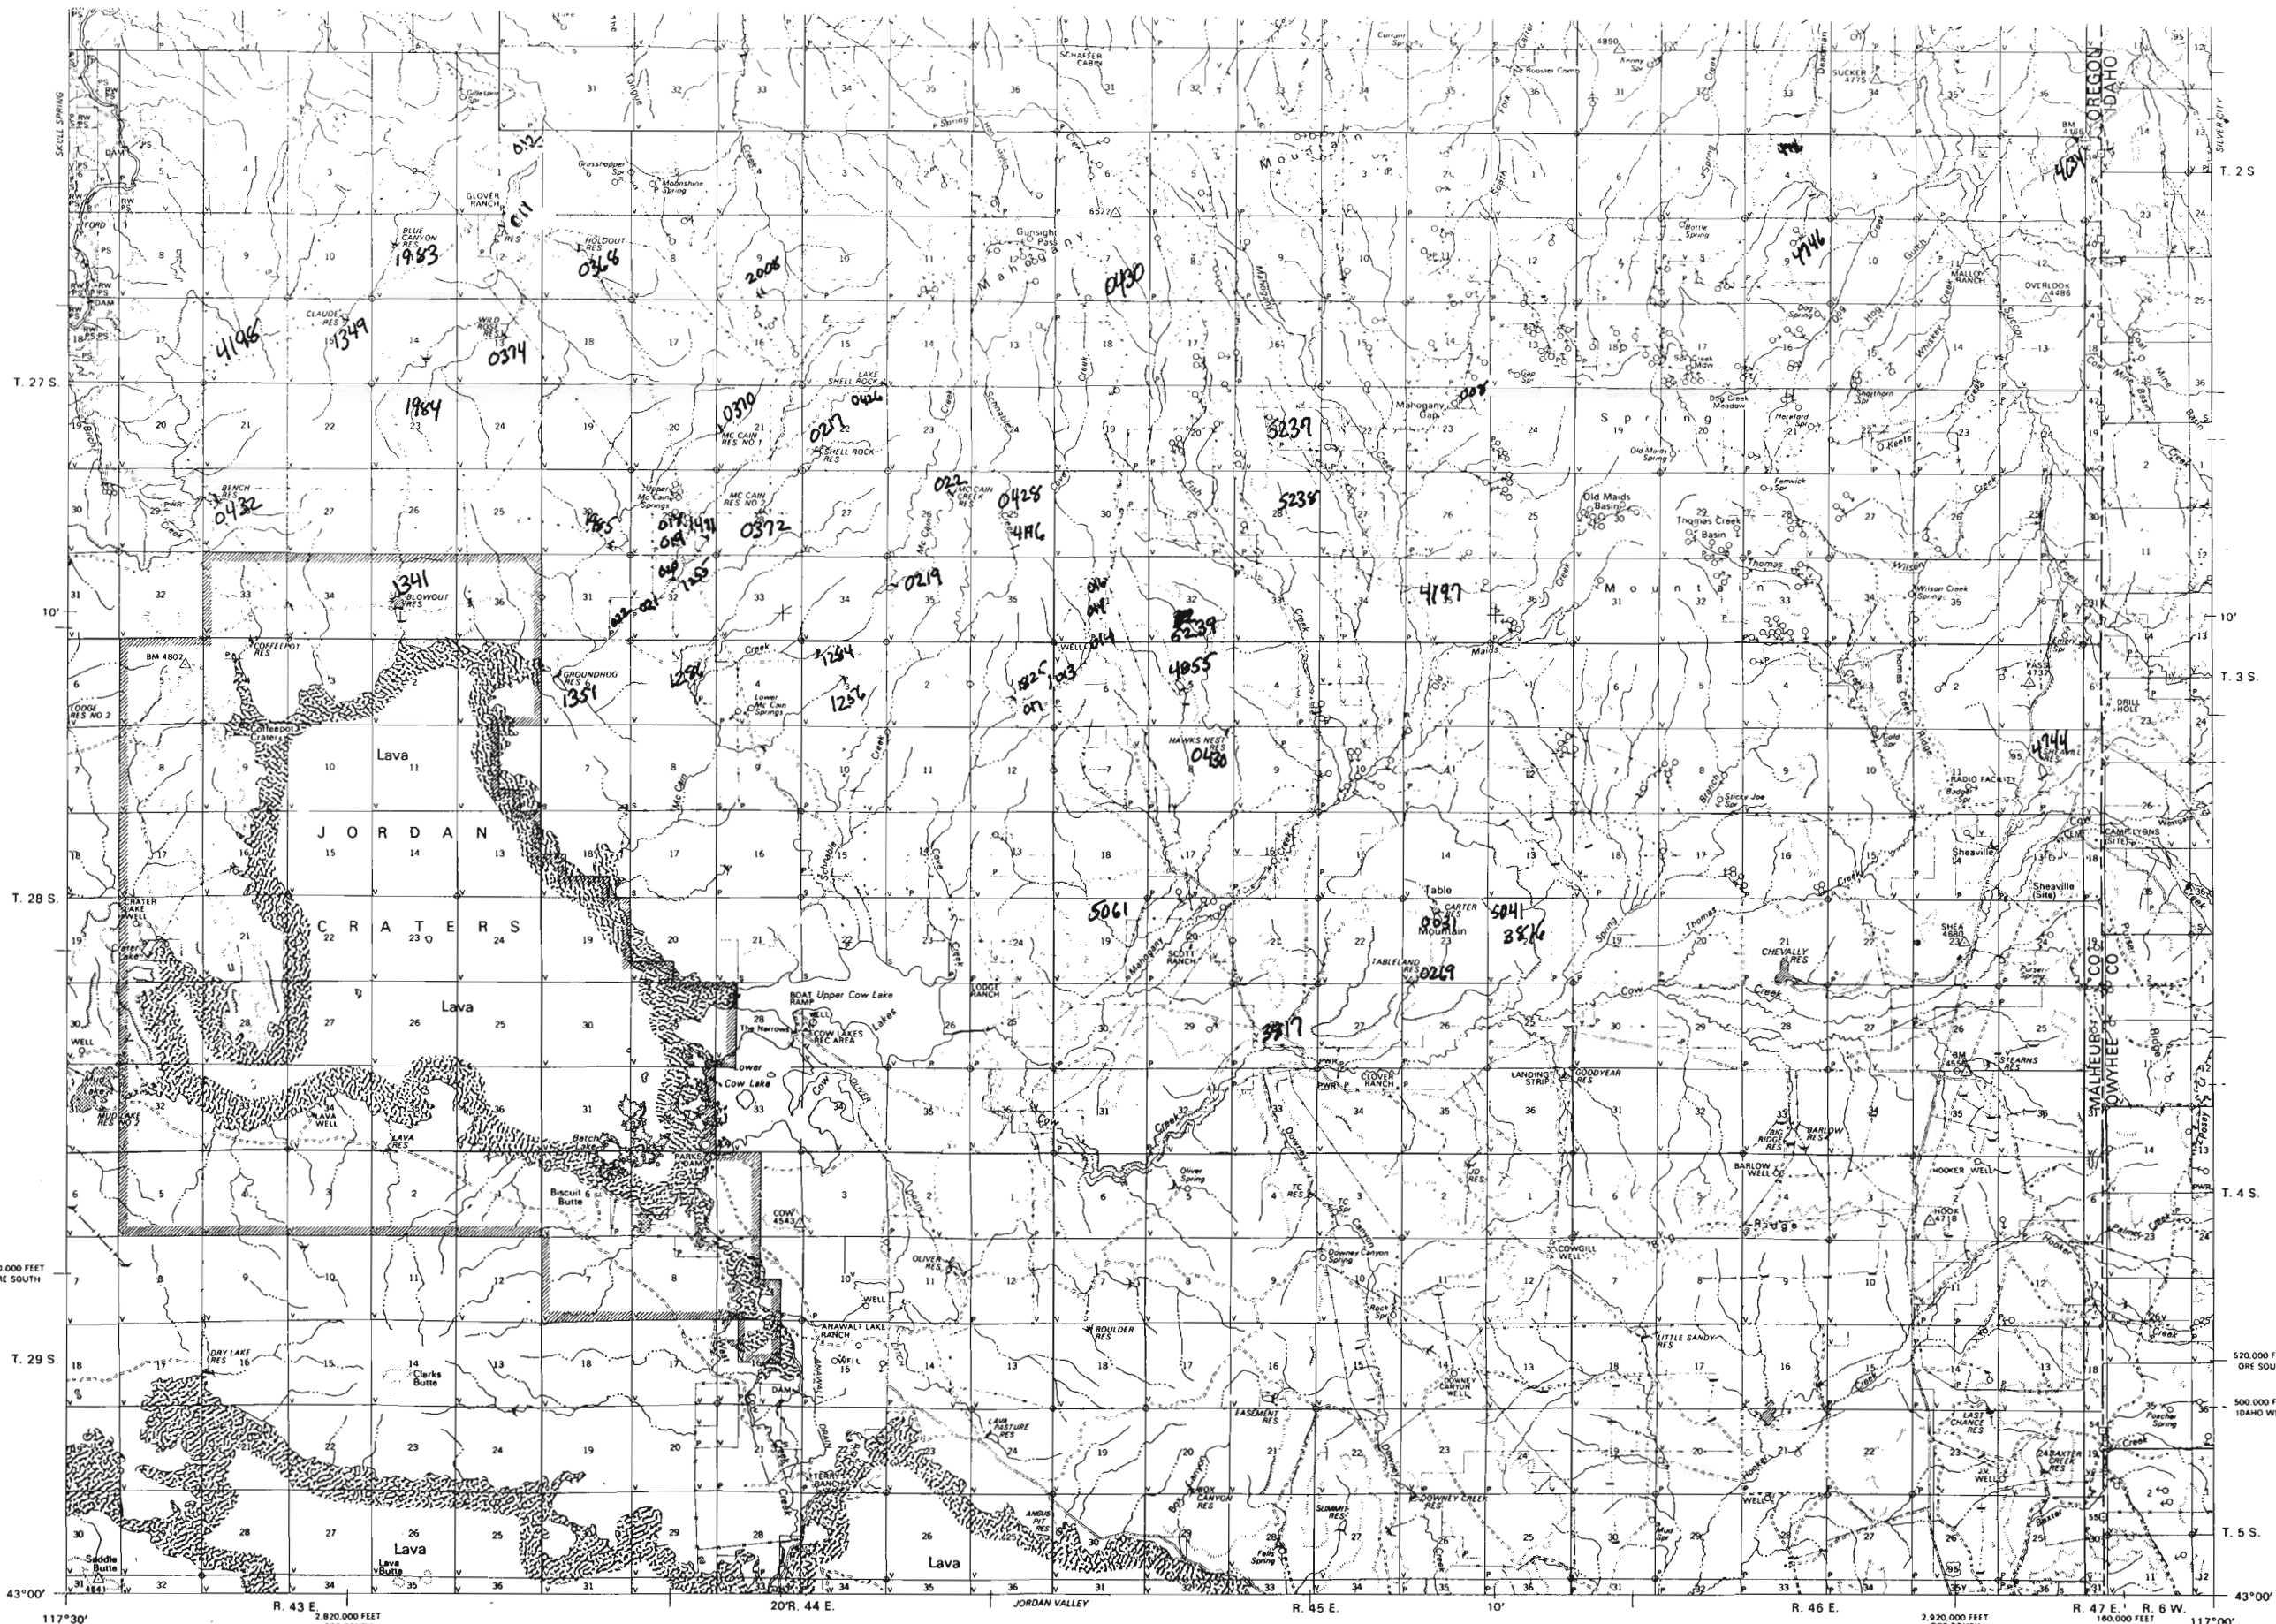

SOURCE MATERIAL DATA

A	A
A	A
A	A
A	A

(A) U.S.G.S. Quad Maps
(B) U.S.F.S. Quad Maps
(C) B.L.M. Completion
(D) State Highway Maps

Source Material Updated With Photography

LEGEND

RESEARCH NATURAL AREA	PIPELINE
PLANNING UNIT BONY	WATER TROUGH
ALL WEATHER ROAD	RESERVOIR
SEASONAL USE ROAD	WELL
PRIMITIVE ROAD	WINDMILL
TRAIL	SPRING (IMPROVED)
RAILROAD	INTERMITTENT STREAM
FENCE	
CATTLEWARD	

SCALE: 1" = 1 MILE

REVISIONS
PLANIMETRY 1/79
STATUS 1/79

LAND STATUS

V..... PUBLIC LAND (VACANT)
NF..... NATIONAL FOREST
P..... PRIVATE (PATENTED)
S..... STATE
RW..... RECLAMATION WITHDRAWAL
PS..... POWER SITE WITHDRAWAL
PWR..... PUBLIC WATER RESERVE

CERTIFICATE NO. 70078

Application No. R-76091

Permit No.

SHEAVILLE, OREGON 43-112-2 1974