


"CERTIFICATE NO. _____

70094

FINAL PROOF MAP

Application No. 15-11252
Permit No.

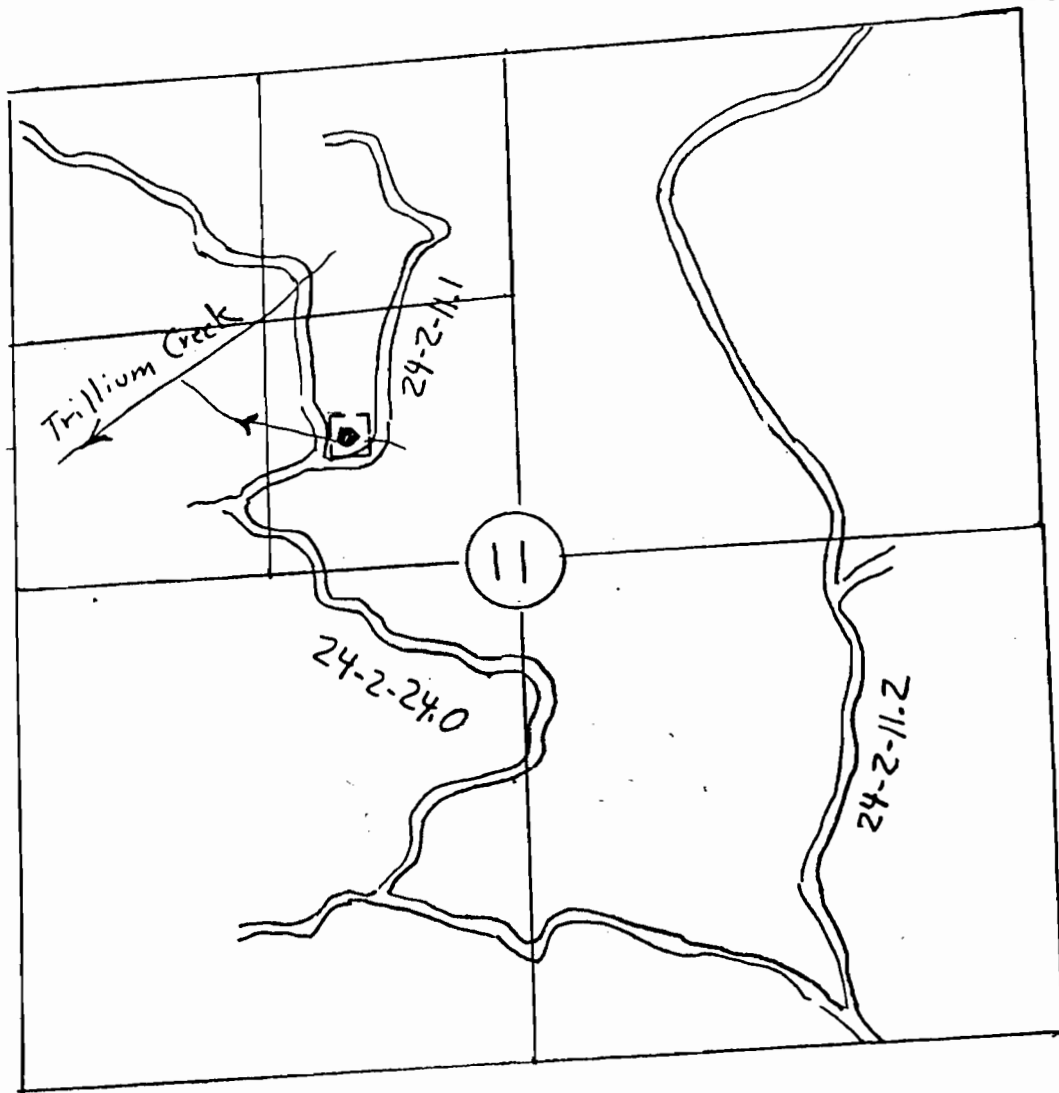


Scale 1" = 1000'

Windthrow Pond
T24S R2W Sec11
SE $\frac{1}{4}$, NW $\frac{1}{4}$

The point of diversion is located approximately 1800 feet South and 1780 feet East from the Northwest Section Corner of Section 11.

Coordinate Ties are based on aerial photo 10-45A-42.

The map is shown for the purpose of water application and not property boundary.

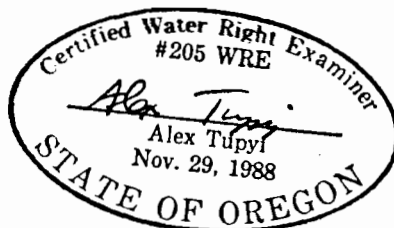

7-9-91