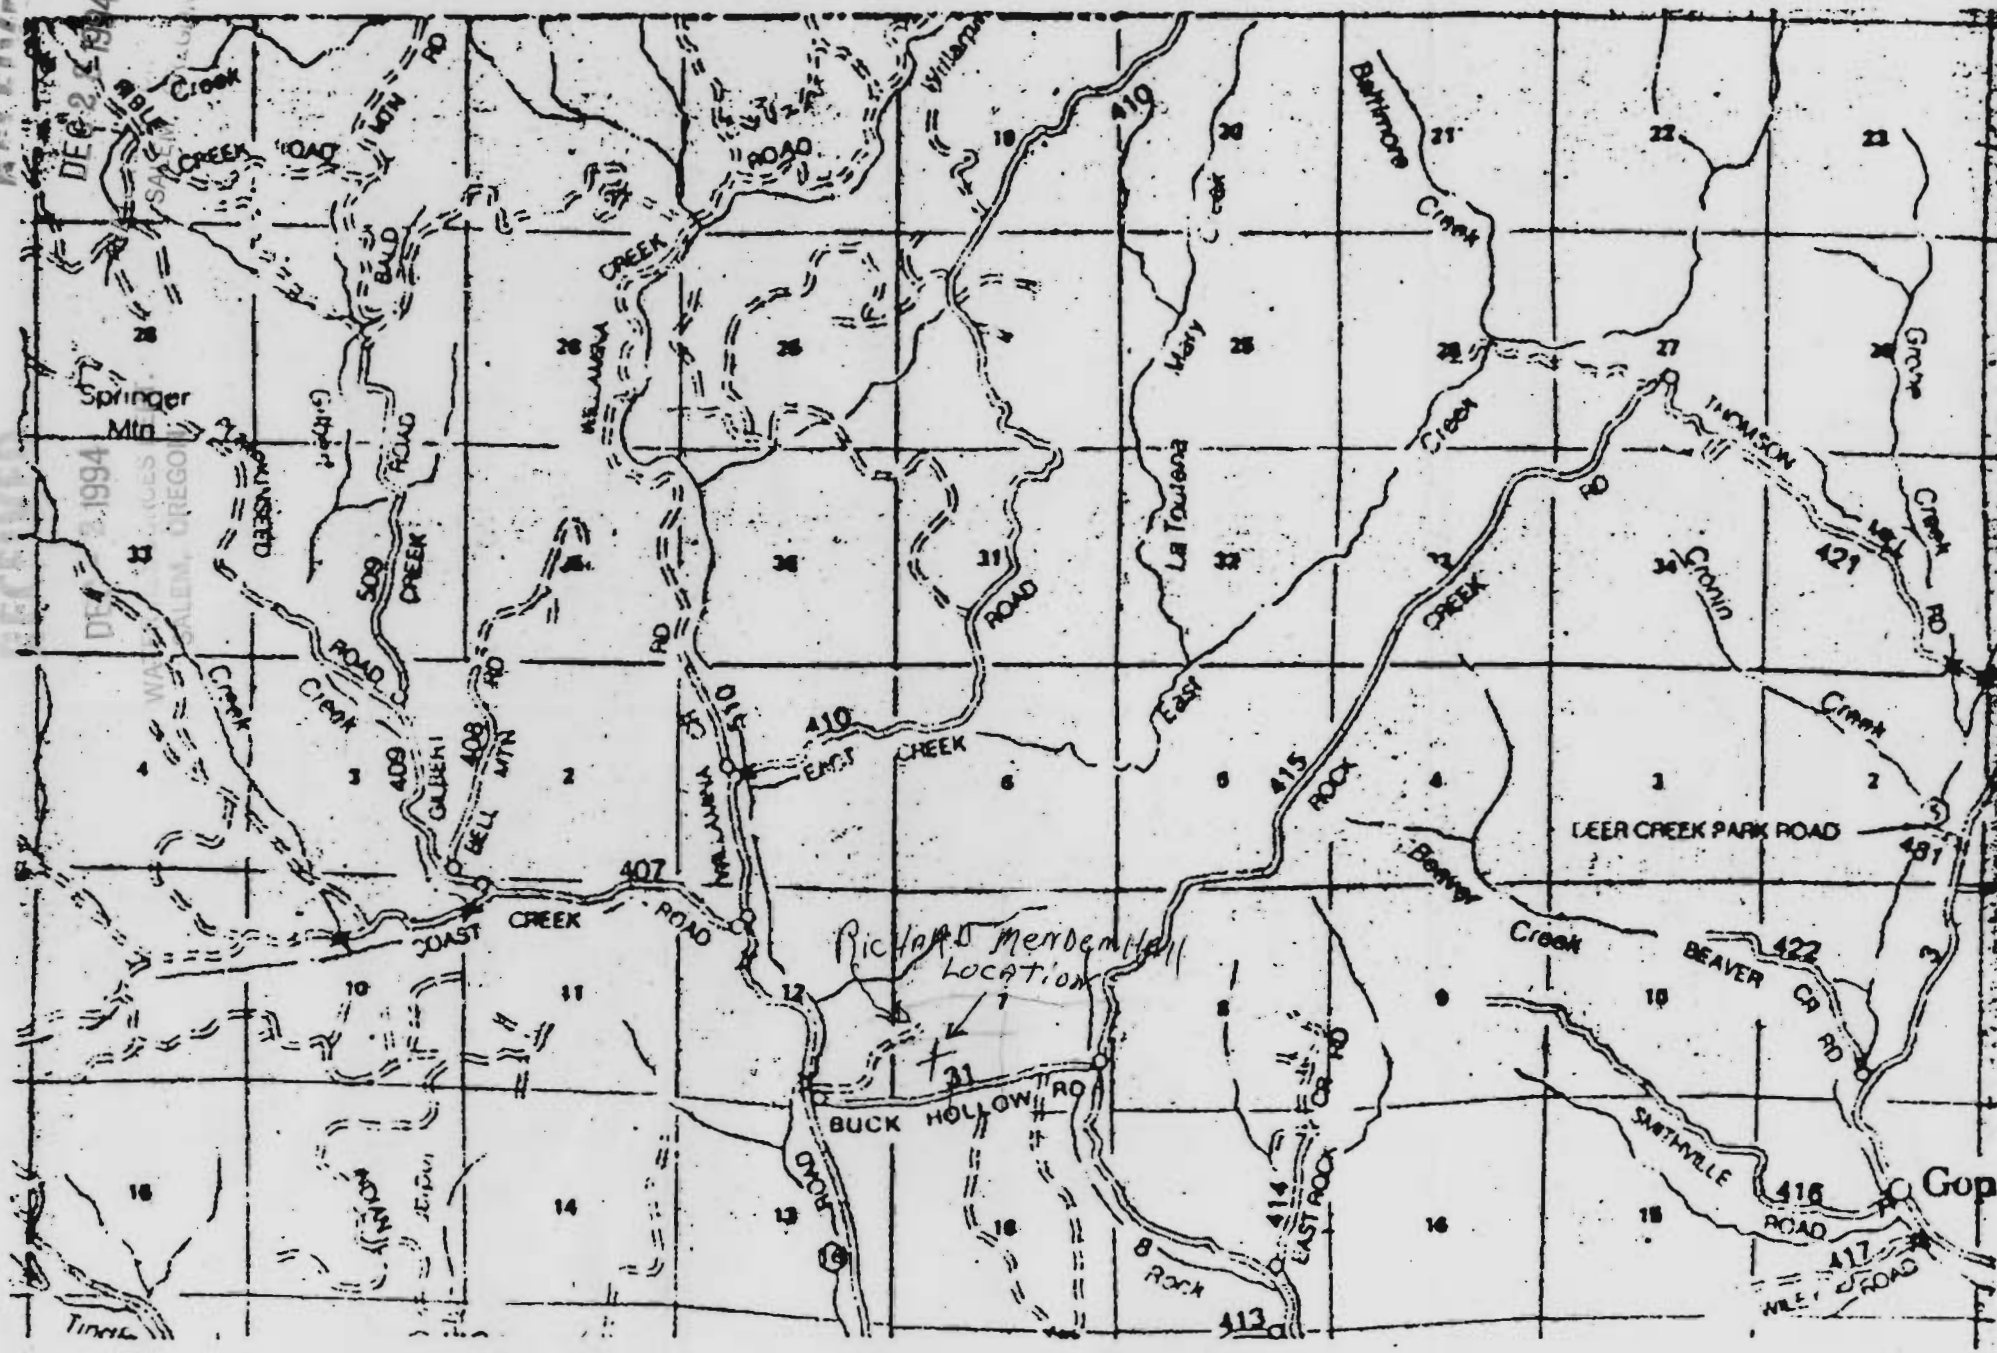

Application No R-76113
Permit No.

CERTIFICATE NO. 70099