RECEIVED
DEC 28 1994
WATER RESOURCES DEPT.
SALEM, OREGON

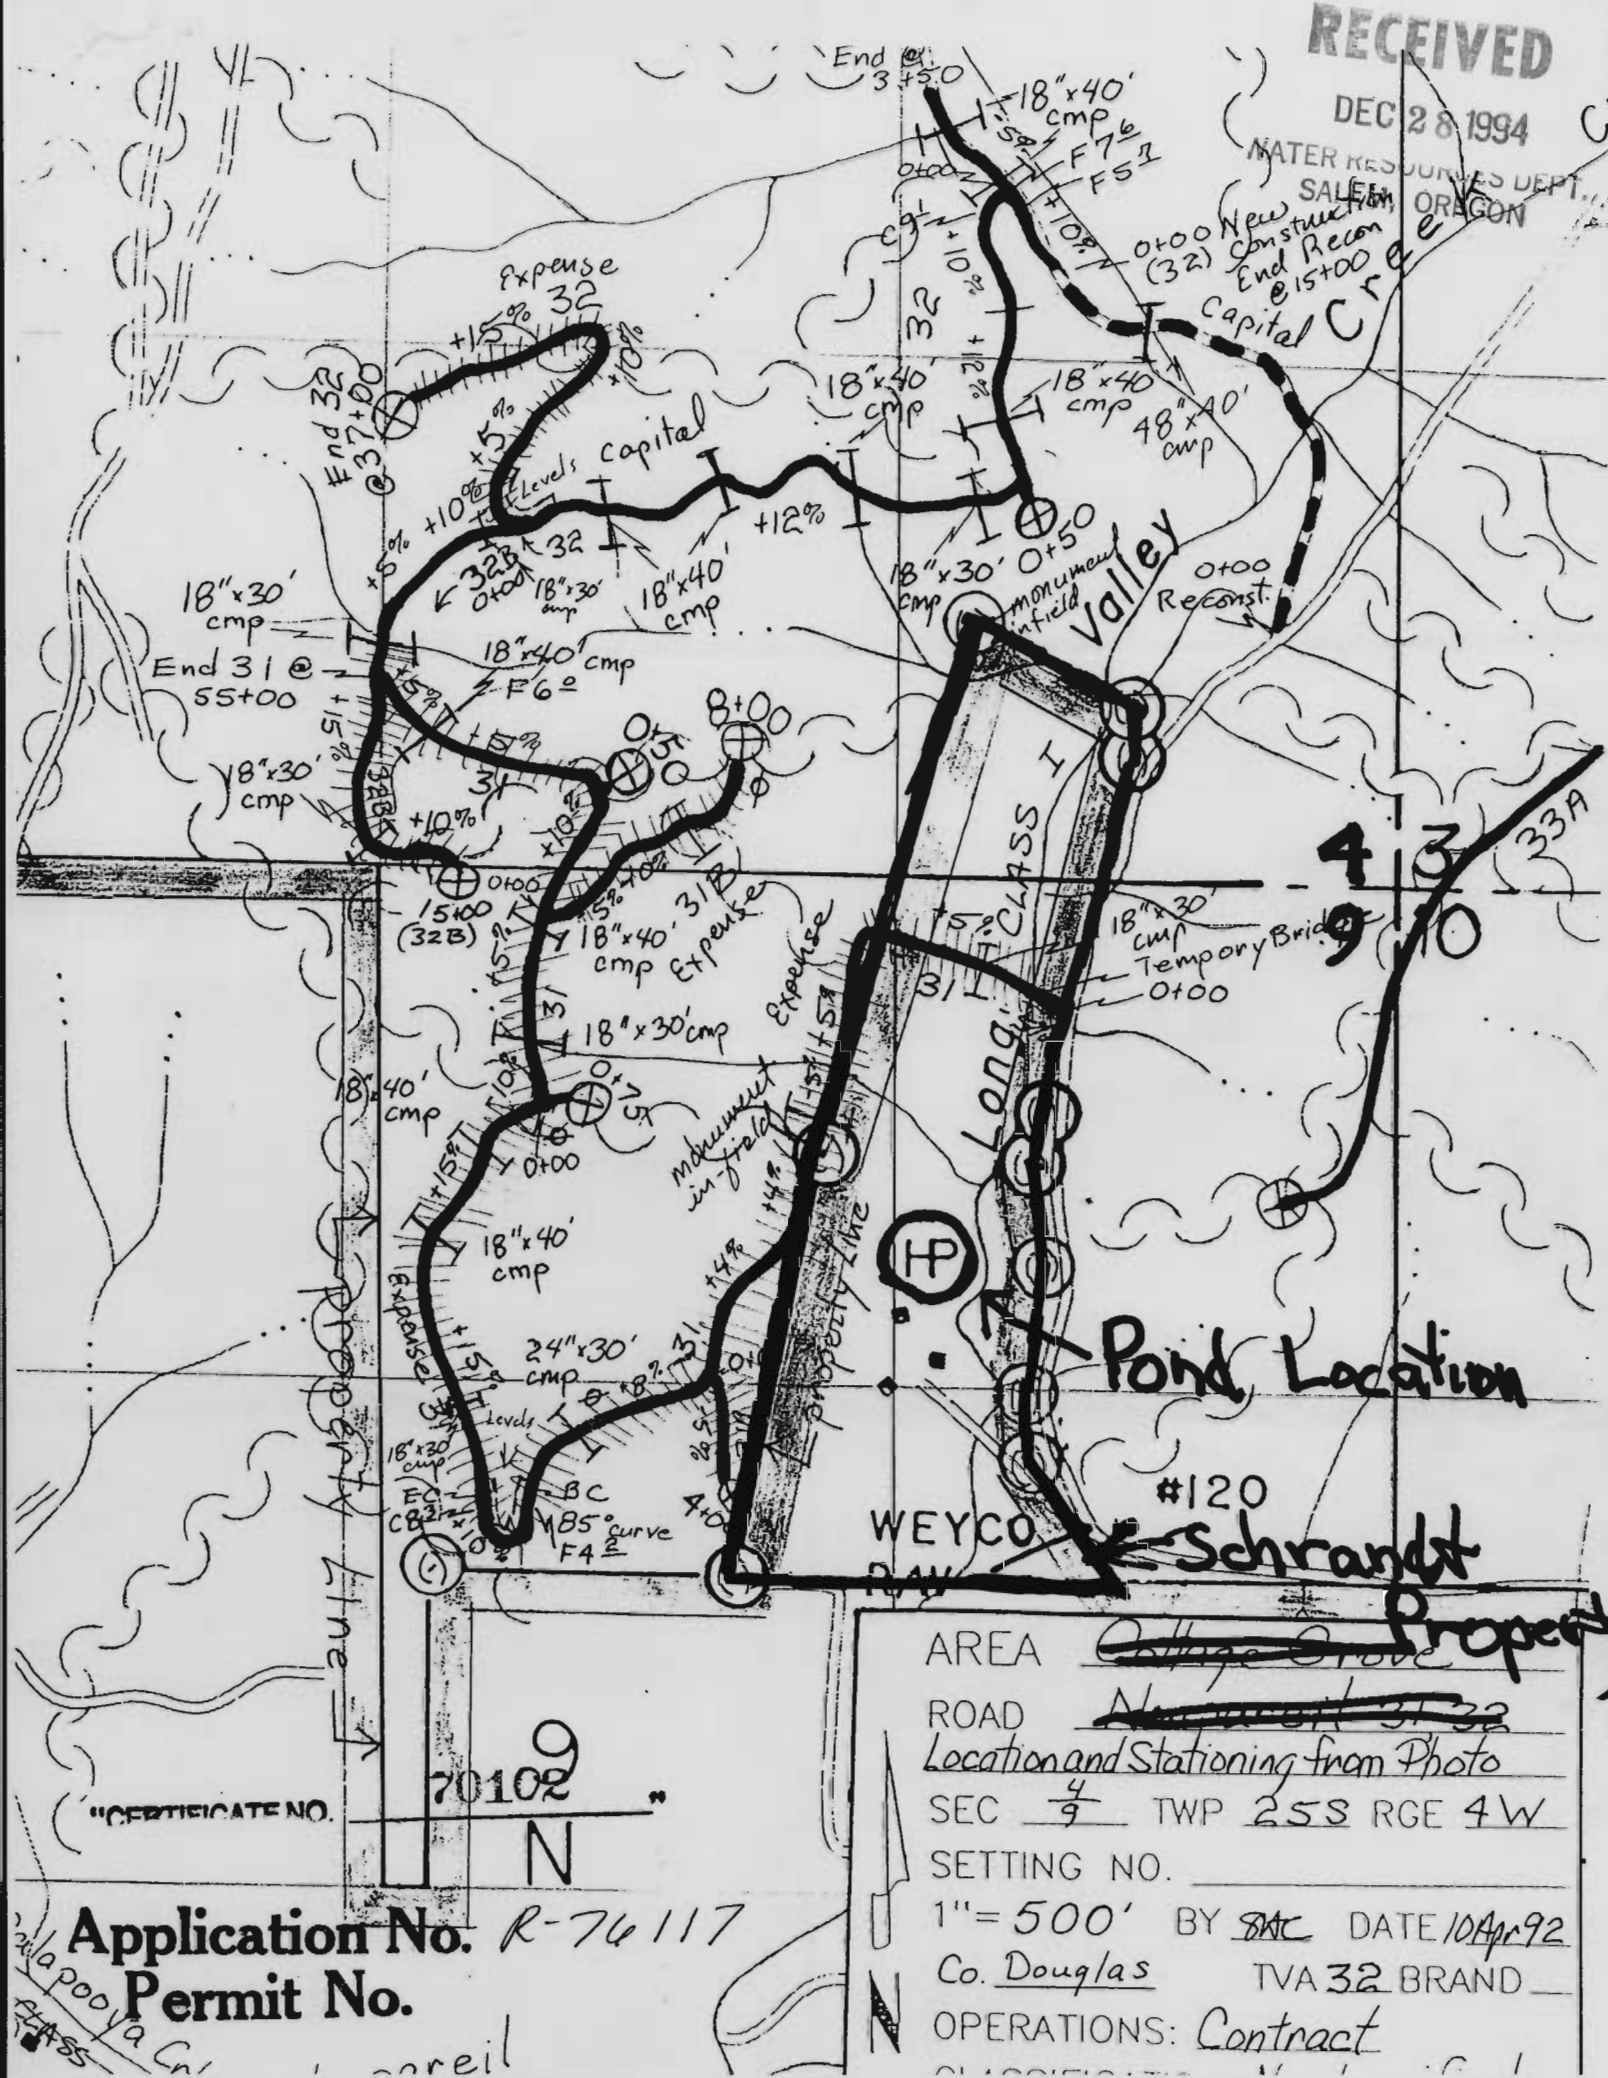

"CERTIFICATE NO. 70102"

AREA ~~Cottage Grove~~

ROAD ~~Newport 31-32~~

Location and Stationing from Photo

SEC 4/9 TWP 25S RGE 4W

SETTING NO.

1" = 500' BY SAC DATE 10Apr92

Co. Douglas TVA 32 BRAND

OPERATIONS: Contract

Application No. R-76117

Permit No.