SE1/4 SEC. 24 T.27S. R.7W. W.M.
DOUGLAS COUNTY

27 7 24D

REVISED ON 4-26-91

THIS MAP WAS PREPARED FOR ASSESSMENT PURPOSE ONLY.

1"=200'

SEE MAP 27 7 24

"CERTIFICATE NO. 75550 ~~70103~~ " Application No. R-76[illegible]8 Permit No.

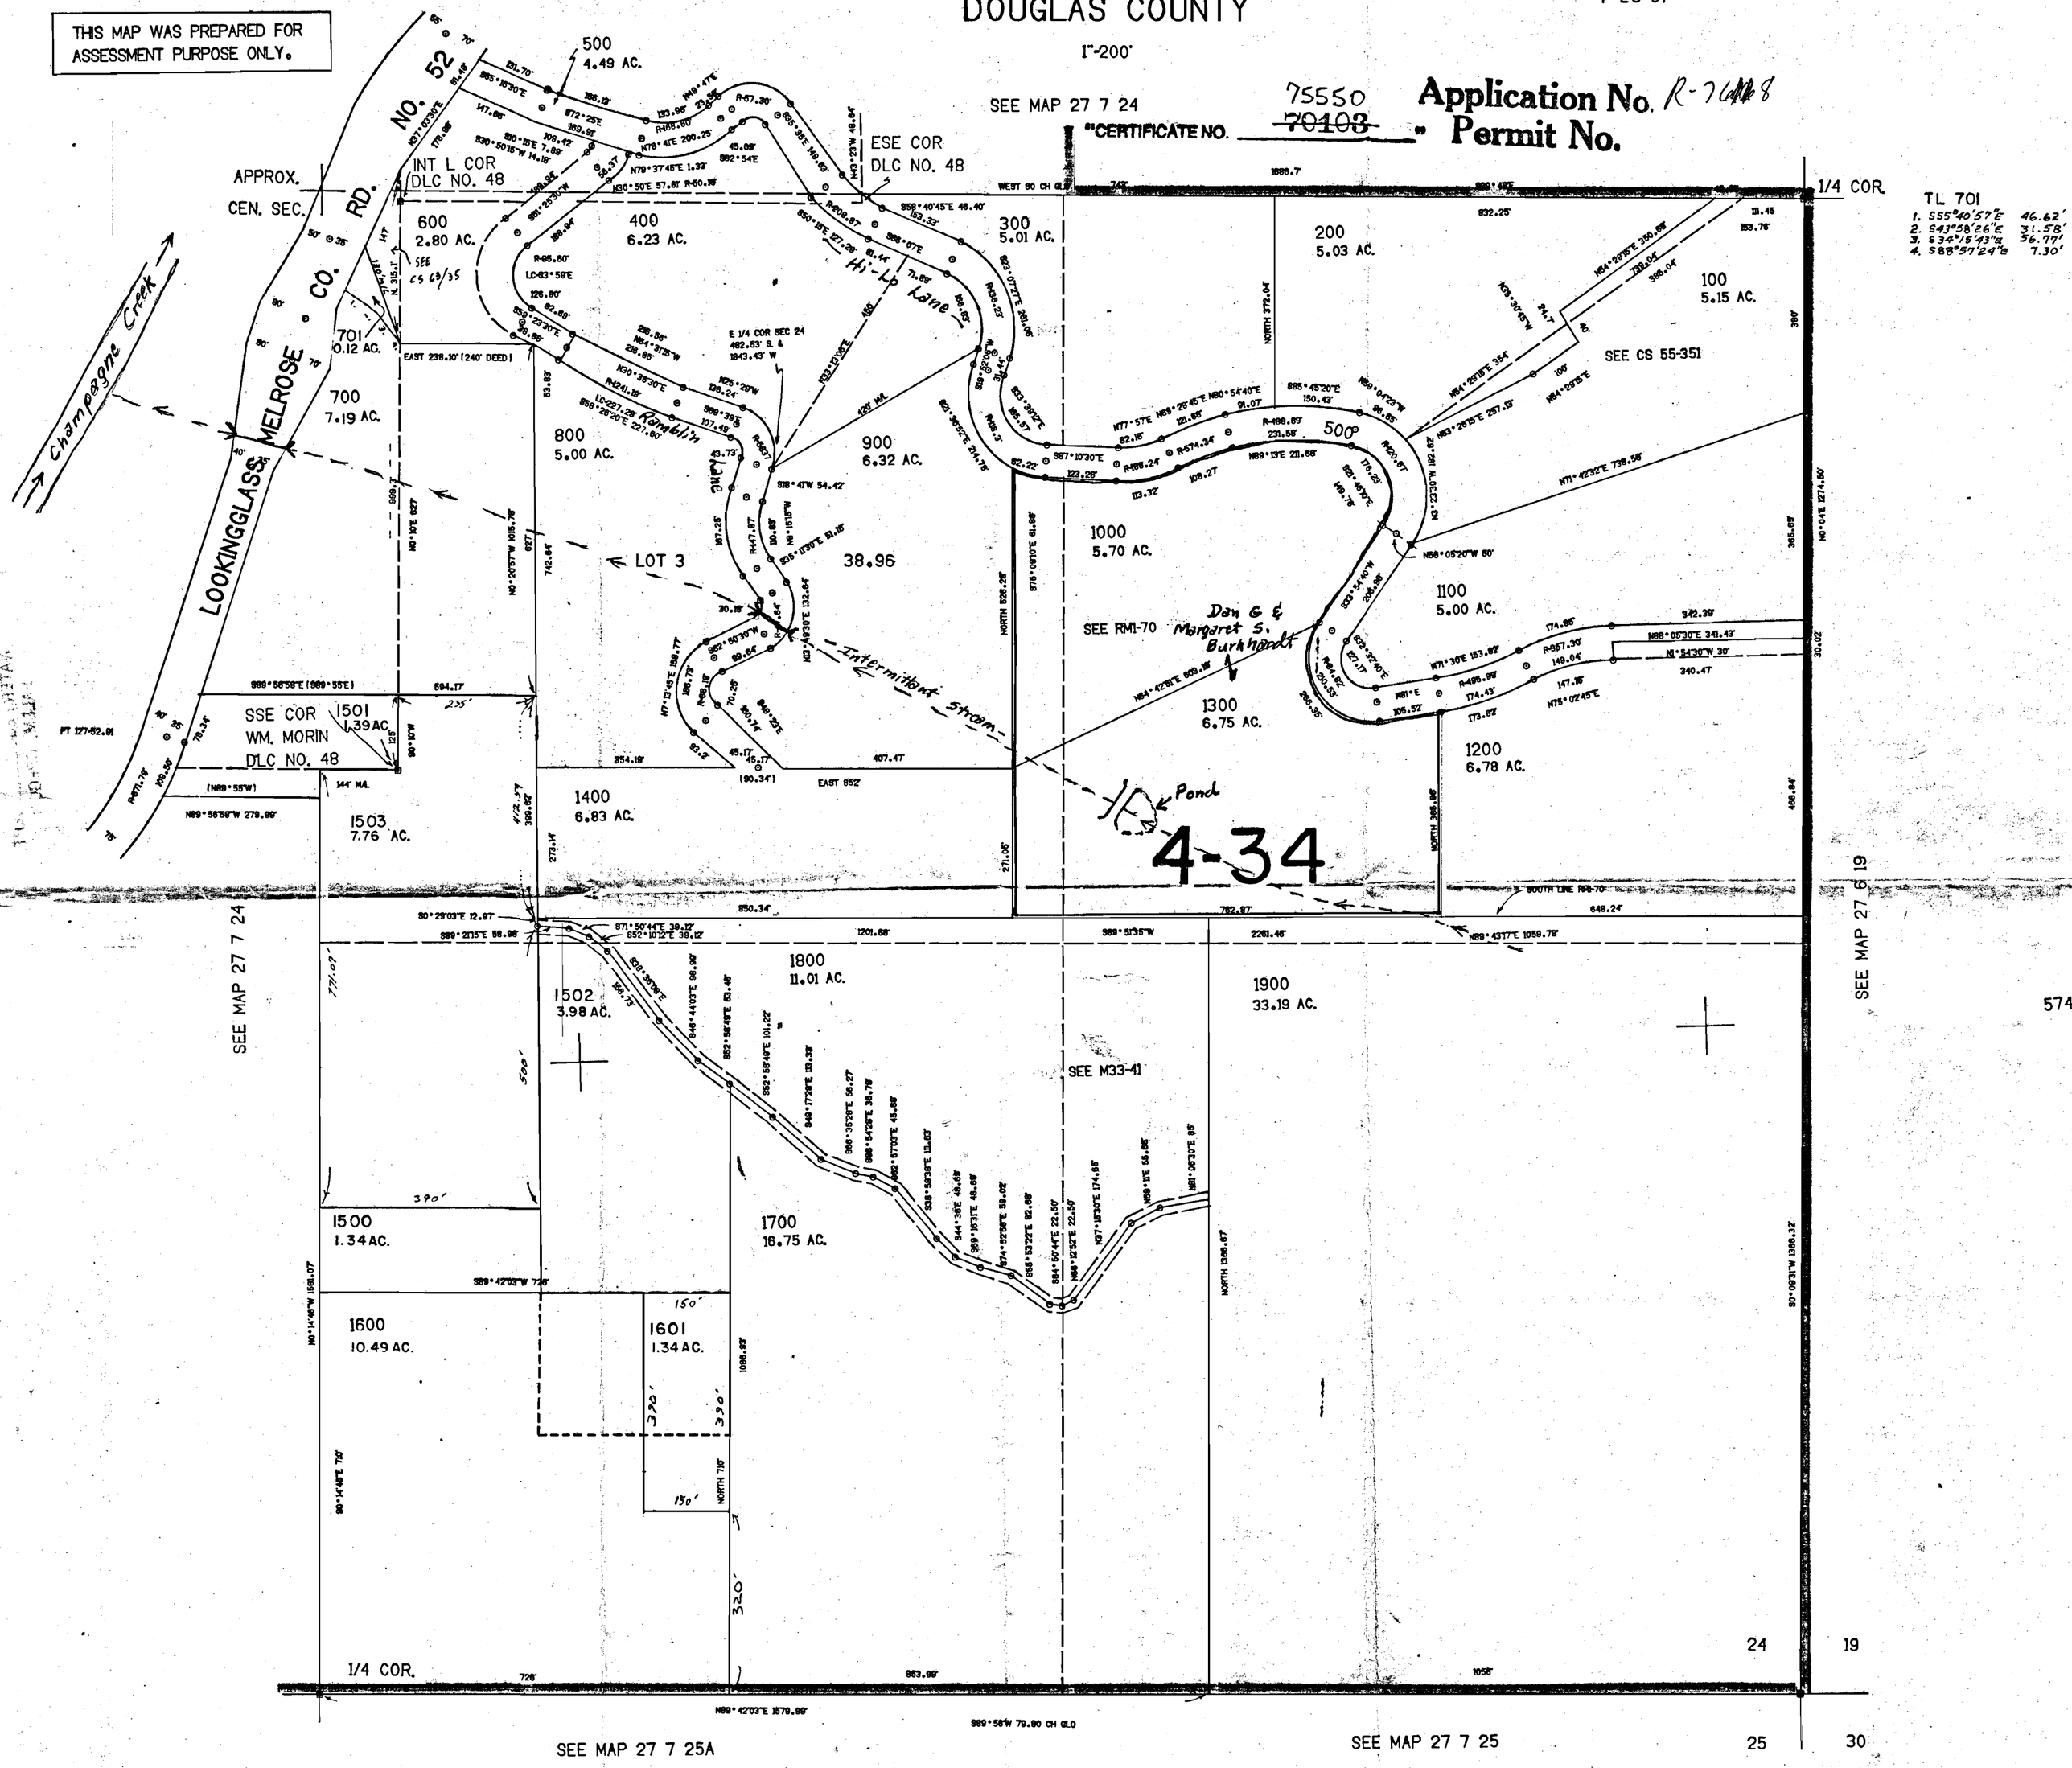

27 7 24D