

DEC 28 1994


WATER SALES

T.I.S.R.4W.W.M.

Application No. *R-76120*

Permit No.

"CERTIFICATE NO. 70106"

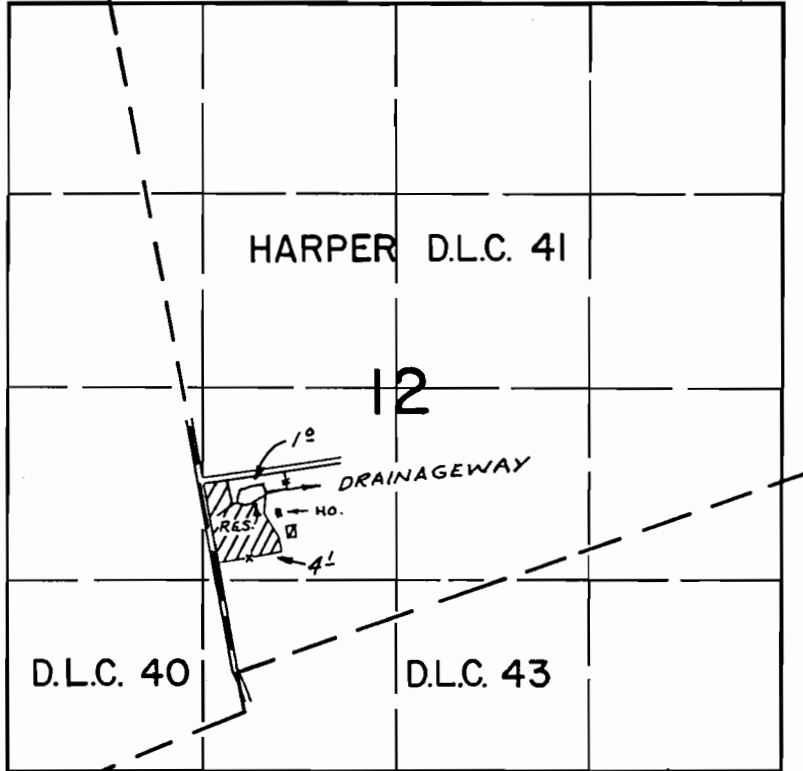

DIV. PT. Loc: 1230' N. & 200' E. FROM S.W. COR. HARPER D.L.C. 41

FINAL PROOF SURVEY UNDER

Application No. *R-48876* Permit No. *R-5932*
48877 *36622*

IN NAME OF

ROGER GENE RITCHEY

Surveyed *APR. 25 1979*, by *R. MUCKEN*

RECEIVED JUN 30 1986