DEC 28 1994
WATER RESOURCES DEPT
SALEM, OREGON

SECTION 23 T2N R3W W.M.

WASHINGTON COUNTY OREGON

SCALE 1"=400'

Application No. R-76122
Permit No.

SEE MAP
2N 3 14

"CERTIFICATE NO. 70107"

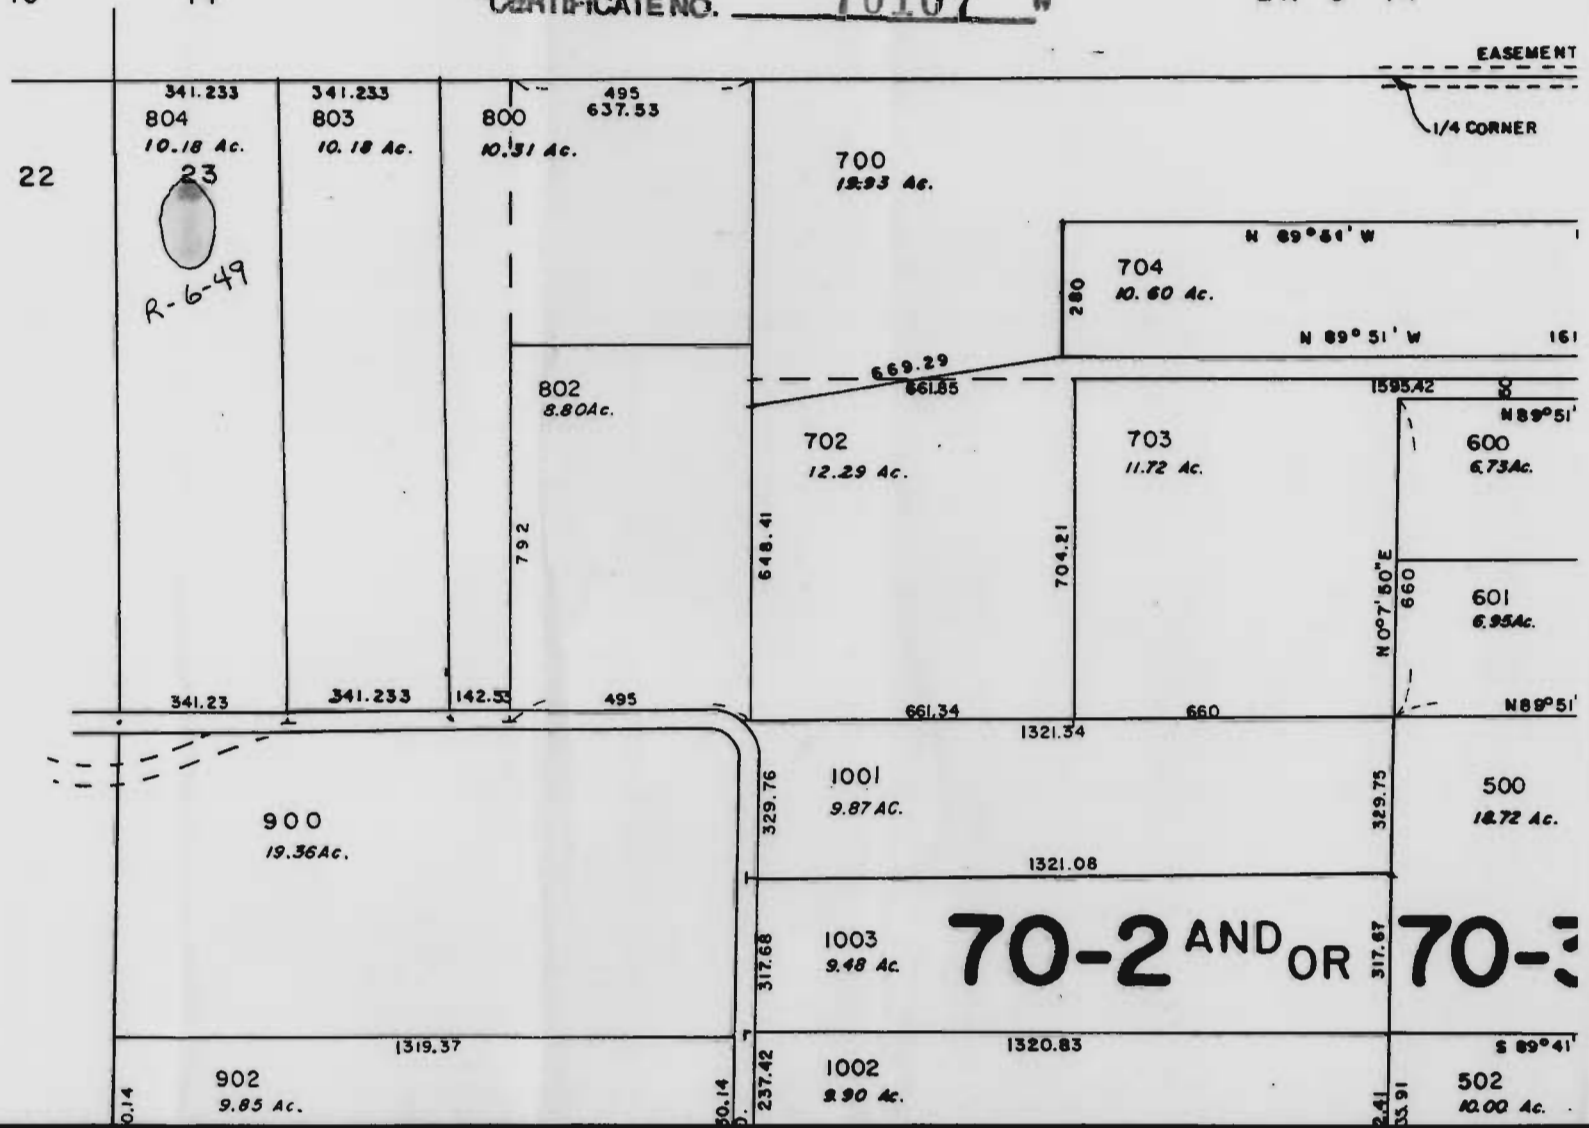

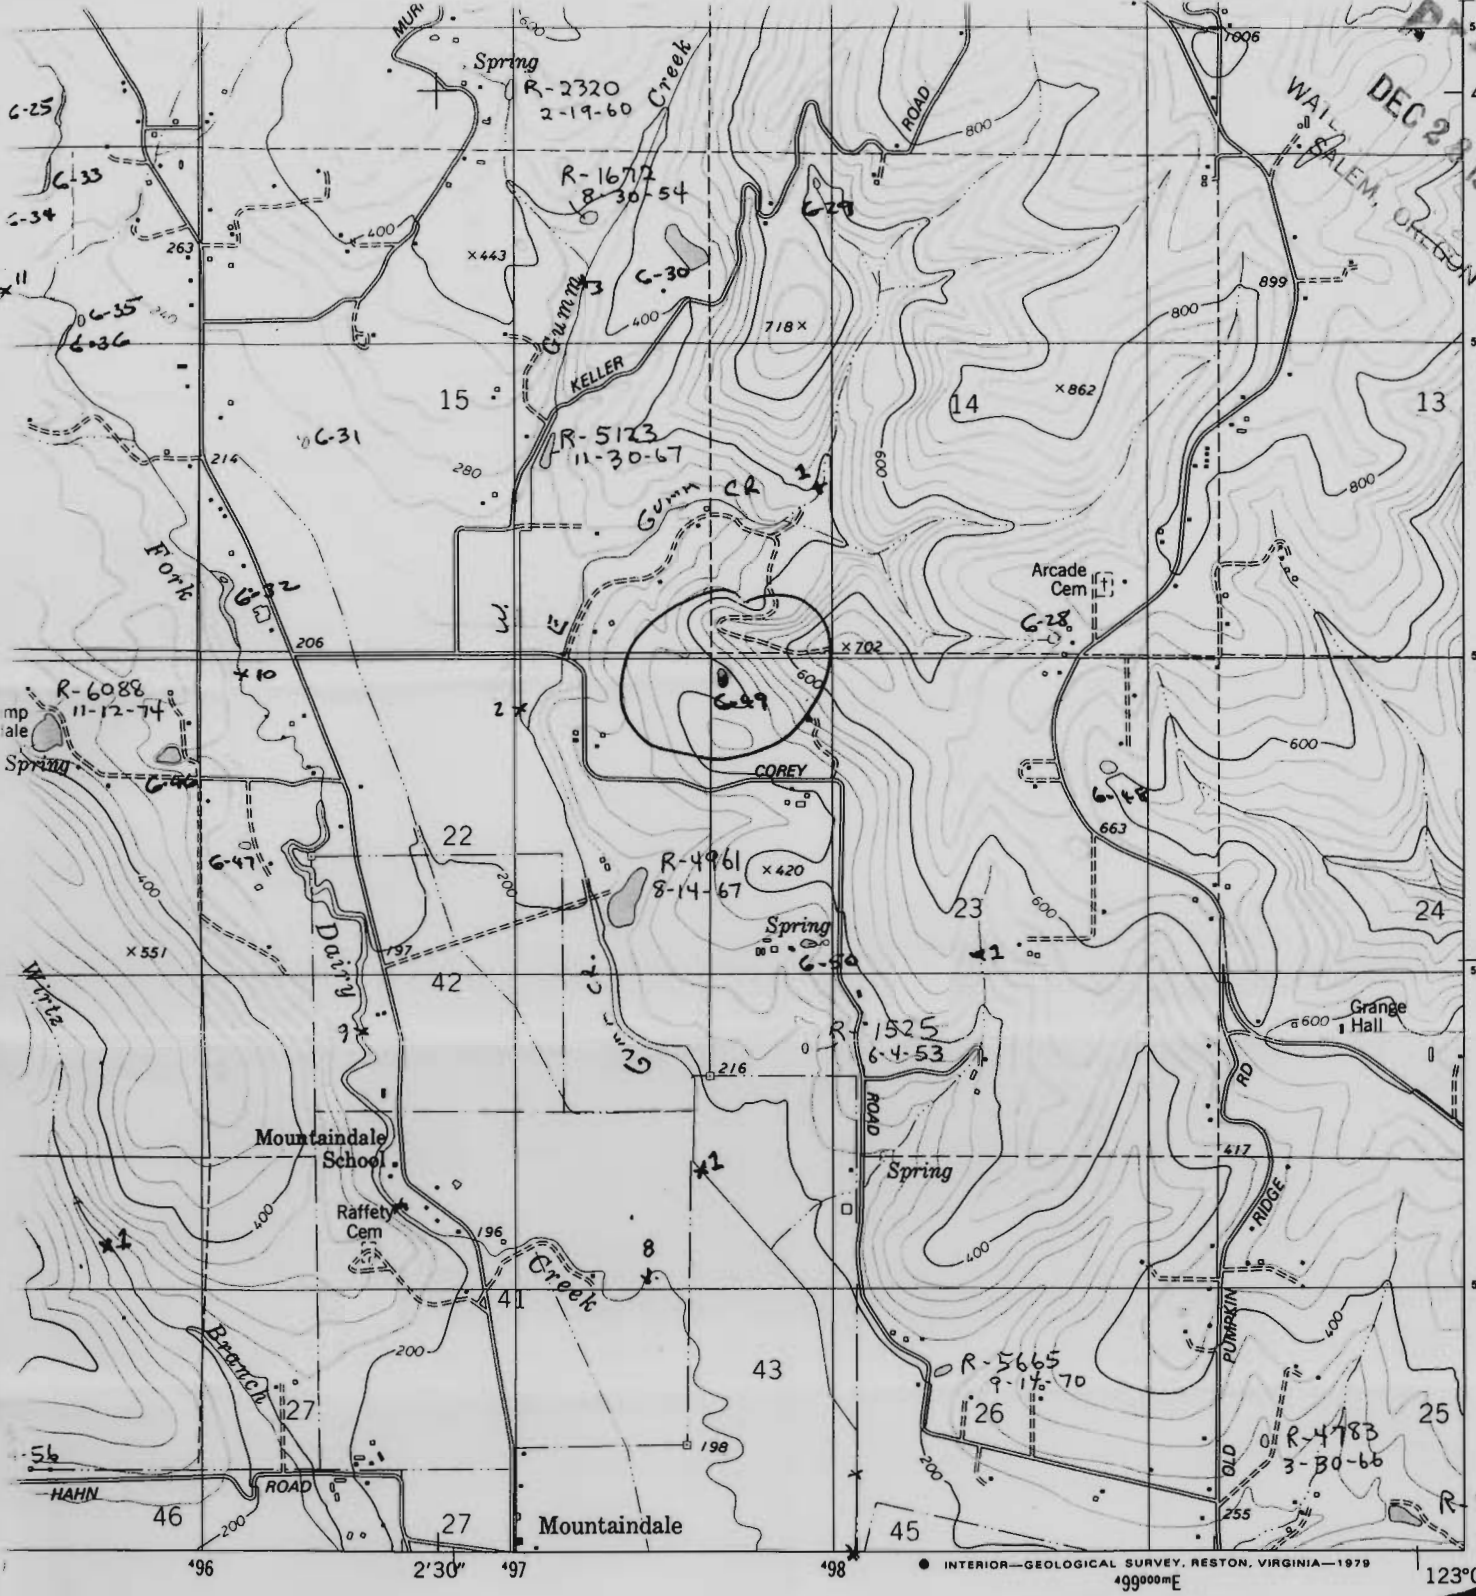

INTERIOR—GEOLOGICAL SURVEY, RESTON, VIRGINIA—1979

ROAD CLASSIFICATION

Primary highway, hard surface

Secondary highway, hard surface

Light-duty road, hard or improved surface

Unimproved road

Interstate Route U. S. Route State Route

1 MILE

4000 5000 6000 7000 FEET

1 KILOMETER

40 FEET

FOOT CONTOURS

DATUM OF 1929

OREGON

QUADRANGLE LOCATION

AP ACCURACY STANDARDS

RADO 80225, OR RESTON, VIRGINIA 22092

YMBOLS IS AVAILABLE ON REQUEST

MEACHAM CORNER, OREG.

NE/4 FOREST GROVE 15' QUADRANGLE

N4537.5—W12300/7.5

1979

DMA 1375 II NE—SERIES V892

"CERTIFICATE NO. 70107"

Application No R-76122

Permit No.

12 HILLSBORO 1275 II SW