


SEE MAP
2S 2 26

RECEIVED
DEC 23 1994
WALTON RESOURCES DEPT
SALEM, OREGON

TAX LOT 302 CANCELLED
600-T1, 1405, 1101, 120
906, 1100,

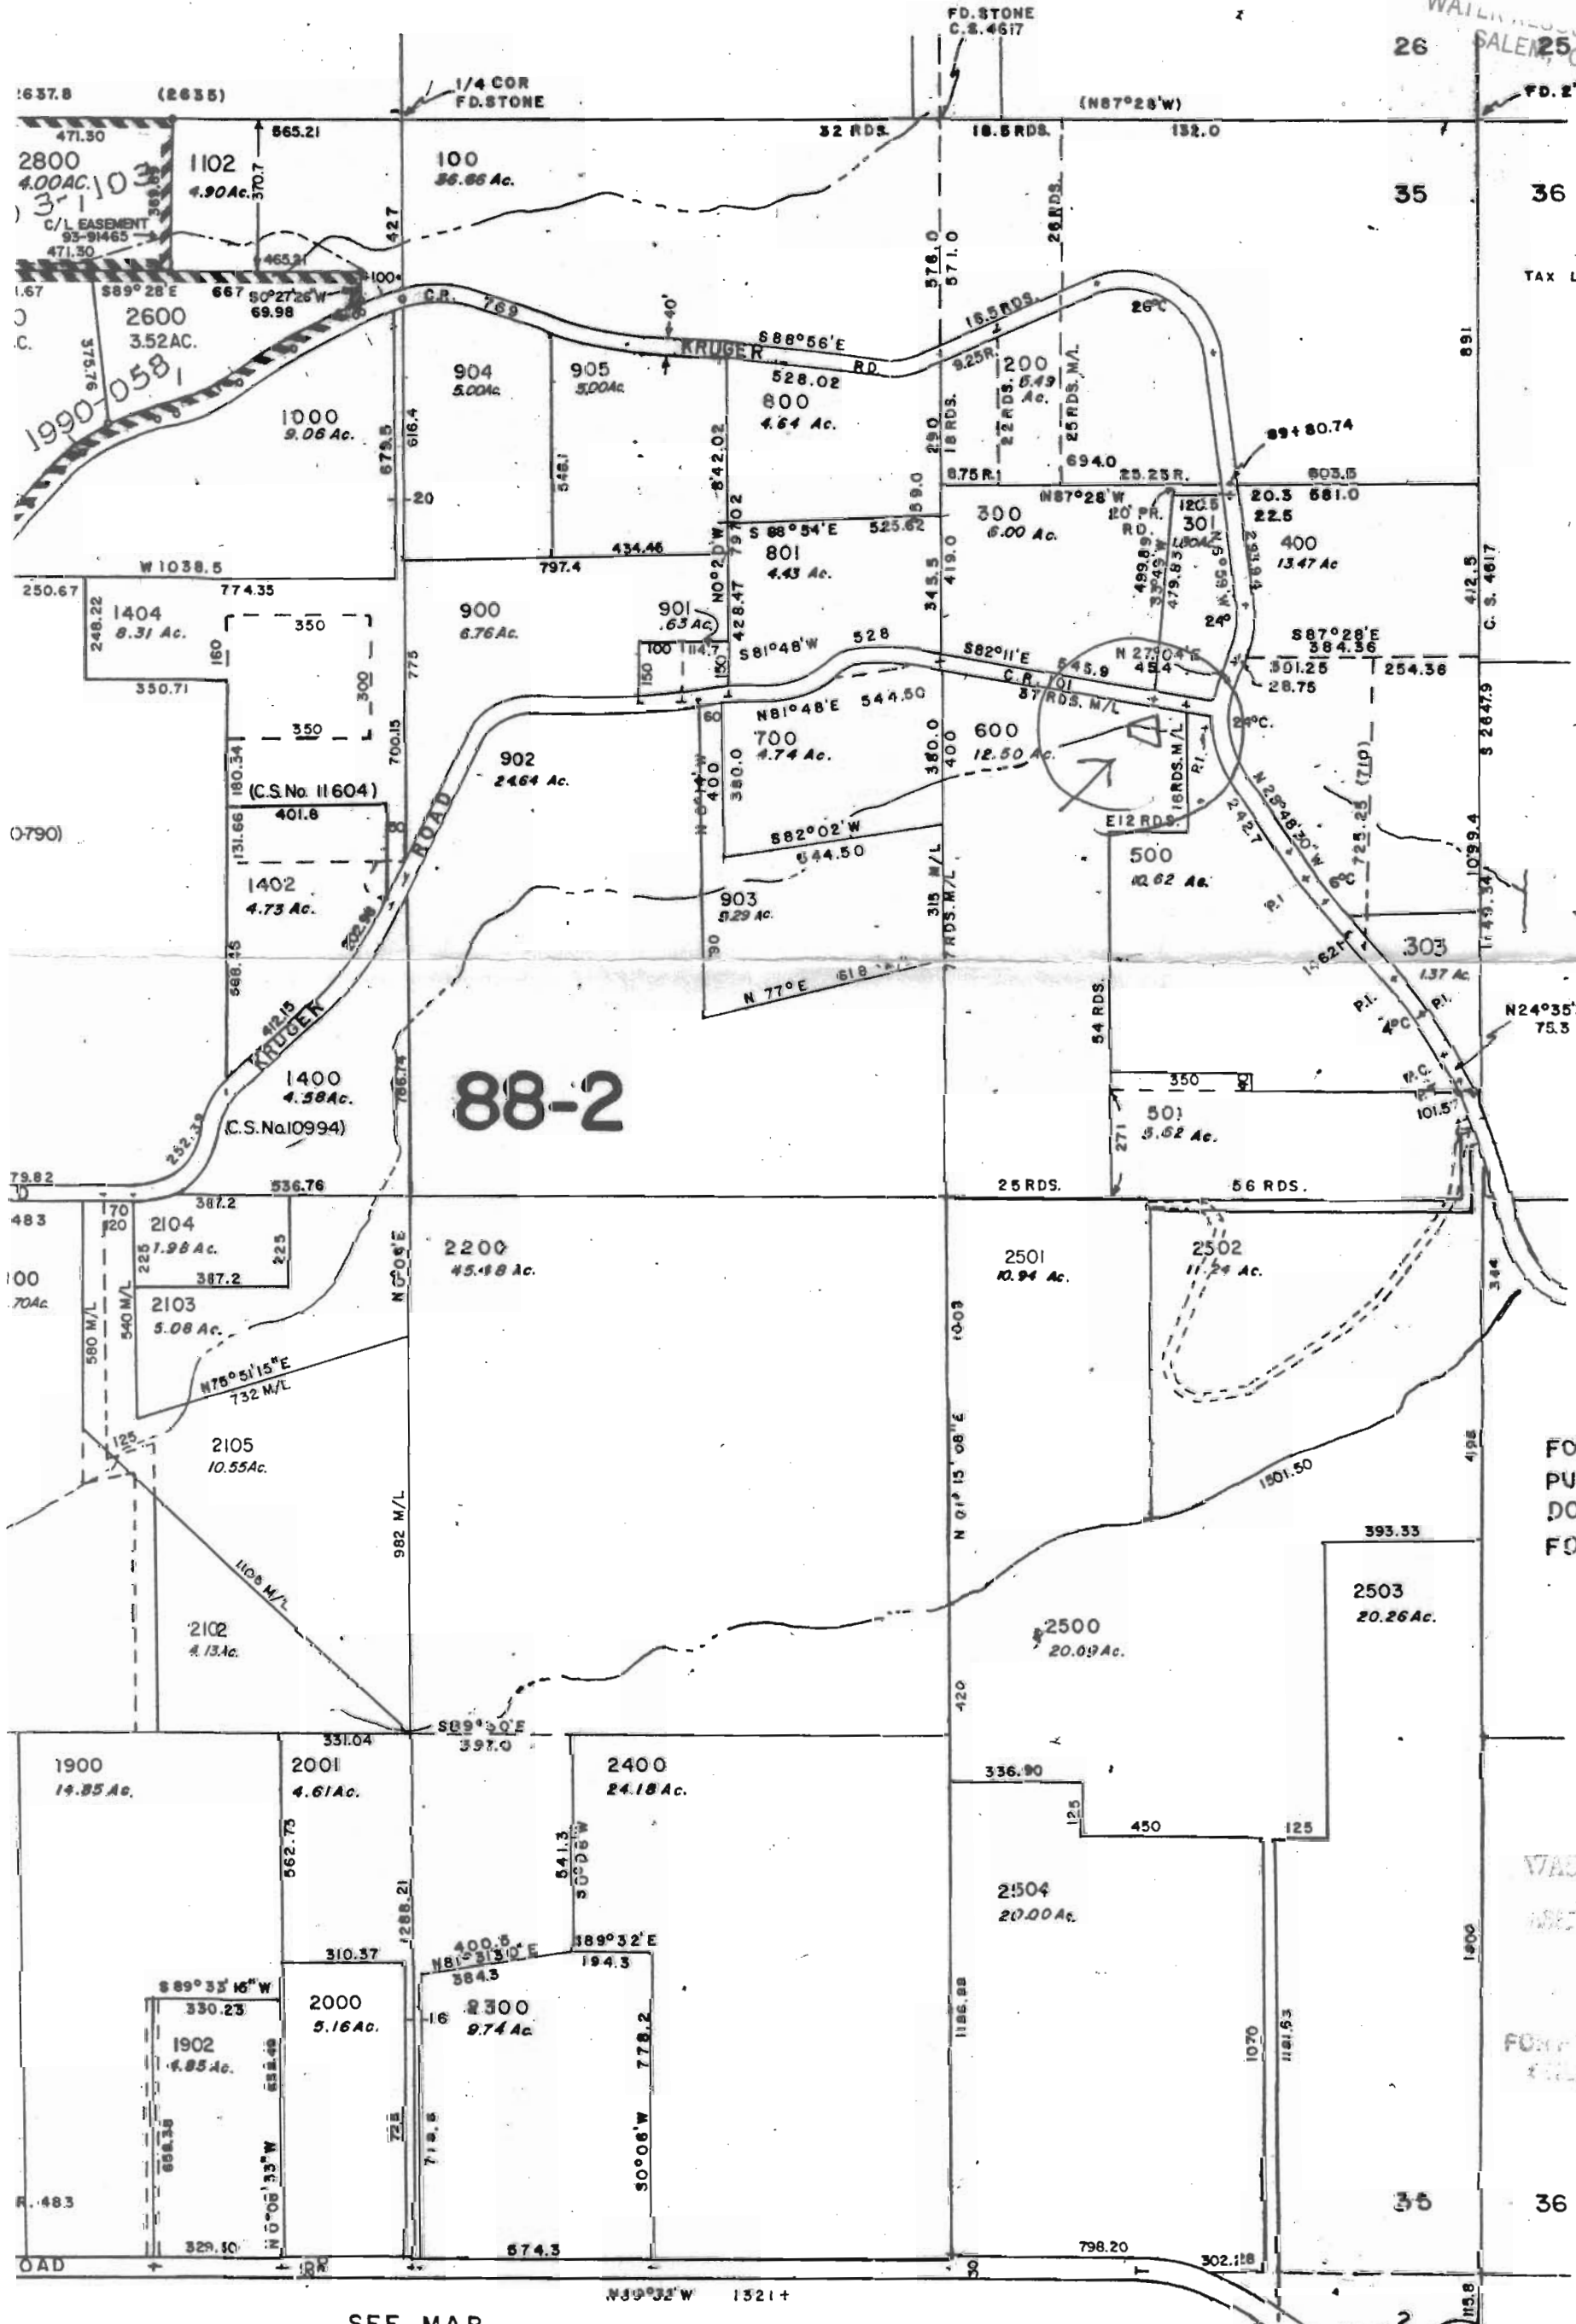

SEE MAP
2S 2 36

FOR ASSESSMENT
PURPOSES ONLY
DO NOT RELY ON
FOR ANY OTHER L

SEE MAP