

RECEIVED

DEC 28 1994


WATER RESOURCES DEP
SALEM, OREGON

SEE MAP

2N 3 10

Application No *R-70128*
Permit No.

"CERTIFICATE NO. 70113"

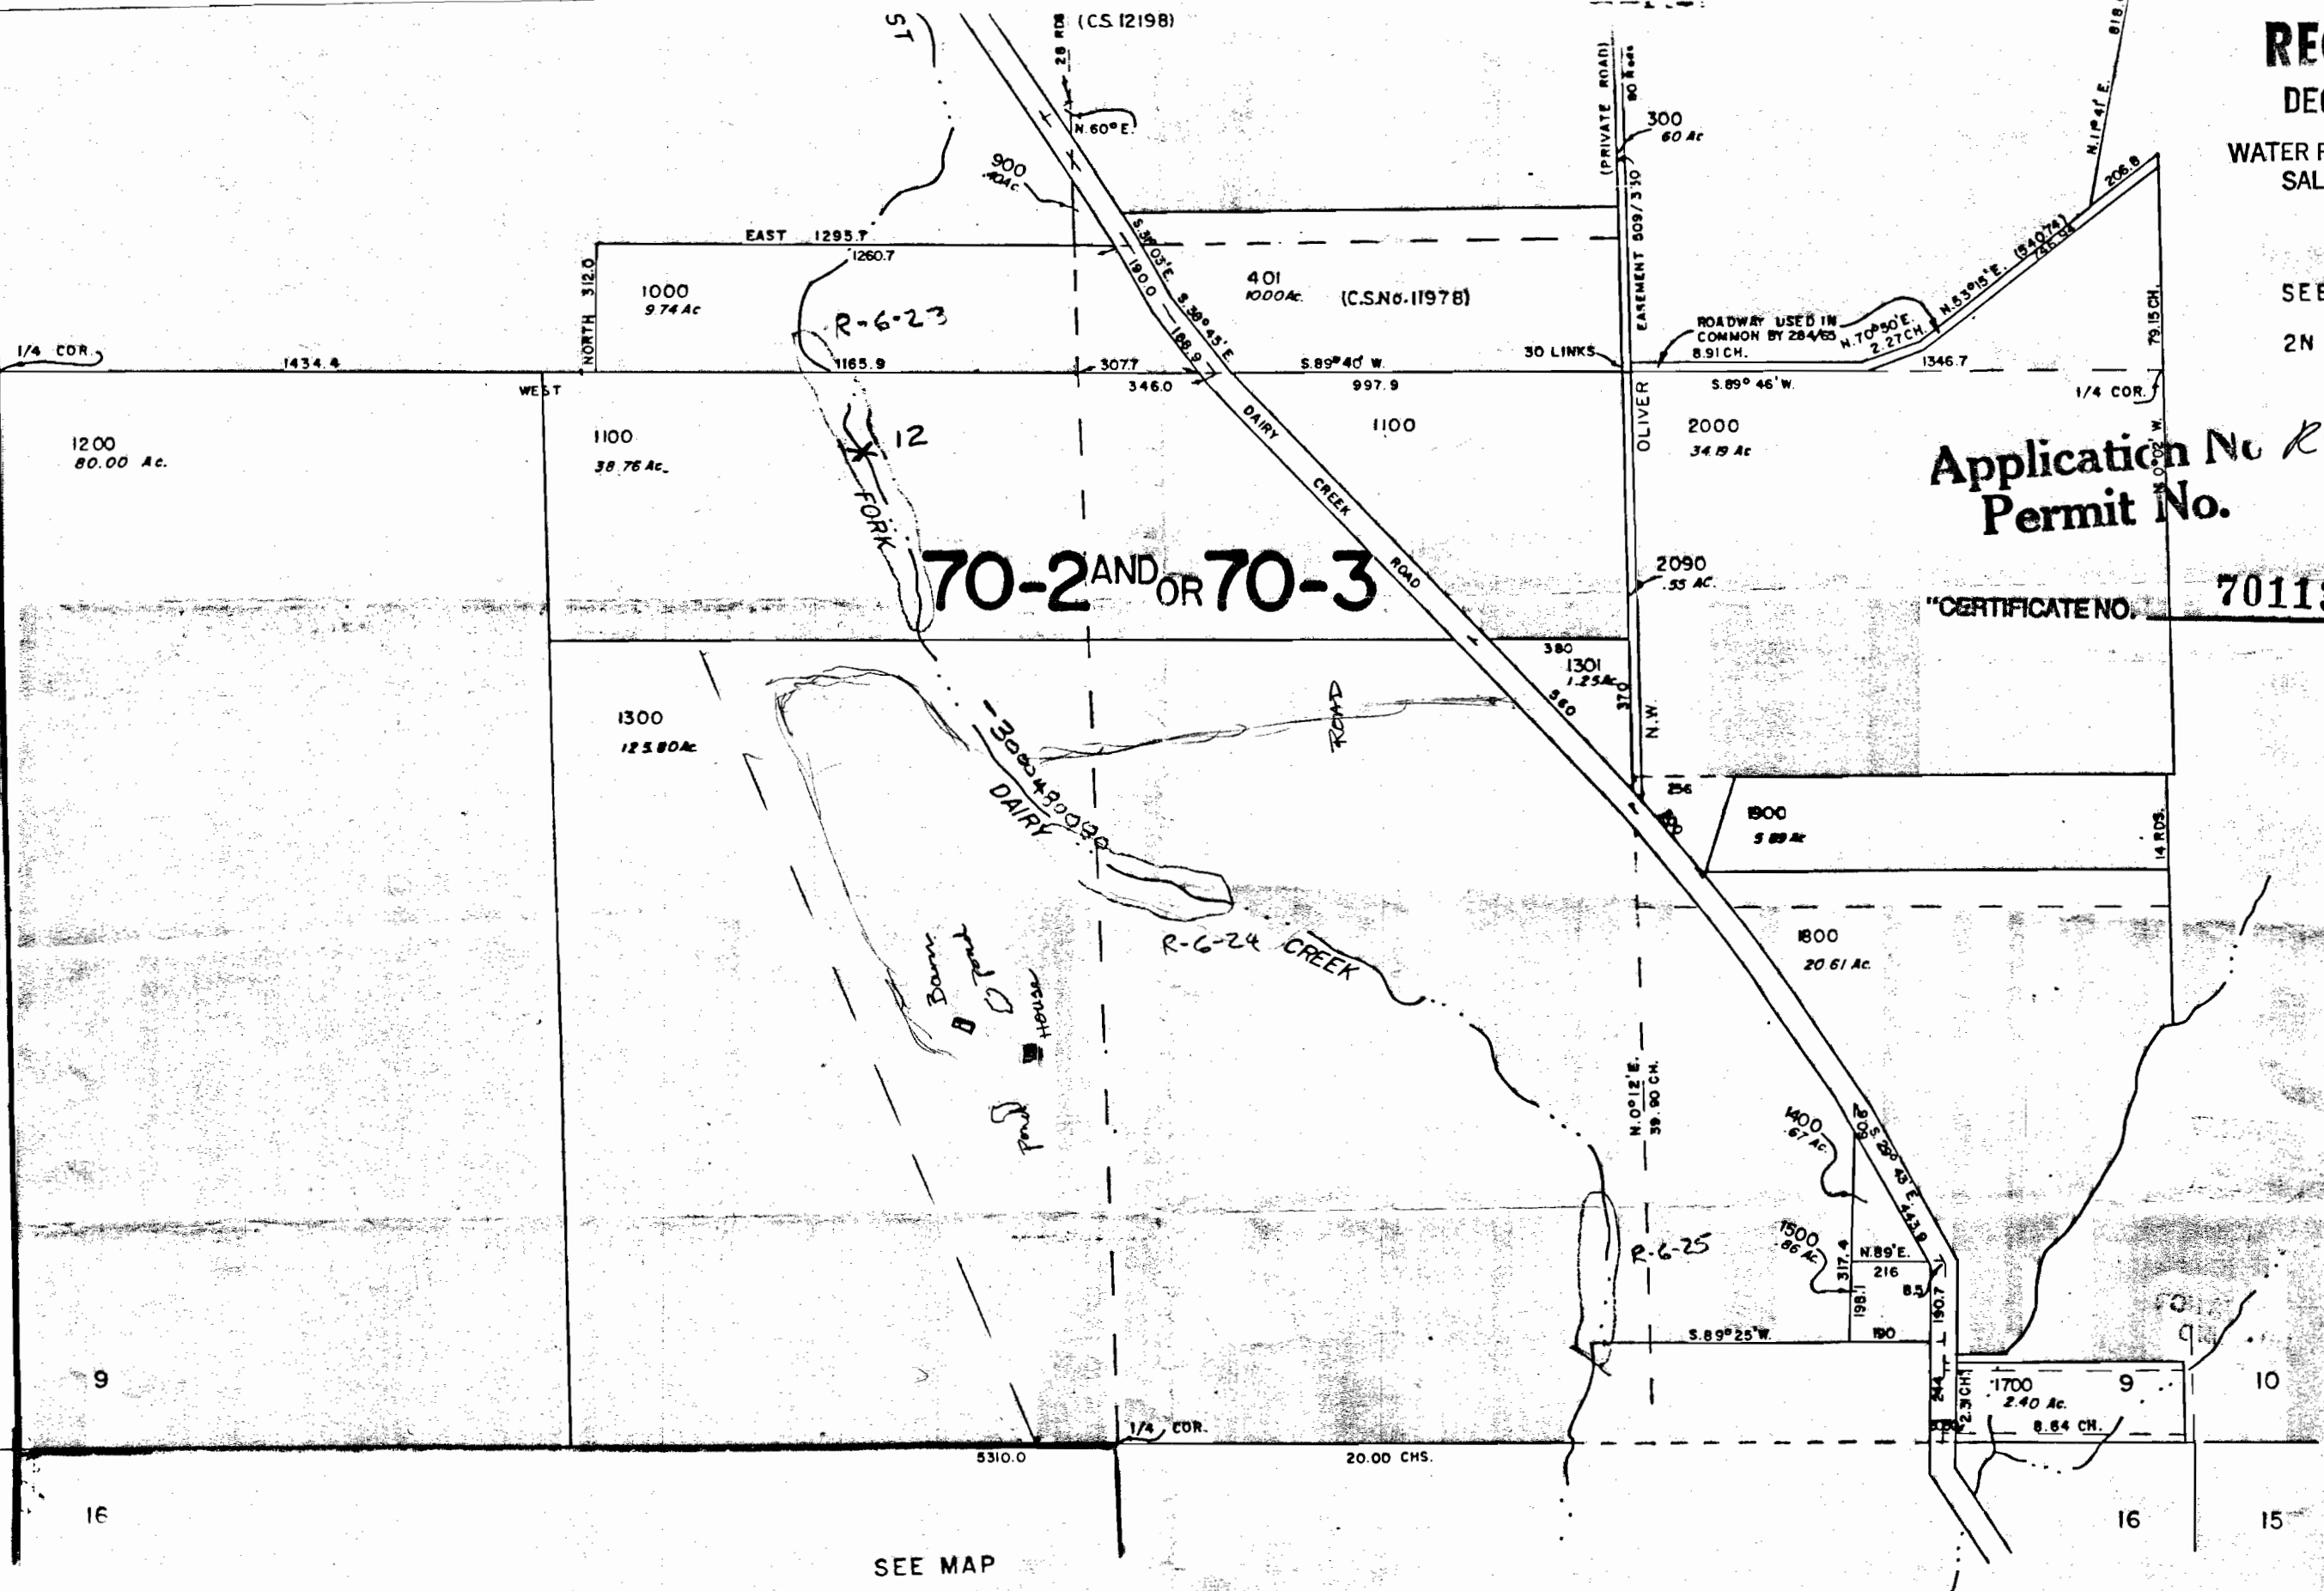

SEE MAP

2N 3 16

2N 3 9