


RECEIVED

DEC 28 1994

WATER RESOURCES DEP
SALEM, OREGON

T. 37 S., R. 6 W., W.M.

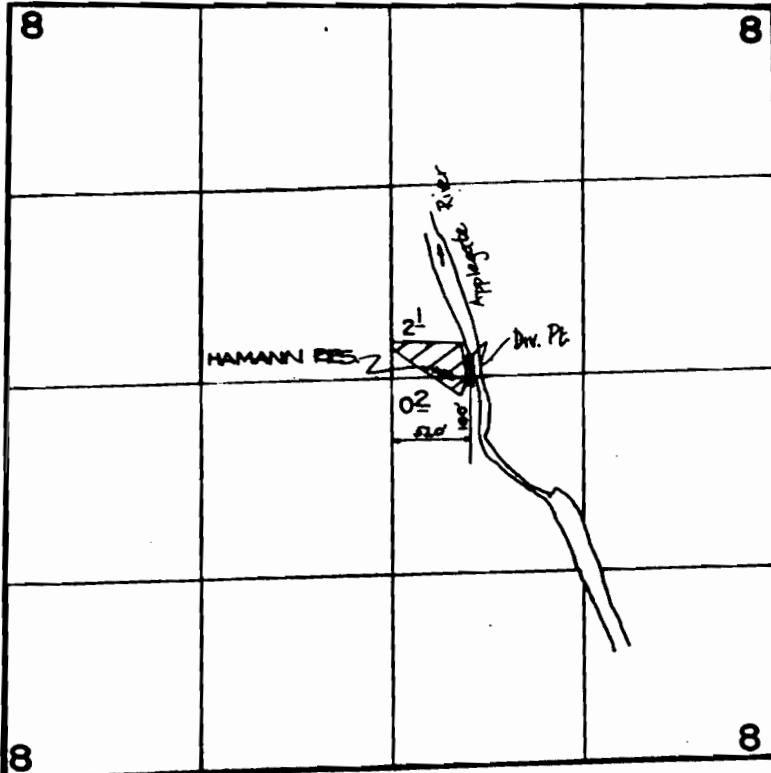

Application No. 60234 R-76129
Permit No.

"CERTIFICATE NO. 70114"

FINAL PROOF SURVEY
UNDER

62198

46076

Application No. 60234 Permit No. 45130

IN NAME OF

DALE B. & EURETHA M. HAMANN

Surveyed OCT. 17, 1983 by B.S. JAMES

RECEIVED

AUG 23 1989

W.M. DIST. 14
GRANTH PASS, OREG.