



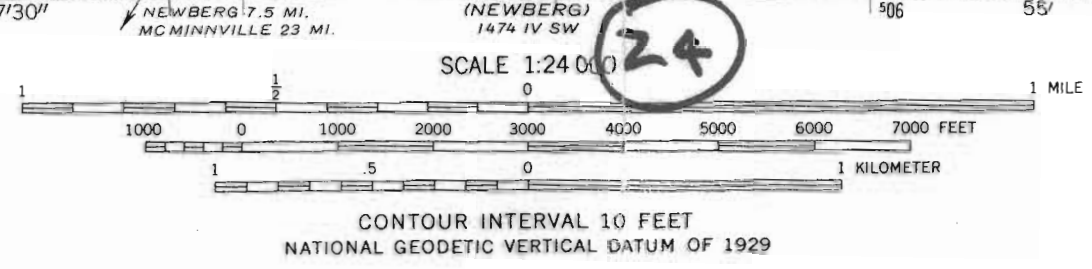

ped, edited, and published by the Geological Survey
 control by USGS, NOS/NOAA, and State of Oregon
 ography from aerial photographs by photogrammetric methods
 ial photographs taken 1952. Field check 1954
 ised from aerial photographs taken 1960. Field check 1961
 yconic projection. 1927 North American datum
 000-foot grid based on Oregon coordinate system, north zone
 00-meter Universal Transverse Mercator grid ticks,
 e 10, shown in blue
 e red dashed lines indicate selected fence lines
 ssions shown in purple compiled from aerial photographs
 n 1970 and 1975. This information not field checked
 edited 1977

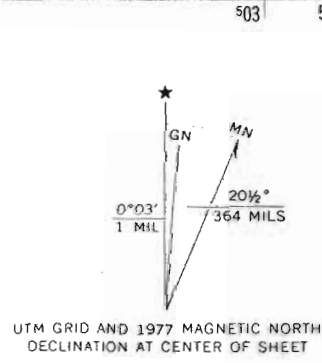

ROAD CLASSIFICATION
 Heavy-duty ————— Light-duty - - - - -
 Medium-duty - - - - - Unimproved dirt - - - - -
 ○ State Route

OREGON
 QUADRANGLE LOCATION

SCHOLLS, OREG.
 NW/4 BEAVERTON 15' QUADRANGLE
 N4522.5—W12252.5/7.5

THIS MAP COMPLIES WITH NATIONAL MAP ACCURACY STANDARDS
 FOR SALE BY U. S. GEOLOGICAL SURVEY, DENVER, COLORADO 80225, OR RESTON, VIRGINIA 22092
 A FOLDER DESCRIBING TOPOGRAPHIC MAPS AND SYMBOLS IS AVAILABLE ON REQUEST

Application No. *R-76138*
 Permit No. *10117*
 1961
 PHOTOREVISED 1970 AND 1977
 AMS 1474 IV NW—SERIES V892