


Application No R-76137
Permit No.

T.I.O.S.R.I.E.W.M.

CERTIFICATE NO.

70117

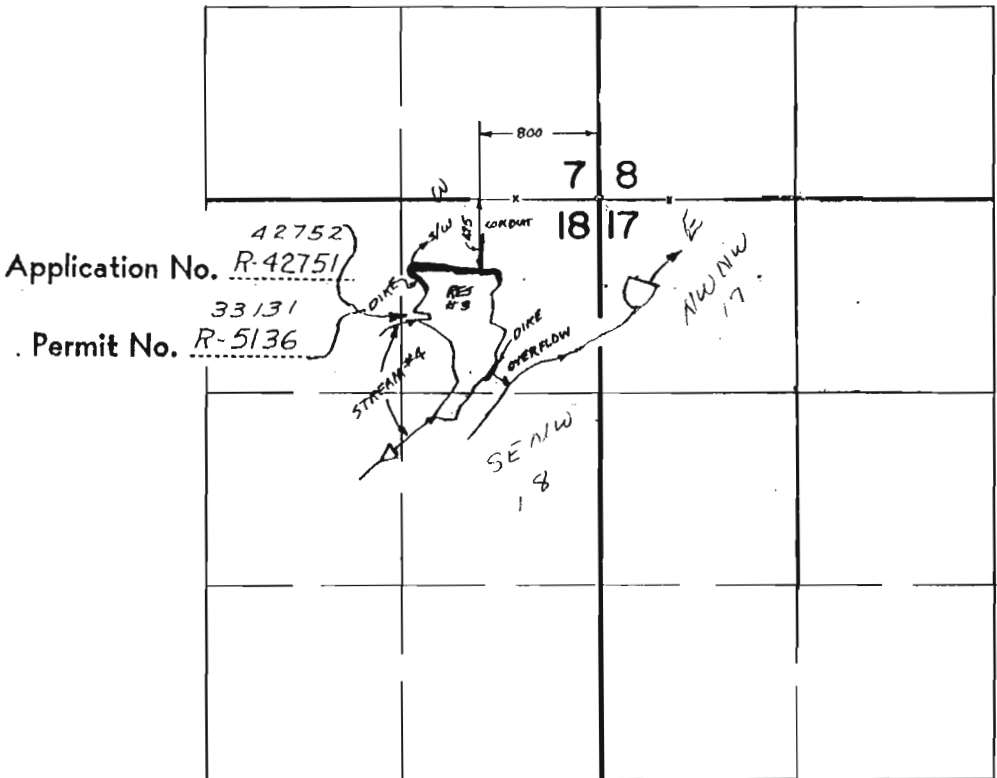

This Application
E. Res. loc. 550'S. & 350'E from NE Cor Sec 18
W. Res. loc. 1770'S & 60'W " " " " "

RECEIVED

DEC 28 1994

WATER RESOURCES DIVISION
SALEM, OREGON

WATER RIGHT MAP FOR
RON BENTZ

Certified Water Right Examiner
229
Larry W. Jebouser
LARRY W. JEBOUSER
Dec. 7, 1989
STATE OF OREGON

THIS MAP WAS PREPARED FOR THE PURPOSE OF IDENTIFYING THE LOCATION OF A WATER RIGHT ONLY AND IS NOT INTENDED TO PROVIDE LEGAL DIMENSIONS OR LOCATION OF PROPERTY OWNERSHIP LINES.