

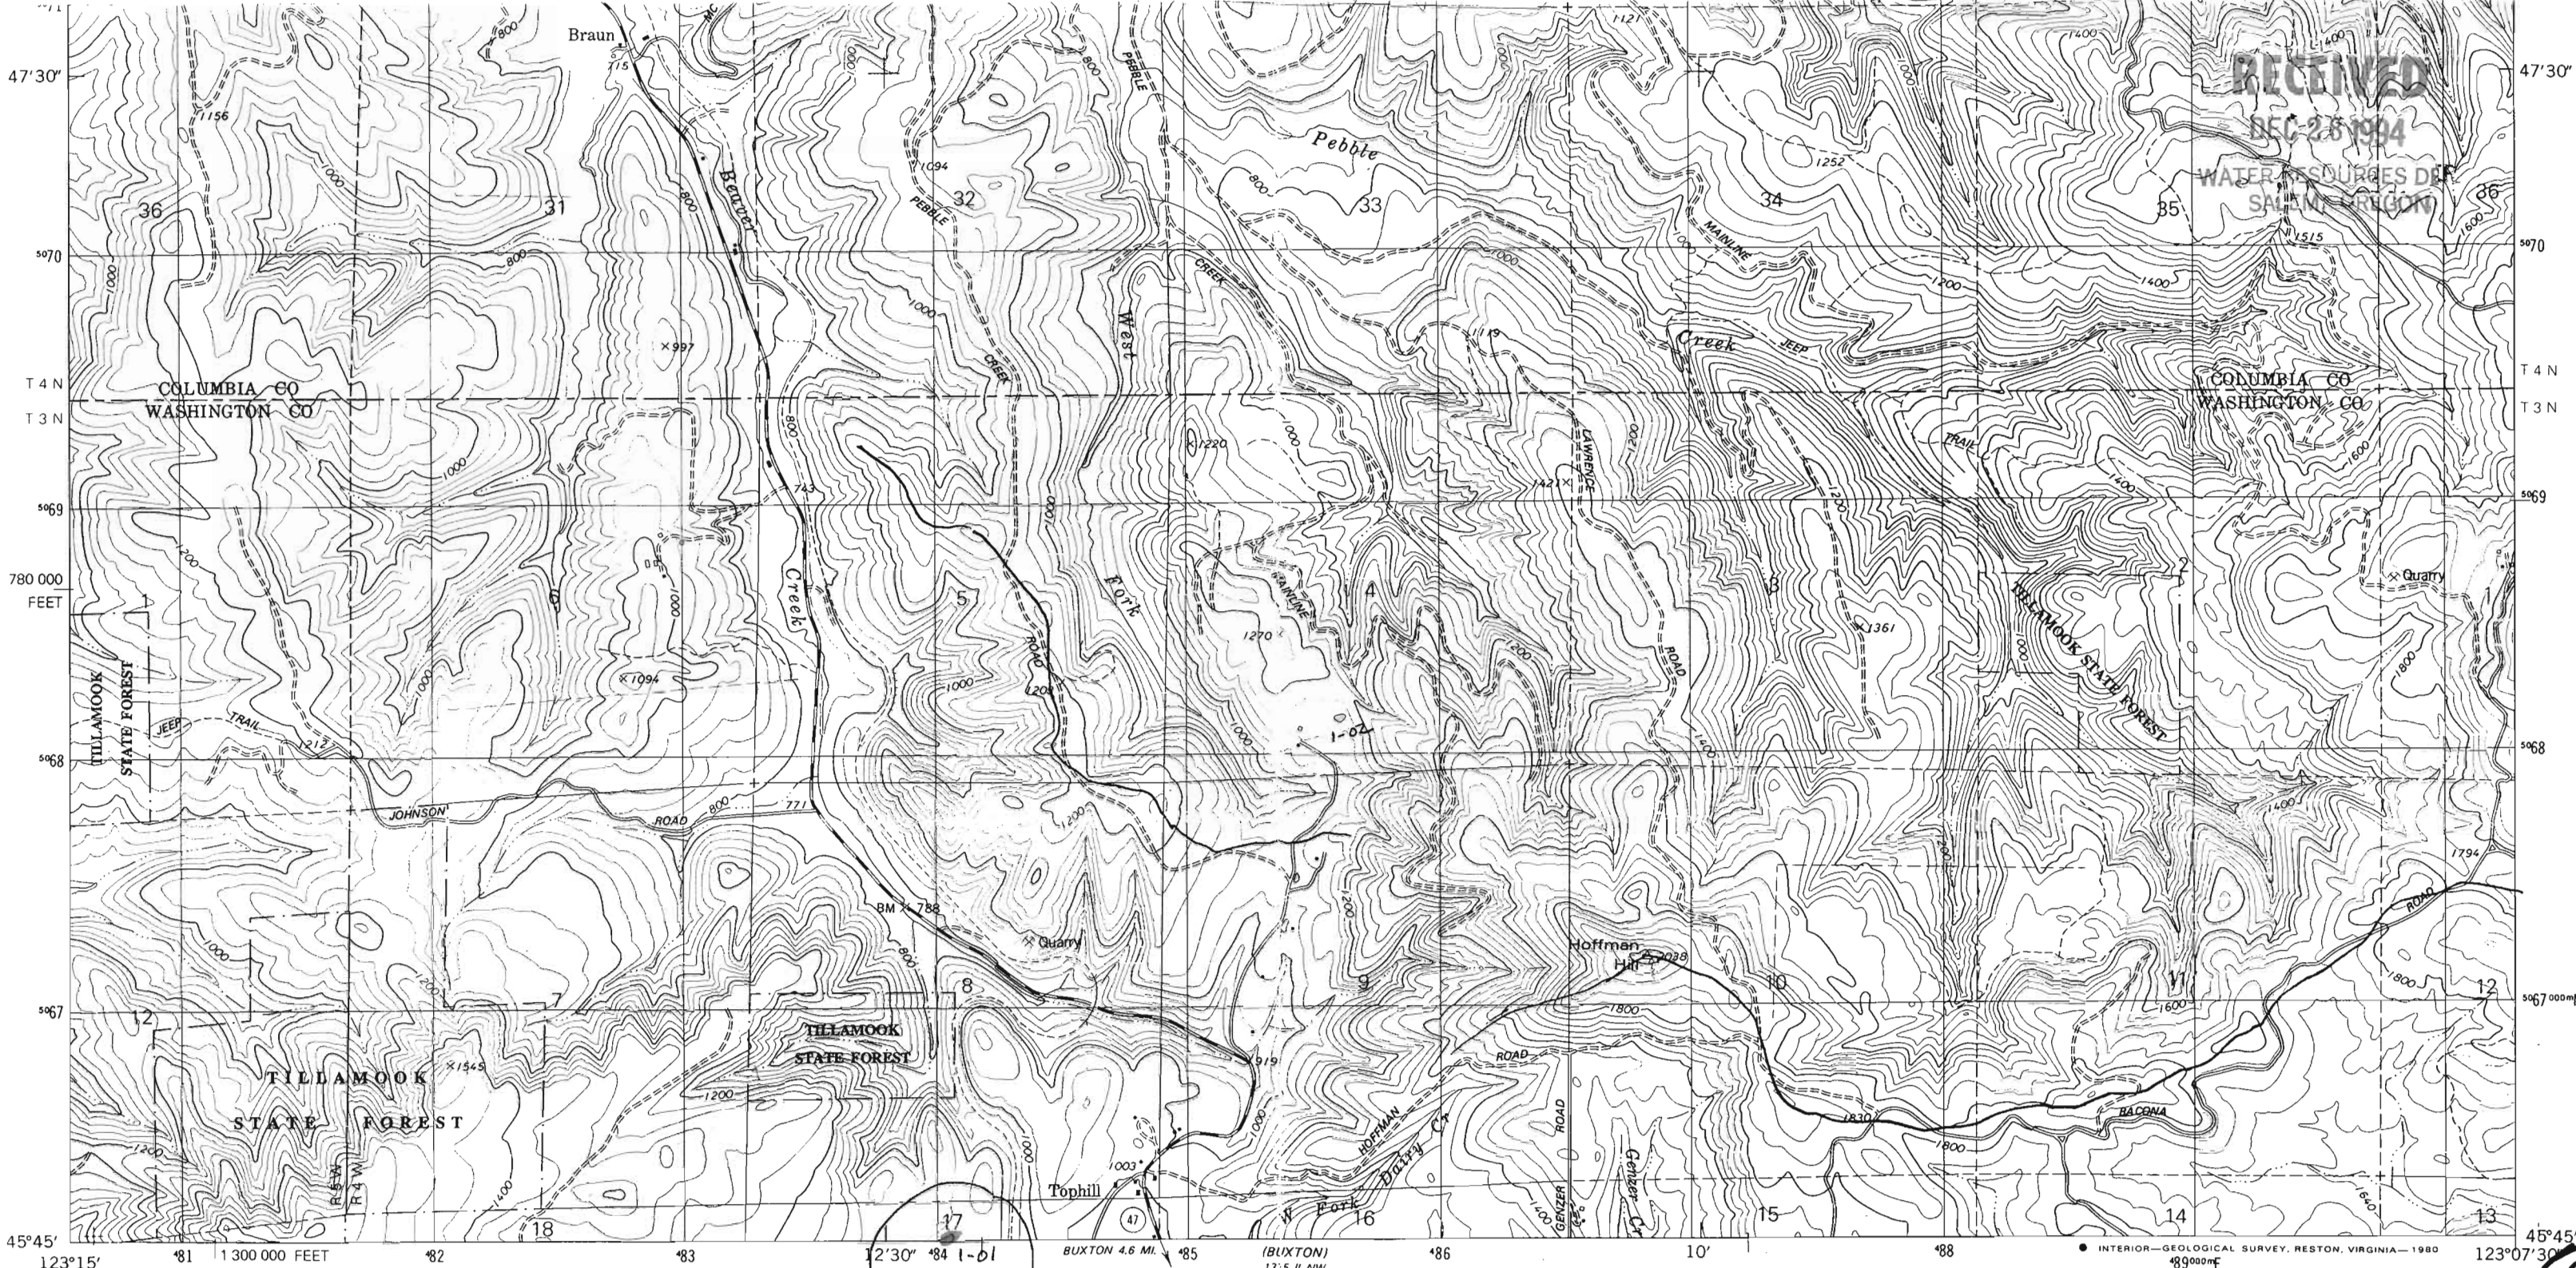


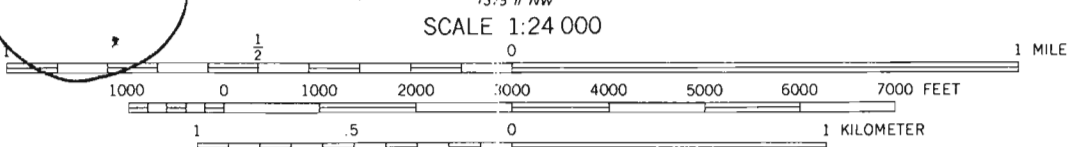

Mapped, edited, and published by the Geological Survey
 Control by USGS and NOS/NOAA
 Topography by photogrammetric methods from aerial
 photographs taken 1973. Field checked 1974
 Map edited 1979
 Projection and 10,000-foot grid ticks: Oregon coordinate
 system, north zone (Lambert conformal conic)
 1000-meter Universal Transverse Mercator grid, zone 10
 1927 North American datum
 To place on the predicted North American Datum 1983
 move the projection lines 23 meters north and
 95 meters east as shown by dashed corner ticks
 Fine red dashed lines indicate selected fence and field lines where
 generally visible on aerial photographs. This information is unchecked
 There may be private inholdings within the boundaries of
 the National or State reservations shown on this map

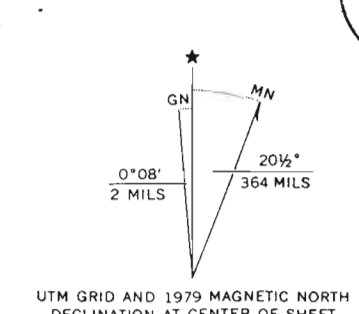

CONTOUR INTERVAL 40 FEET
 DOTTED LINES REPRESENT 20-FOOT CONTOURS
 NATIONAL GEODETIC VERTICAL DATUM OF 1929

5



ROAD CLASSIFICATION
 Primary highway, hard surface
 Secondary highway, hard surface
 Light-duty road, hard or improved surface
 Unimproved road
 Interstate Route
 U. S. Route
 State Route

FOR SALE BY U. S. GEOLOGICAL SURVEY, DENVER, COLORADO 80225, OR RESTON, VIRGINIA 22092
 A FOLDER DESCRIBING TOPOGRAPHIC MAPS AND SYMBOLS IS AVAILABLE ON REQUEST

Application No R-74140
 Permit No.

VERNONIA, OREG.
 SW/4 VERNONIA 15' QUADRANGLE
 N4545-W12307.5/7.5
 1979
 DMA 1375 I SW-SERIES V892
 "CERTIFICATE NO. 70121"

UNITED STATES
DEPARTMENT OF THE INTERIOR
GEOLOGICAL SURVEY




Application No. *R-74140* 1979
Permit No. _____

CERTIFICATE NO. *70121*

BUXTON QUADRANGLE
OREGON—WASHINGTON CO.
7.5 MINUTE SERIES (TOPOGRAPHIC)
NW/4 FOREST GROVE 15' QUADRANGLE

1375 1 SE
BACONA

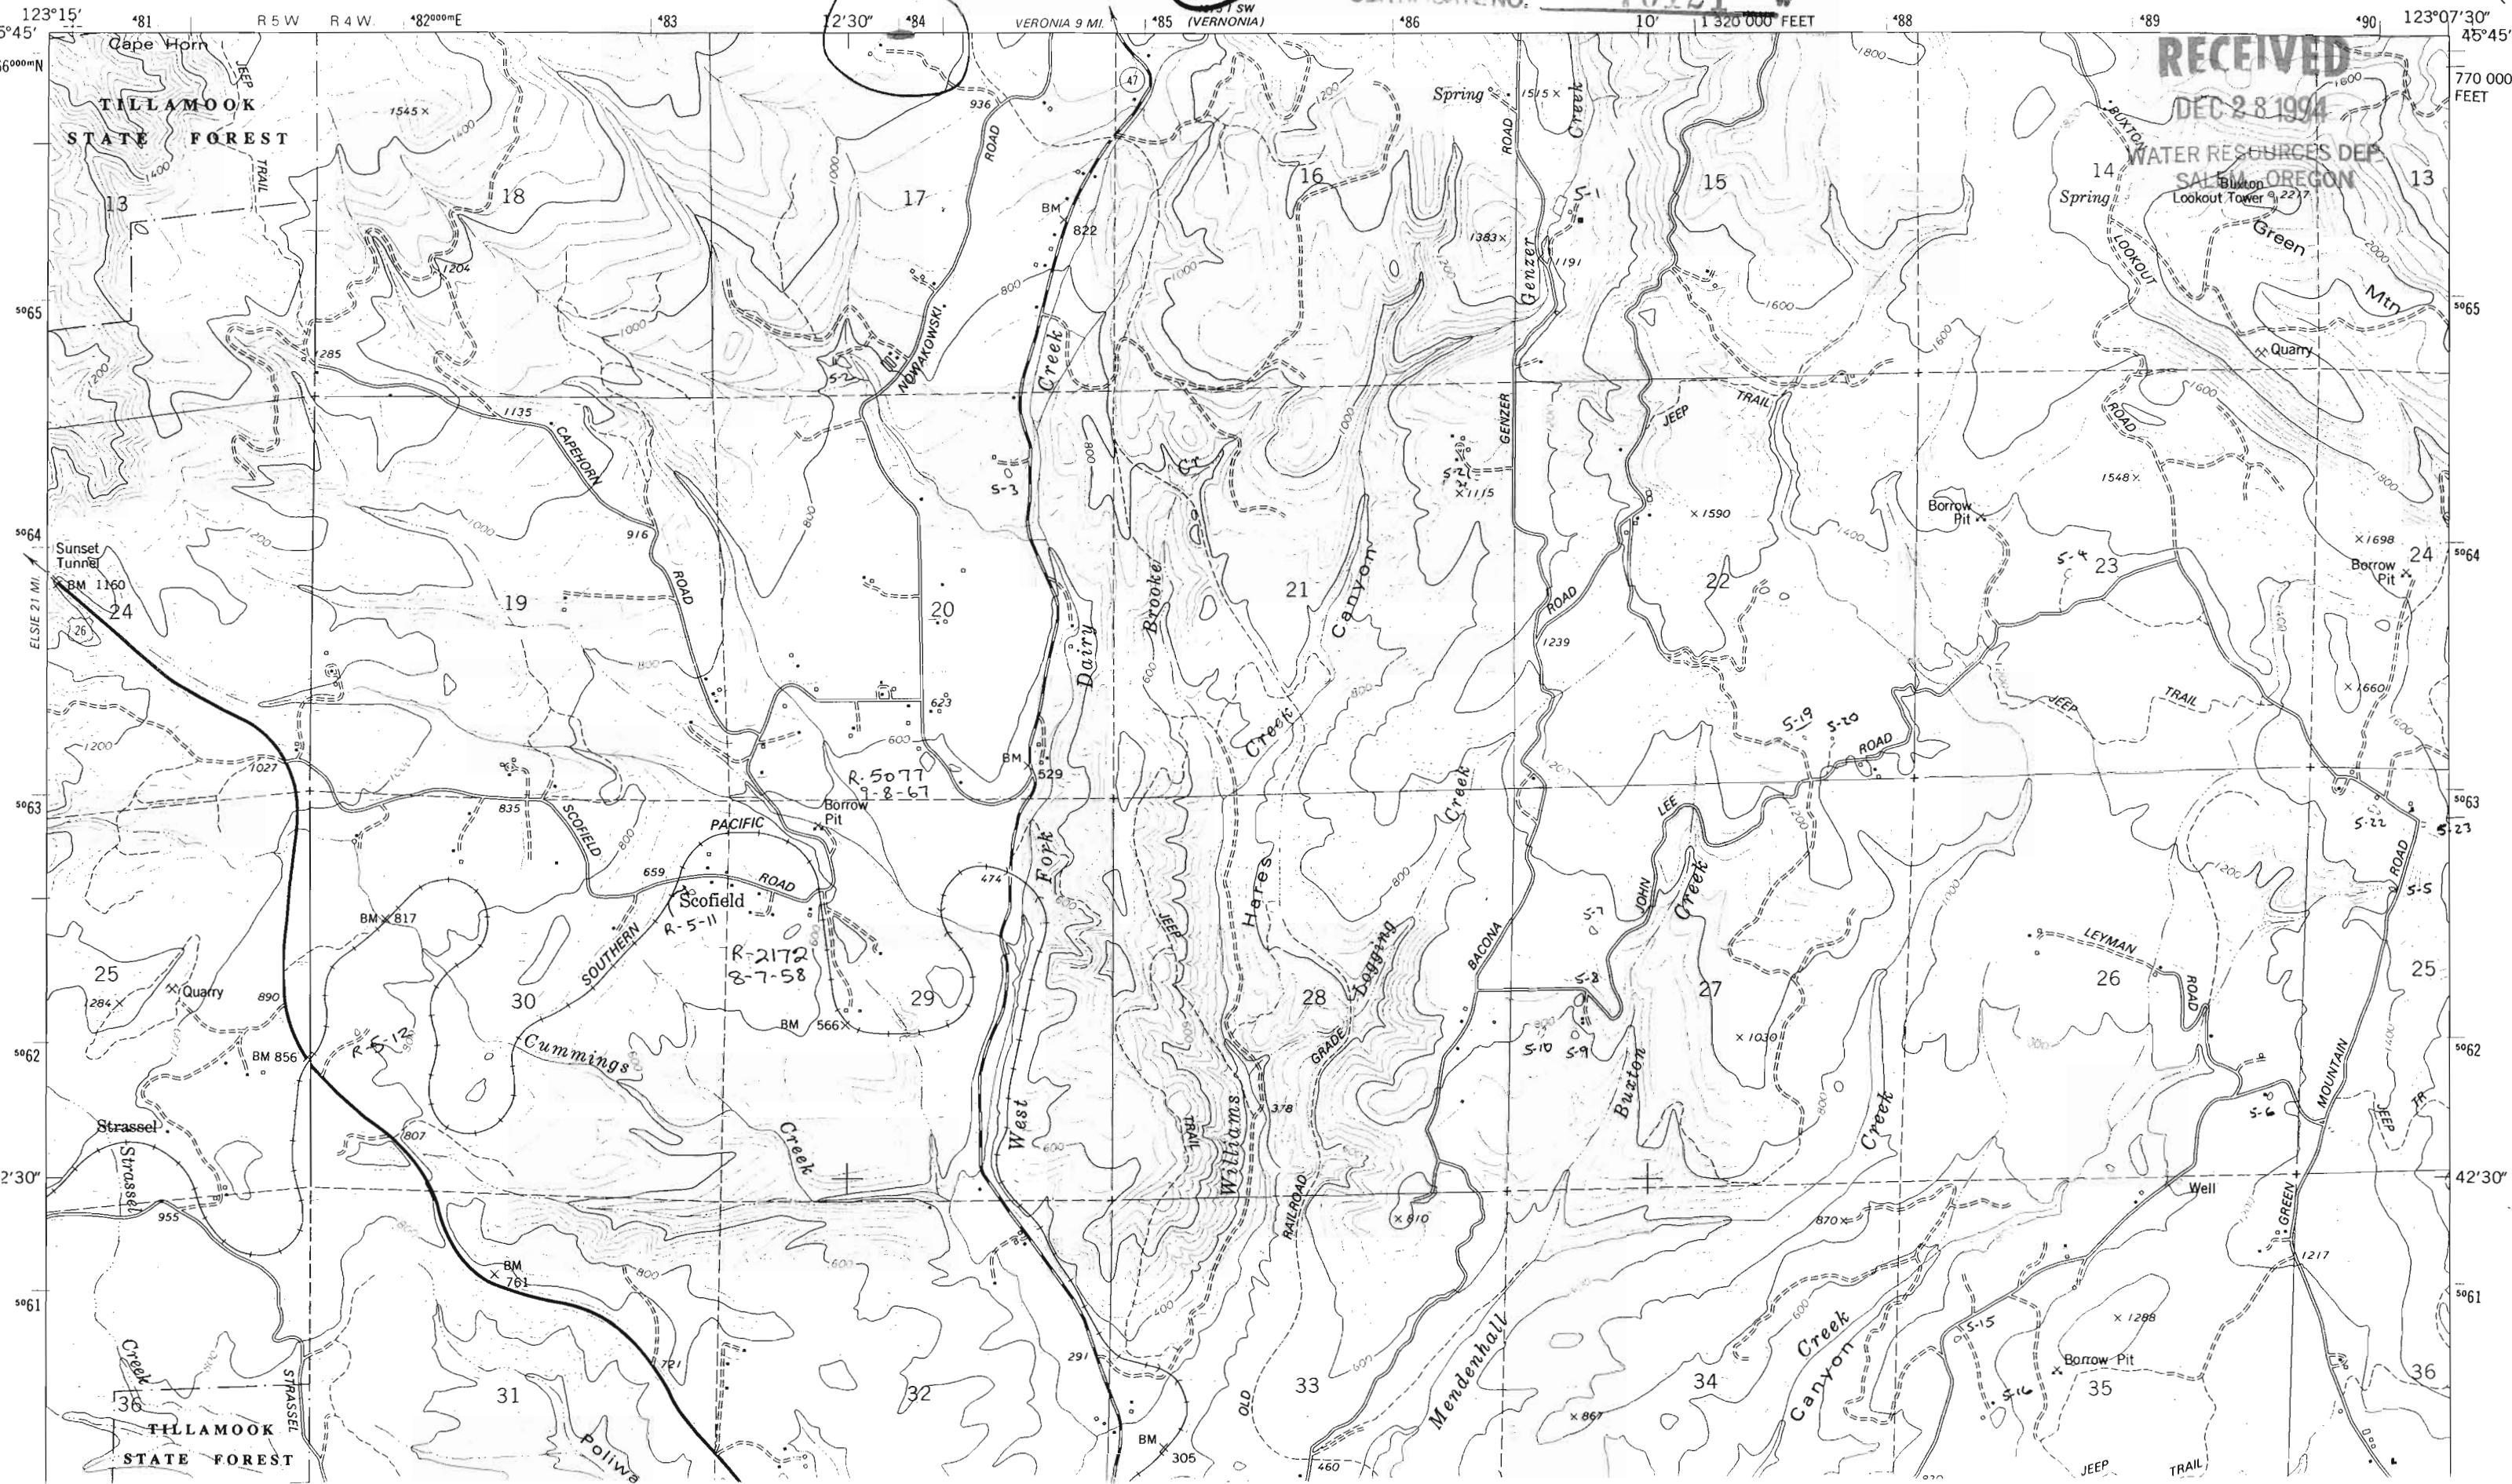

JOHNSON
2200
237.01 Ac.

Application No
Permit No.

R-76140

RECEIVED

DEC 28 1994

WATER RESOURCES DEP.
SALEM, OREGON

"CERTIFICATE NO. 70121"

1/4 COR.

2400
623.78 Ac. (CS.No.11645)

2600
79.08 Ac.

2700
60.0 Ac.

2800
114.23 Ac.
2800-MI

13-11
AND OR
13-14

5500
100.01 Ac.

5800
134.69 Ac.

5701
44.70 Ac.

5702
41.80 Ac.

6800
160.0 Ac.

5700
62.18 Ac.

5900
21.0 Ac.
CS. 7568
860.4

6005
10.35 Ac.

6105
8.30 Ac.

6102
5.25 Ac.

6104
5.25 Ac.

6100
10.25 Ac.

6107
12.25 Ac.

6000
1.00 Ac.

6003
1.27 Ac.

6004
2.00 Ac.

6501
7.40 Ac.

6500
7.40 Ac.

6300
10.07 Ac.

6301
21.00 Ac.

6302
7.0 Ac.

6101
2.18 Ac.

6103
2.05 Ac.

6200
34.00 Ac.

6201
1.00 Ac.

6202
1.00 Ac.

6203
1.00 Ac.

6204
1.00 Ac.

6400
2.70 Ac.

6401
2.70 Ac.



FOR ASSESSMENT PURPOSES ONLY
DO NOT RELY ON FOR ANY OTHER USE

3N 4 B