

1" = 400'

Application No. R-76142
Permit No.


RECEIVED

JAN 28 1996



WATER DIVISION
SALEM, OREGON

See Map 13 IE 17

"CERTIFICATE NO. 70122"

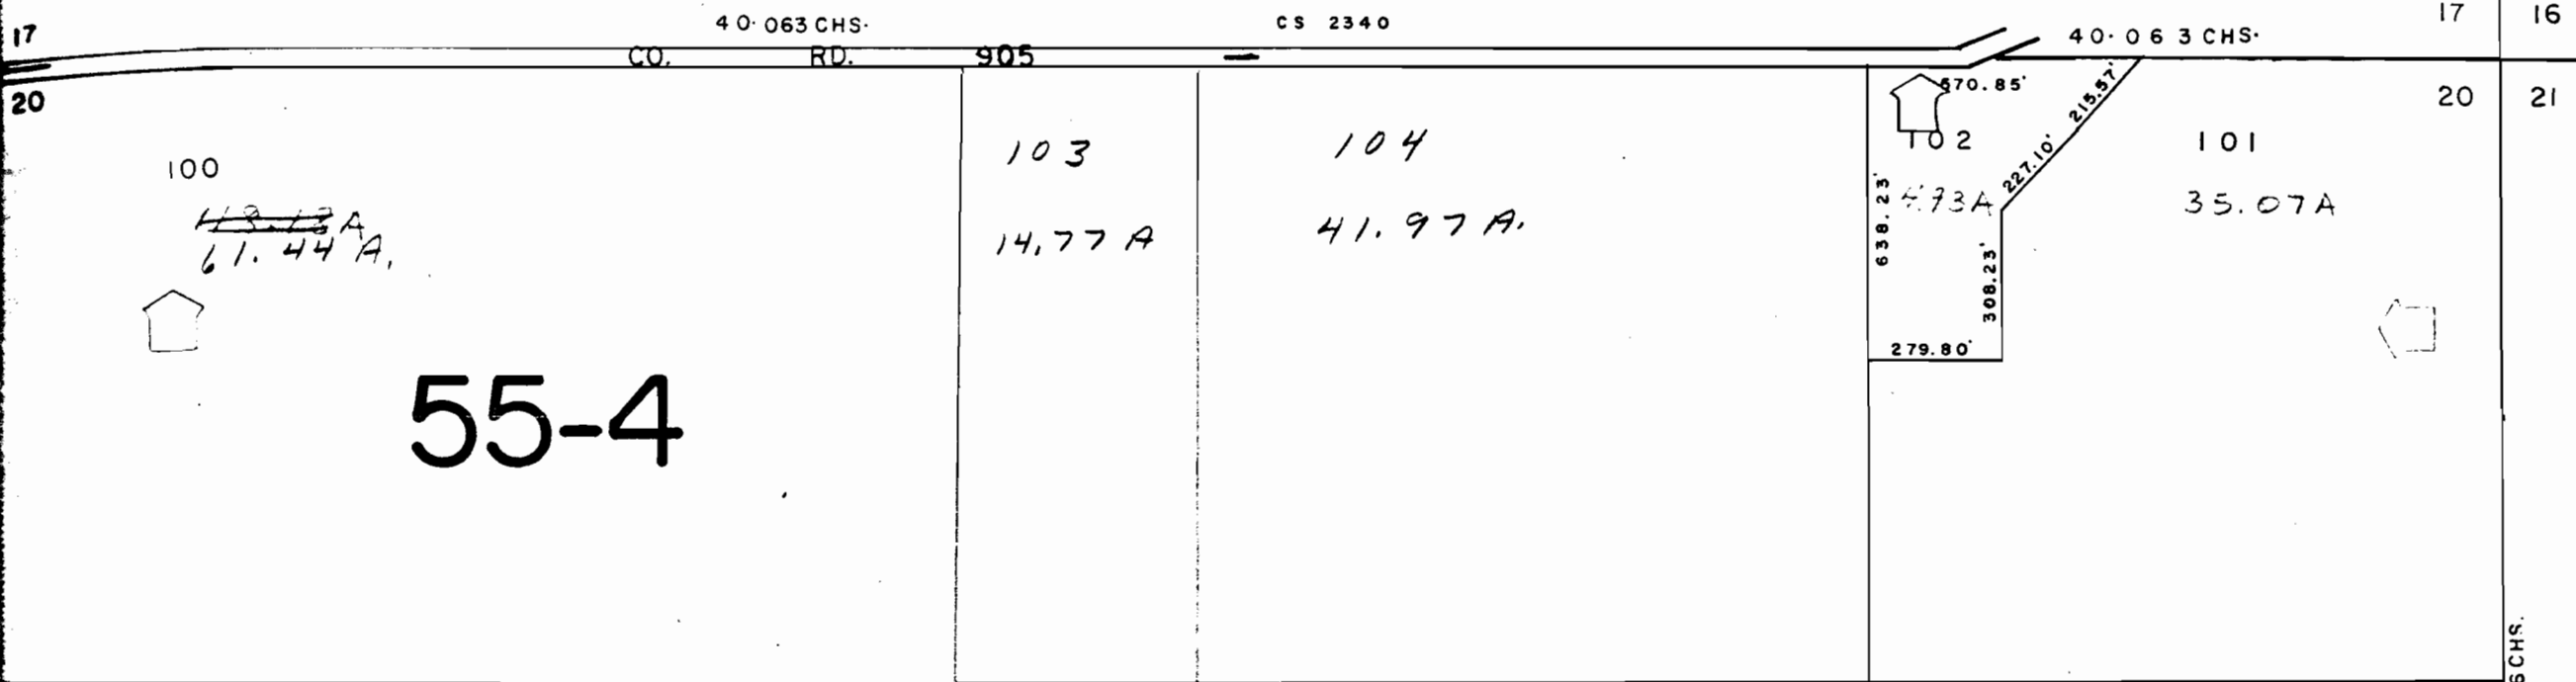

55-4

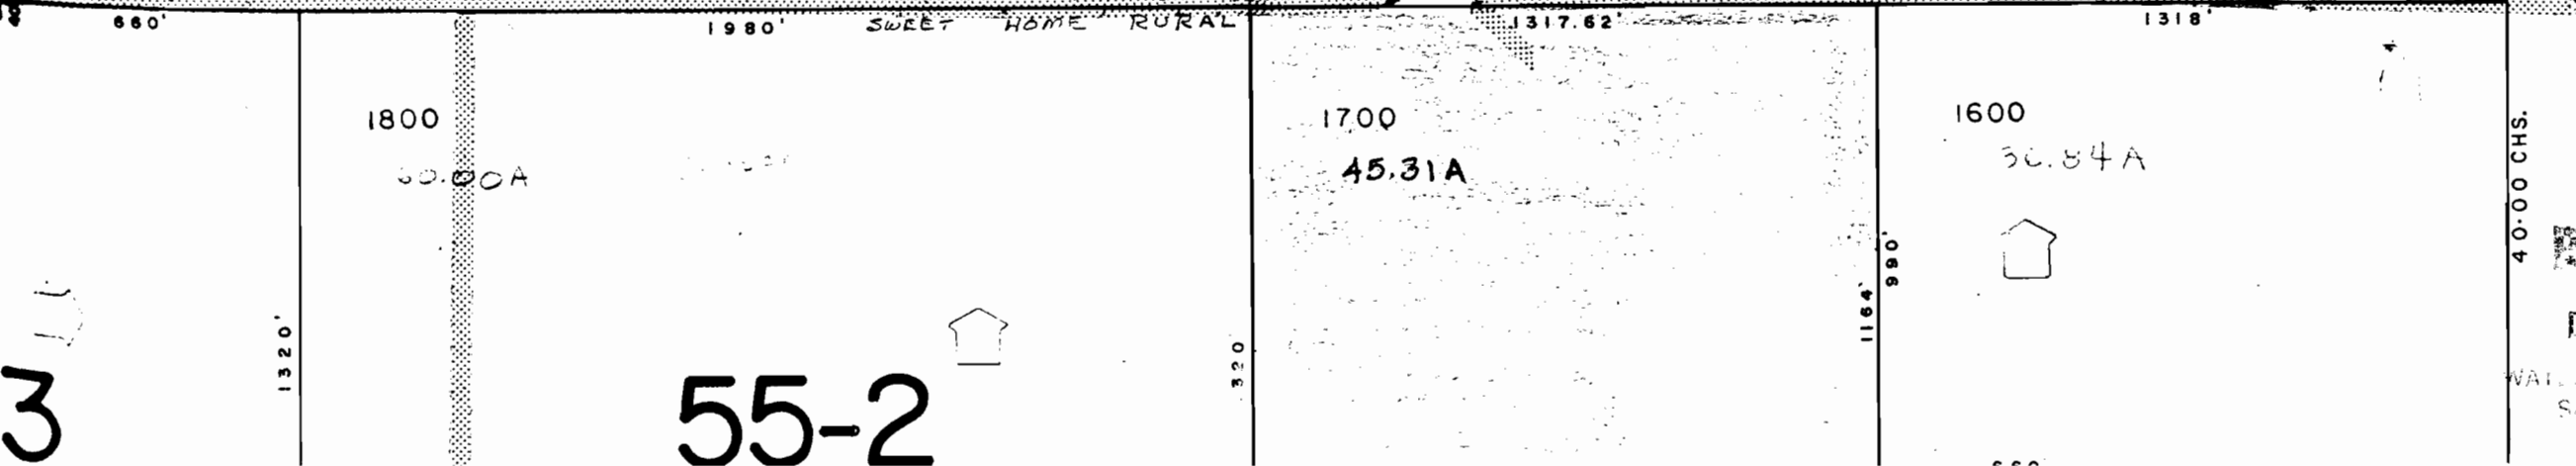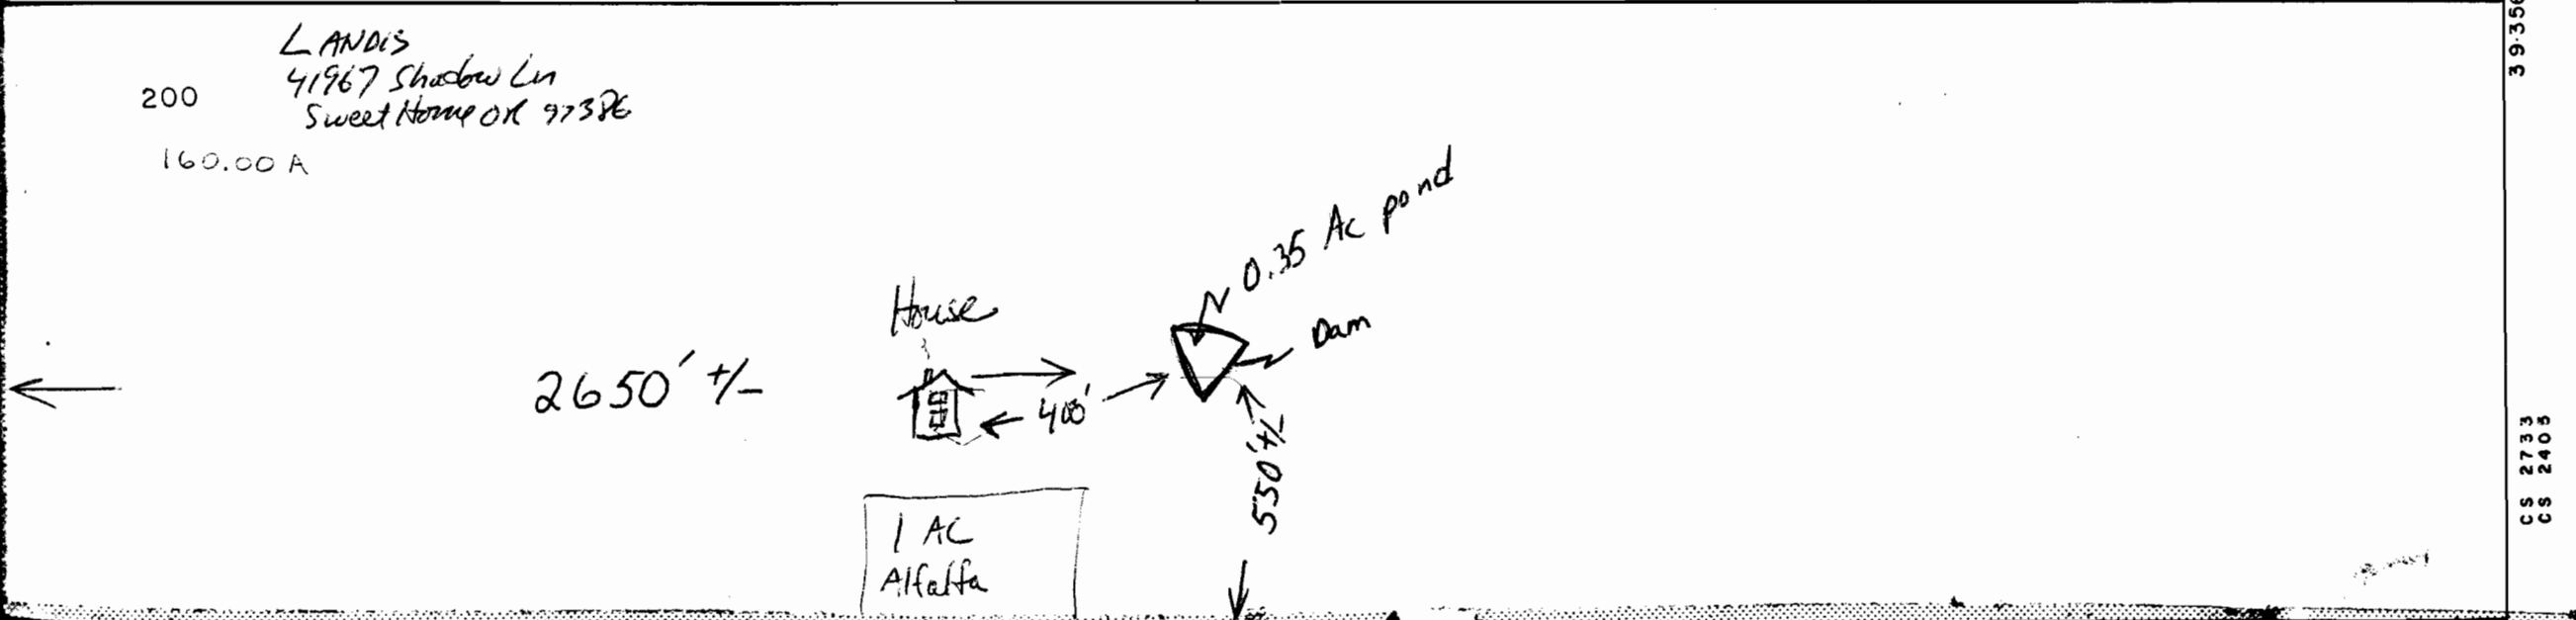

55-2

See Map 13 IE 21

RECEIVED

DEC 28 1994

WATER DIVISION
SALEM, OREGON