


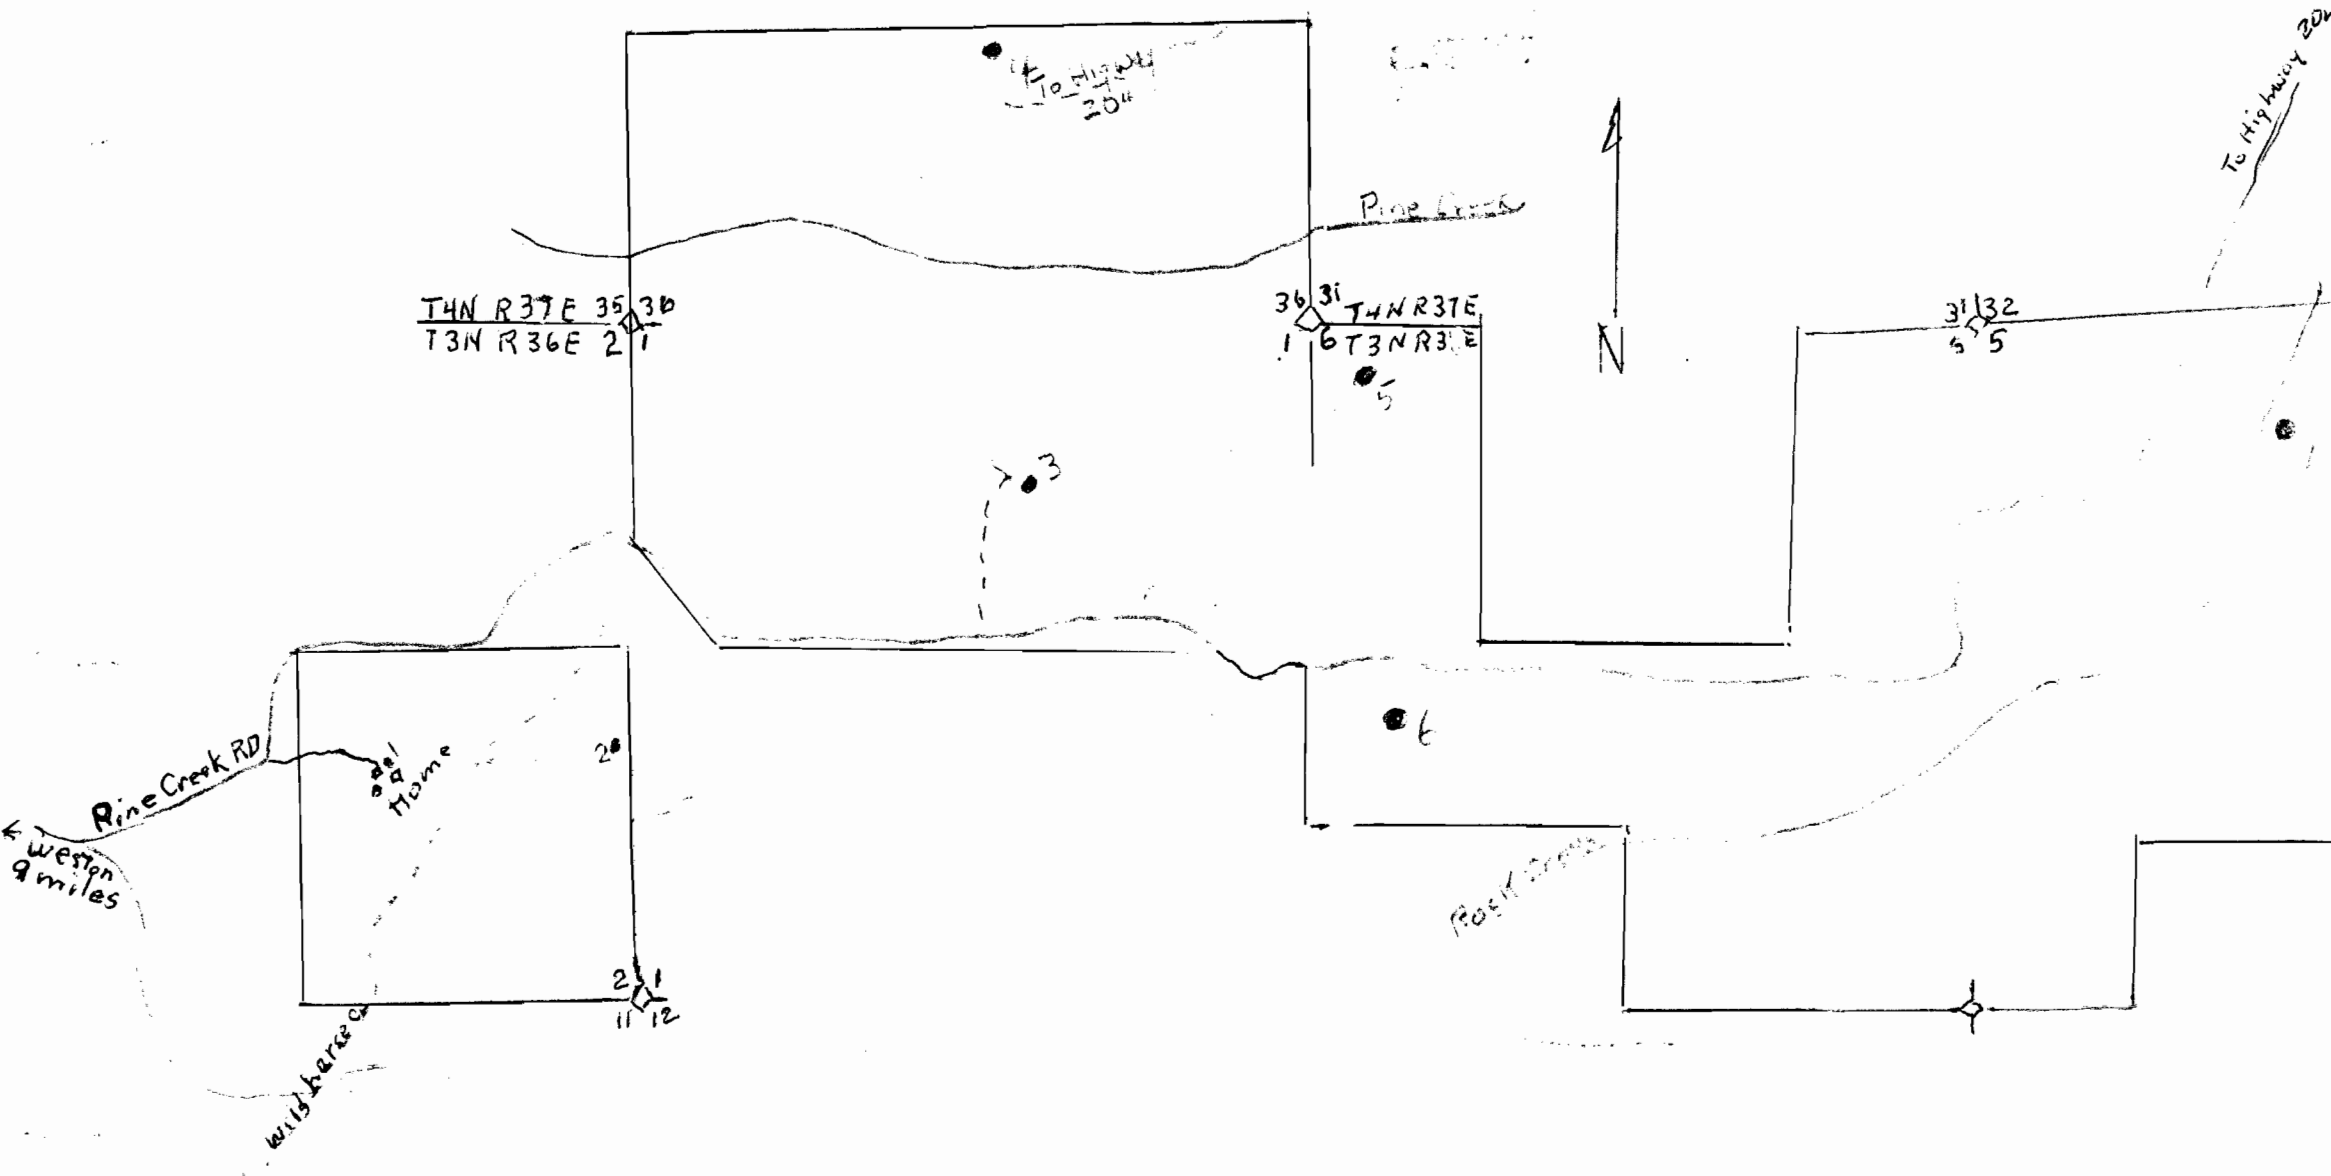

Pond + Number in Red 6
 Darran Ranch Mountain Pasture
 11 miles SE of Weston OR

SCALE - 3/4 to 1 mile

DEC 2 1994

Application No. A-74143
 Permit No.

CERTIFICATE NO. 70123