


7.5 MINUTE SERIES (TOPOGRAPHIC)

NW/4 FOREST GROVE 15' QUADRANGLE

1376 15' (BACONA) **2**

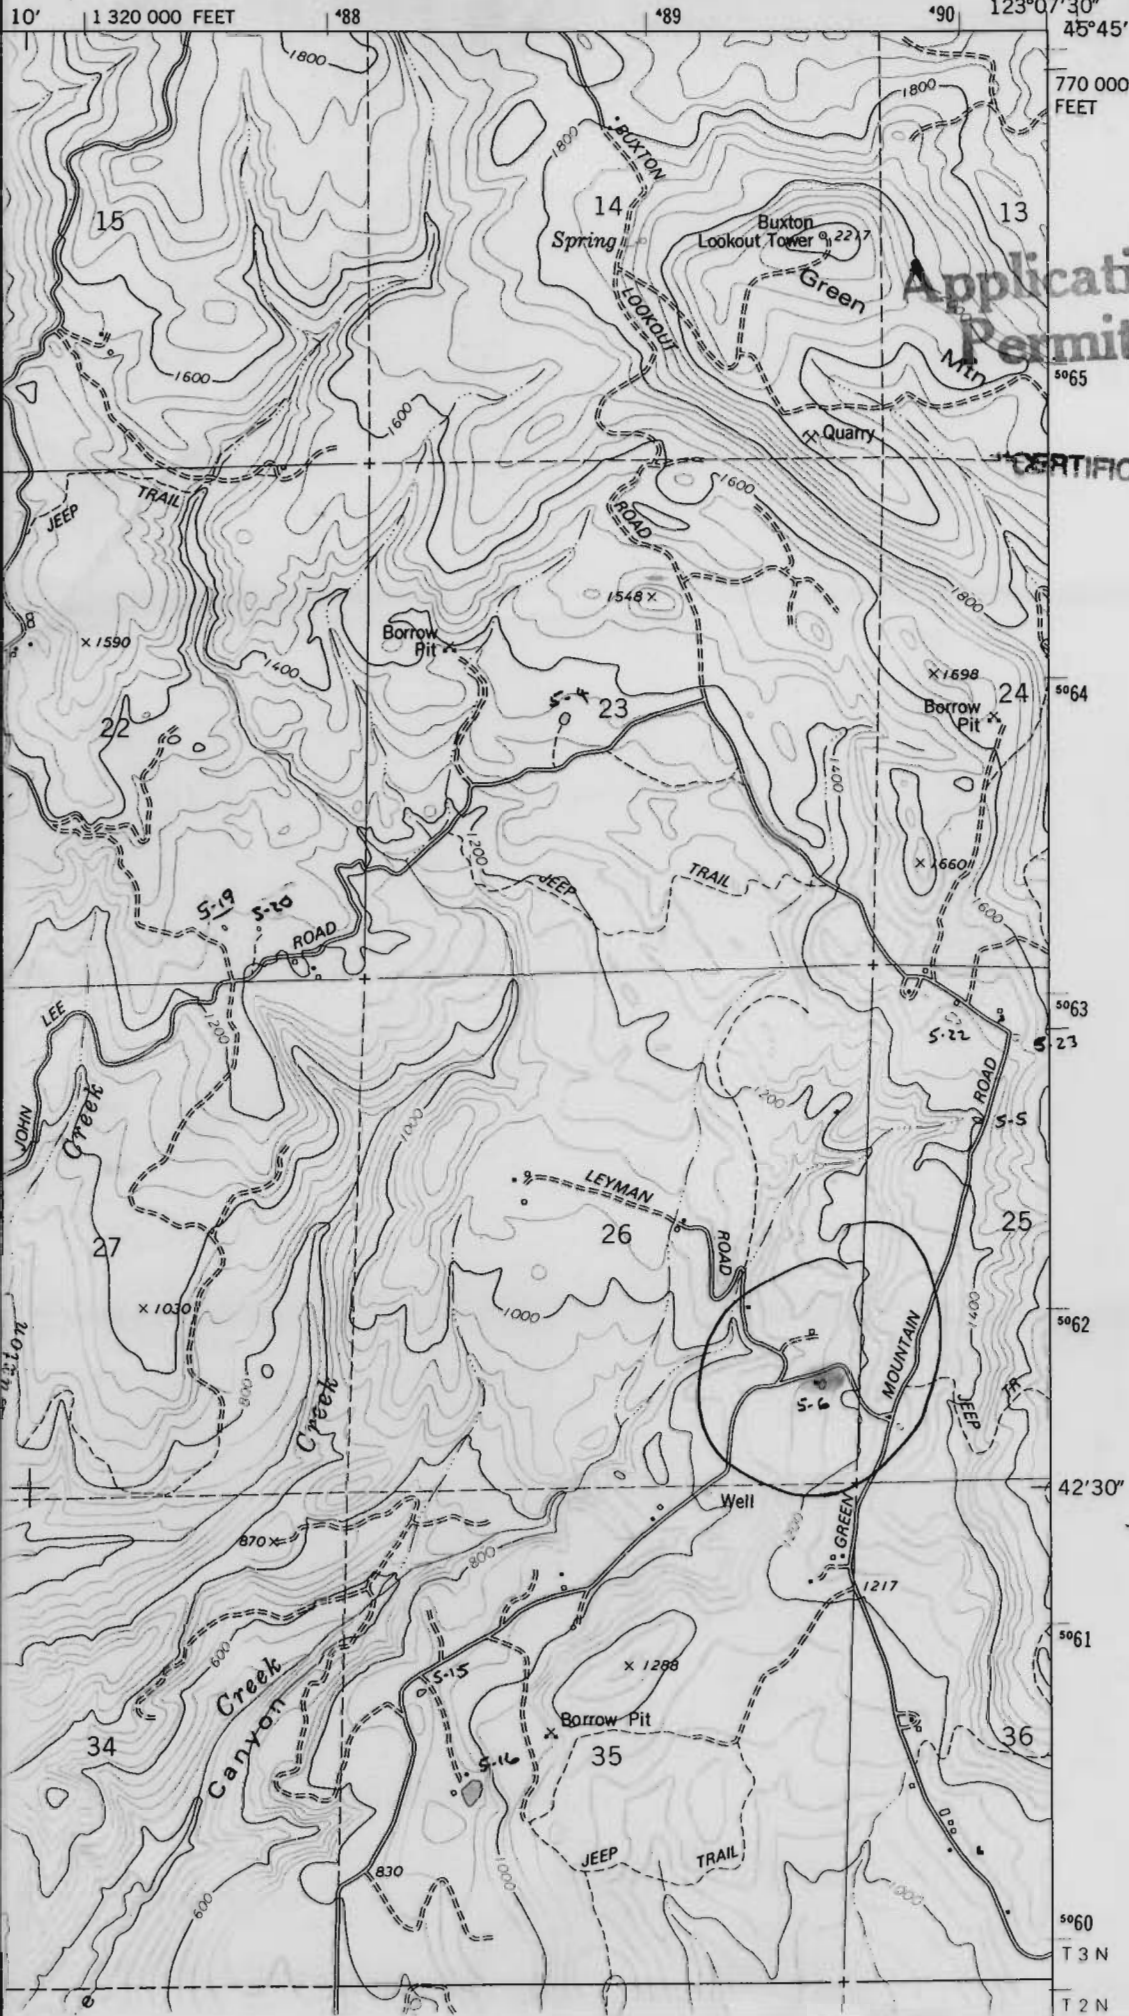

DEC 28 1994

WAI

Application No. R-74150
Permit No.

CERTIFICATE NO. 70130

1979
Buxton