


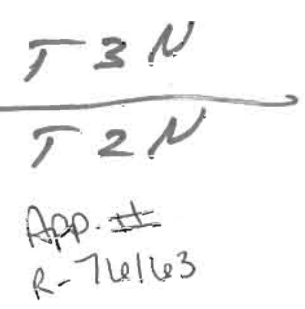

"CERTIFICATE NO. 70140,"

CERTIFICATE NO. 70140

Application No. R-76163
Permit No. 45° 37' 30"

509000E 116° 52' 30"

R47E R48E

ROAD LEGEND

Improved Road
Unimproved Road
Trail

 Interstate Route  U. S. Route  State Route

ZUMWALT, OREGON
PROVISIONAL EDITION 1990

45116-F8-TF-024

PROVISIONAL MAP
Produced from original
manuscript drawings. Infor-
mation shown as of date of
field check.

1	2	3	1 Billy Meadows 2 Poison Point 3 Deadhorse Ridge 4 Greenwood Butte 5 Haas Hollow 6 Elk Mountain SE 7 Findley Buttes 8 Innaha
4		5	
6	7	8	

ADJOINING 7.5' QUADRANGLE NAMES

THIS MAP COMPLIES WITH NATIONAL MAP ACCURACY STANDARDS
FOR SALE BY U.S. GEOLOGICAL SURVEY
DENVER, COLORADO 80225, OR RESTON, VIRGINIA 22092