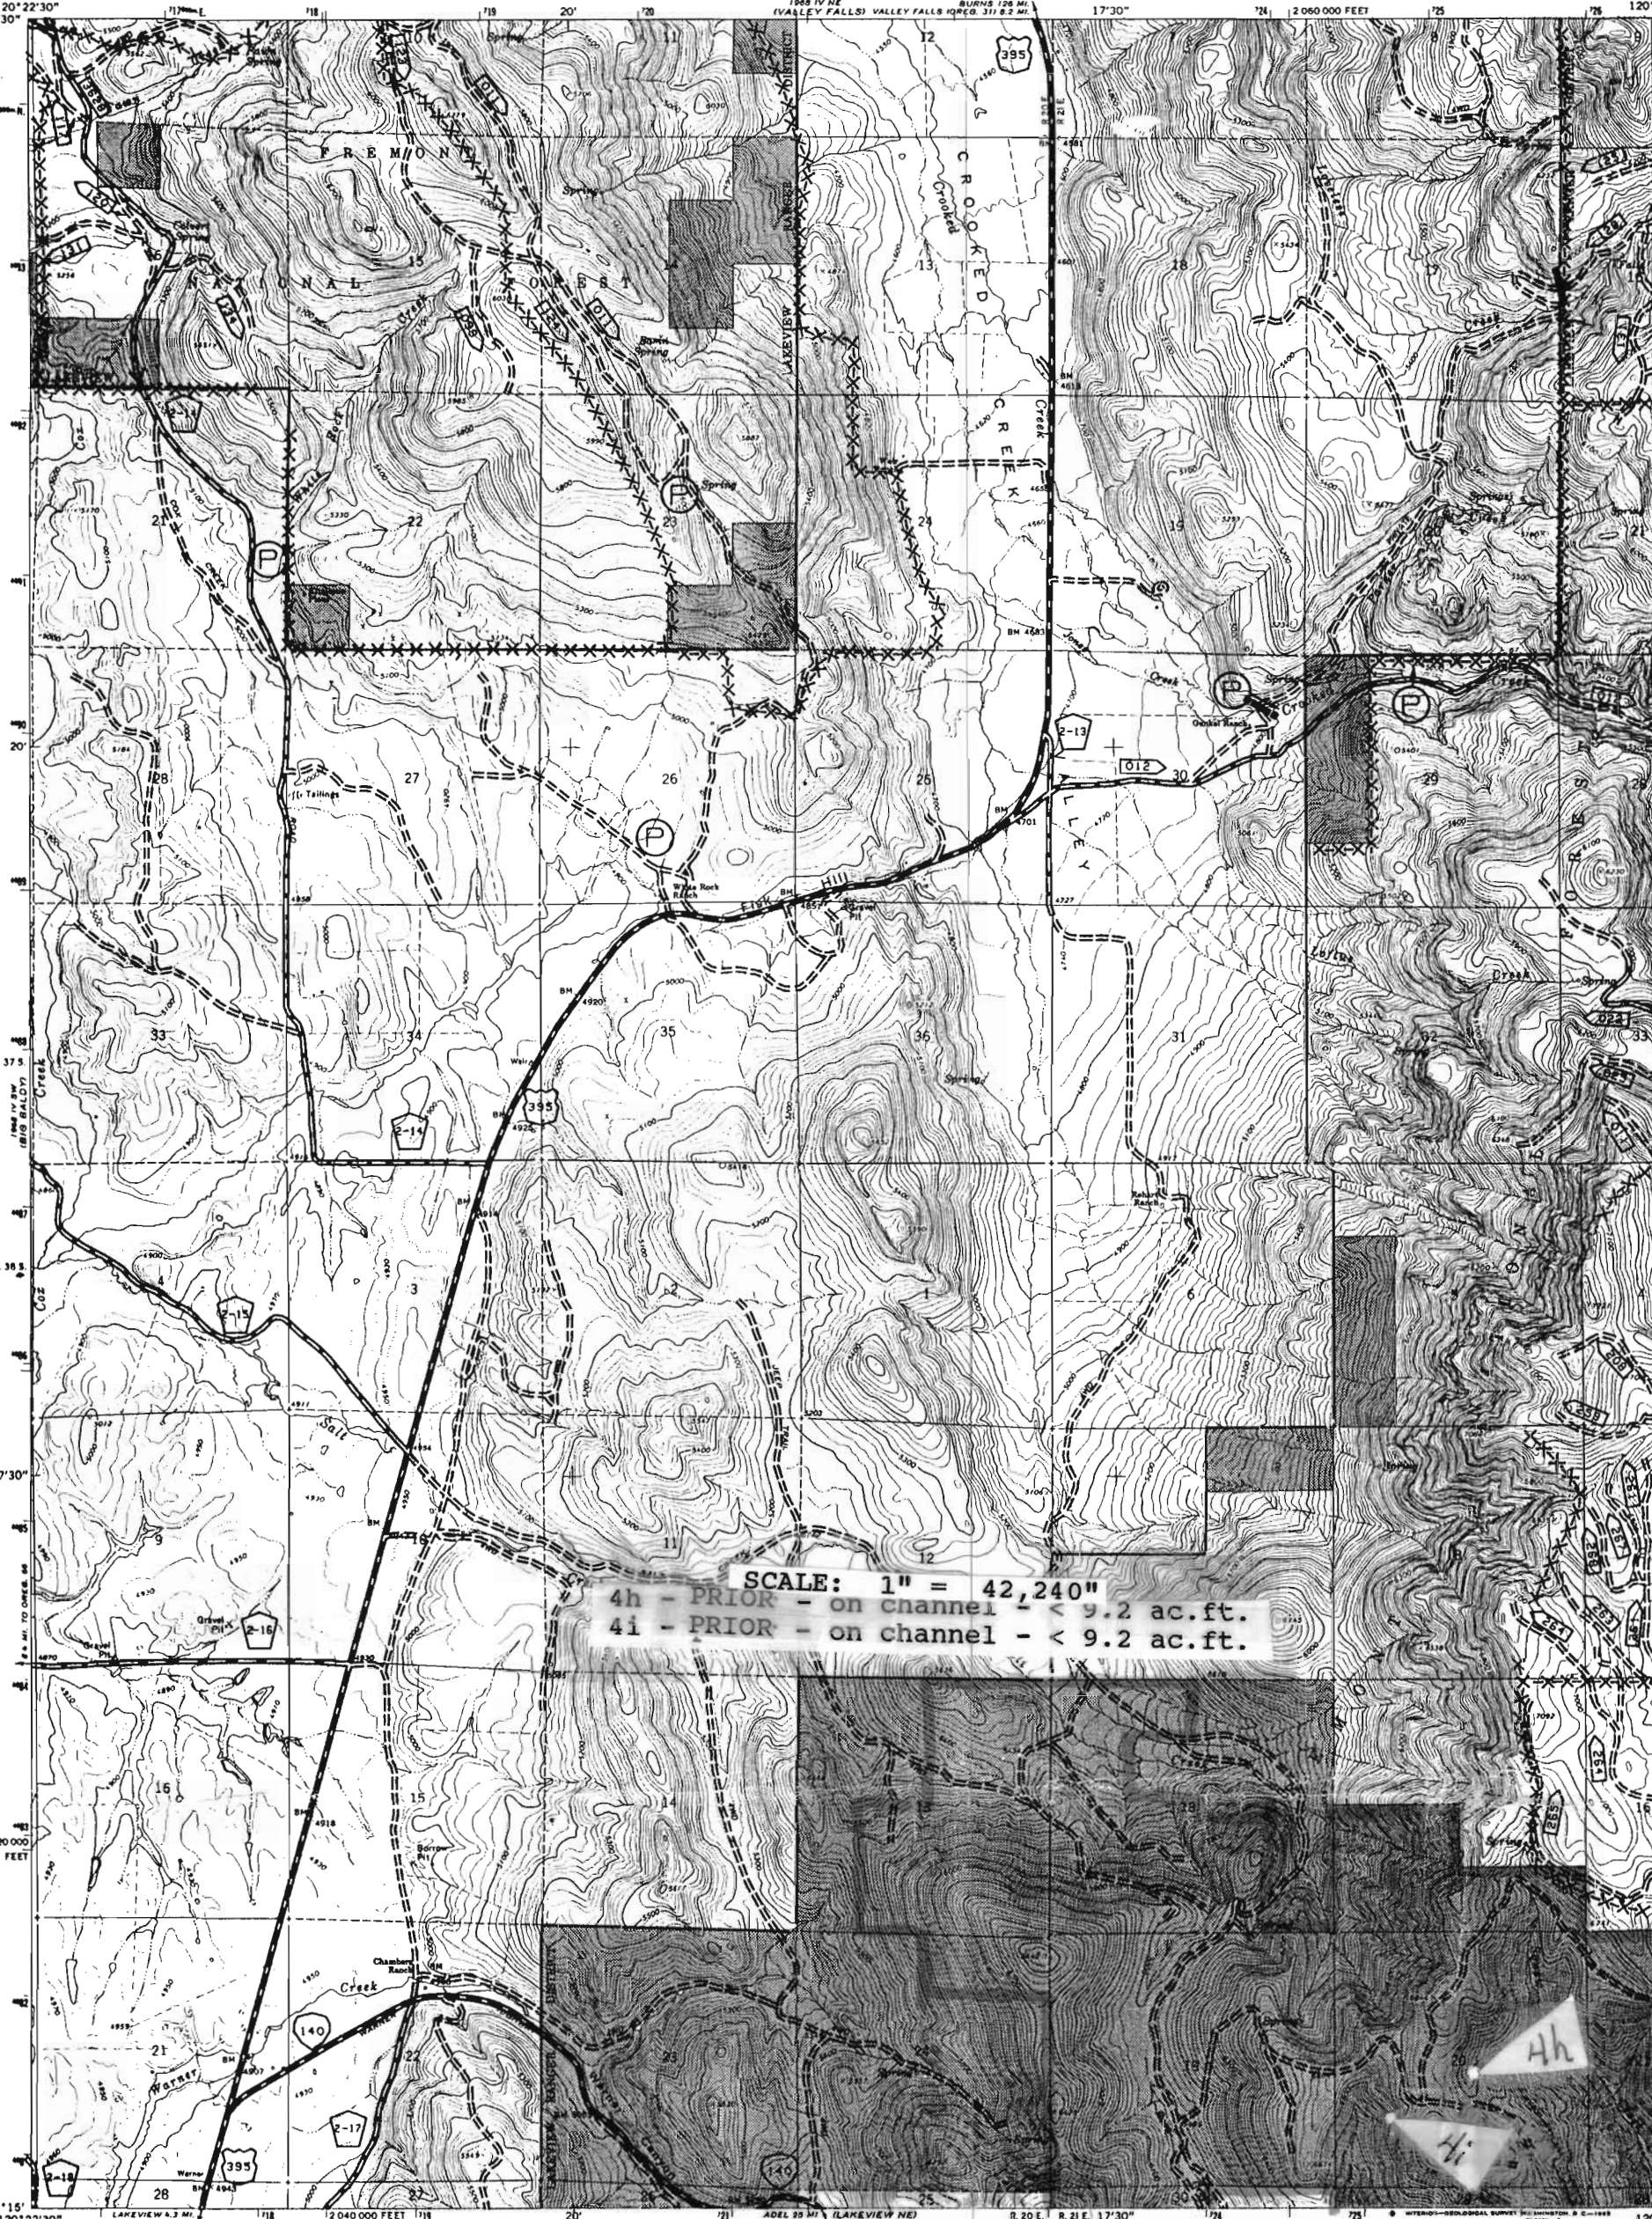


LAKEVIEW, OR 97630



947-2018

[illegible]

CONSTRUCTED IN THE
OFFICE, PORTLAND, O.
1967 FROM U.S. FOREST
PRIMARY TRAIL SECTORS
GEOLOGICAL SURVEY OF
ROAD OVERLAY IS CON-
DARTED BY THE FOREST
FOREST, SO - ENGINE
DETAIL HAS BEEN ADD-
ALTERED ON MAP THAT
WEST NATIONAL MAPPI-
STHODROS.

61

Base map prepared by the U.S. Geological Survey
Control by USGS and USC&GS
Topography by photogrammetric methods from aerial
photographs taken 1960. Field checked 1964
Polyconic projection. 1927 North American datum
10,000-foot grid based on Oregon coordinate system,
south zone
1000-meter Universal Transverse Mercator grid ticks,
zone 10, shown in blue
Fine red dashed lines indicate selected fence lines
Modification to USGS base map by the Geometrics Service
Center from 1979 aerial photography and 1982 correction
figures furnished by the Pacific Northwest Region.
Landnet revised according to additional Forest Service evidence.

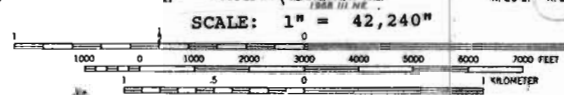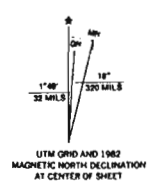

CONTOUR INTERVAL 20 FEET
DOTTED LINES REPRESENT 10-FOOT CONTOURS
DATUM IS MEAN SEA LEVEL

LEGEND

 National Forest Boundary
 Alienated Land within the National Forest Boundary as of June 1981
 Special Area Boundary
TOWNSHIP AND SECTION LINE CLASSIFICATION
 Surveyed, Location Reliable
 Surveyed, Location Unreliable
 Unsurveyed, Protracted

Application No. R-76167
Permit No.

CROOKED CREEK VALLEY, OREG.
N4215—W12015/7.5

1964

DMA 1968 IV SE.-SERIES V092

RECEIVED


DEC 28 1994

CERTIFICATE NO.


70144

WATER RESOURCES DEP
SALEM, OREGON -

LP

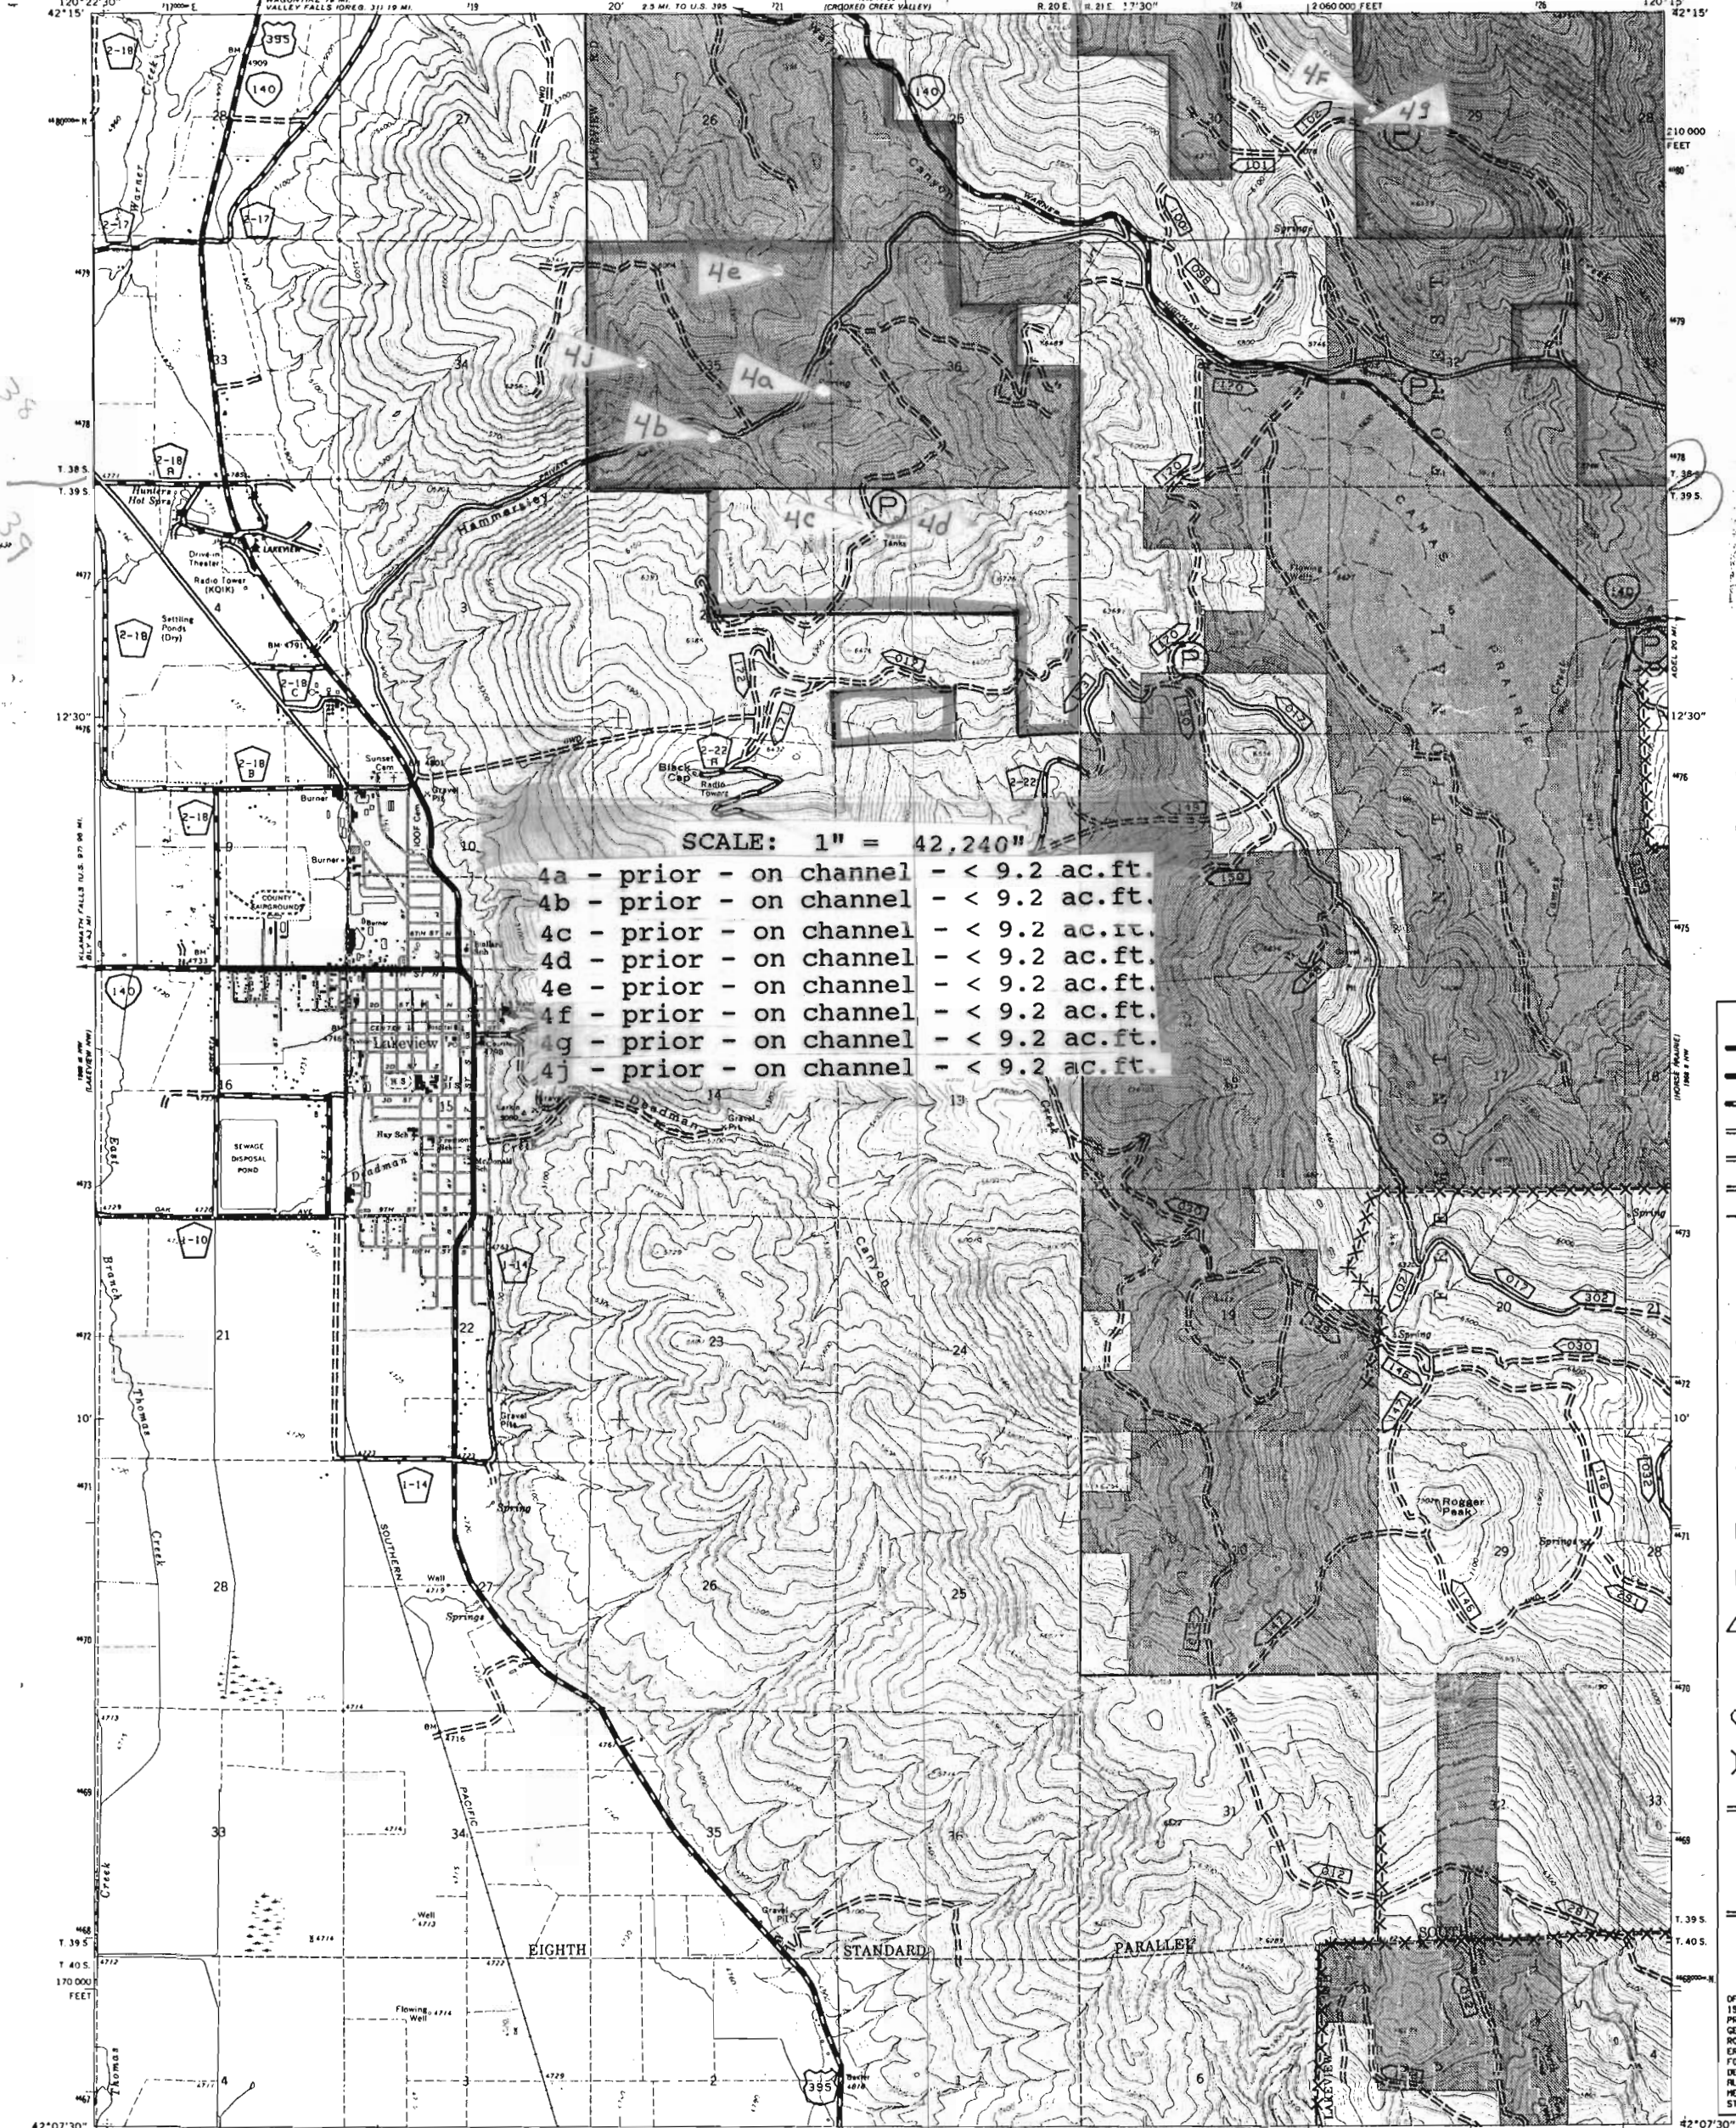

4a	- prior	- on channel	- < 9.2 ac.ft.
4b	- prior	- on channel	- < 9.2 ac.ft.
4c	- prior	- on channel	- < 9.2 ac.ft.
4d	- prior	- on channel	- < 9.2 ac.ft.
4e	- prior	- on channel	- < 9.2 ac.ft.
4f	- prior	- on channel	- < 9.2 ac.ft.
4g	- prior	- on channel	- < 9.2 ac.ft.
4j	- prior	- on channel	- < 9.2 ac.ft.

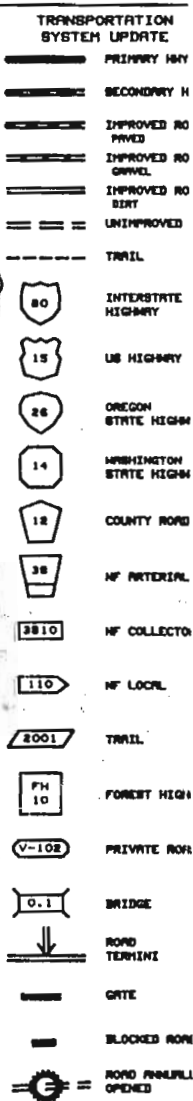

CONSTRUCTED IN THE REGIONAL OFFICE, PORTLAND, OREGON, IN 1987 FROM U.S. FOREST SERVICE PRIMARY SHAP BOXES AND U.S. GEOLOGICAL SURVEY SUPERIMPOSED ROAD OVERLAY IS COMPUTER GENERATED BY THE FREIGHT NATIONAL FOREST, SO - ENGINEERING LINE DETAIL HAS BEEN ADDED PLUS/OR ALTERED ON MAP THAT MAY NOT MEET NATIONAL MAPPING ACCURACY STANDARDS.

UTM GRID AND 1982
MAGNETIC NORTH DECLINATION
AT CENTER OF SHEET

 National Forest Boundary
 Alienated Land within the National Forest Boundary as of June 1981
 Special Area Boundary
TOWNSHIP AND SECTION LINE CLASSIFICATION
 Surveyed, Location Reliable
 Surveyed, Location Unreliable
 Unsurveyed, Protracted

SCALE: 1" = 42,240'

CONTOUR INTERVAL 20 FEET
DOTTED LINES REPRESENT 10-FOOT CONTOURS
NATIONAL GEODETIC VERTICAL DATUM OF 1929
LEGEND

RECEIVED

DEC 28 1994

WATER RESOURCES DEPT
SALEM, OREGON

Application No. _____
Permit No. _____

CROOK PEAK, OREG.
N4215-W12007.5/7.5

1969

DMA 1968 I BW-SERIES V092

014.4

CERTIFICATE NO.

62

LP

APP # R76167

CERTIFICATE NO.

70144

HORSE PRAIRIE QUADRANGLE
OREGON-LAKE CO.
7.5 MINUTE SERIES (TOPOGRAPHIC)

LAKEVIEW, OR 97630

947-2018

SCALE: 1" = 42,240"

PONDS


- 2a - proir - on channel - < 9.2 ac.ft.
2b - proir - on channel - < 9.2 ac.ft.
2c - proir - on channel - < 9.2 ac.ft.
2d - proir - on channel - < 9.2 ac.ft.
2e - proir - on channel - < 9.2 ac.ft.
2f - proir - on channel - < 9.2 ac.ft.
2g - proir - on channel - < 9.2 ac.ft.
2h - proir - on channel - < 9.2 ac.ft.
2i - proir - on channel - < 9.2 ac.ft.
2j - proir - on channel - < 9.2 ac.ft.

SCALE: 1" = 42,240"

CONTOUR INTERVAL 20 FEET
NATIONAL GEODETIC VERTICAL DATUM OF 1929

LEGEND

- National Forest Boundary
— Alienated Land within the National Forest Boundary as of June 1981
— Special Area Boundary
TOWNSHIP AND SECTION LINE CLASSIFICATION
— Surveyed, Location Reliable
— Surveyed, Location Unreliable
— Unserved, Protracted

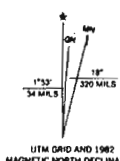


Application No. R-76167
Permit No.

HORSE PRAIRIE, OREG.
N4207.5-W12007.5/7.5

1968
PHOTOREVISED 1980
DMA 1988 II NW-SERIES V892

QUADRANGLE LOCATION DIAGRAM


RECEIVED
DEC 28 1994
WATER RESOURCES DEP
SALEM, OREGON

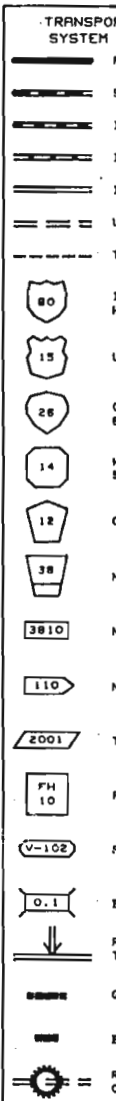

CONSTRUCTED IN
OFFICE, PORTLAND,
1987 FROM U.S. FS
PRIMARY BASE DATA
GEOLOGICAL SURVEY
ROAD OVERLAY IS
CONTROLLED BY THE FRI
FOREST, SO - ENCL
DETAIL HAS BEEN
FILTERED ON MAP TO
MEET NATIONAL HWY
STANDARDS.

7

LP

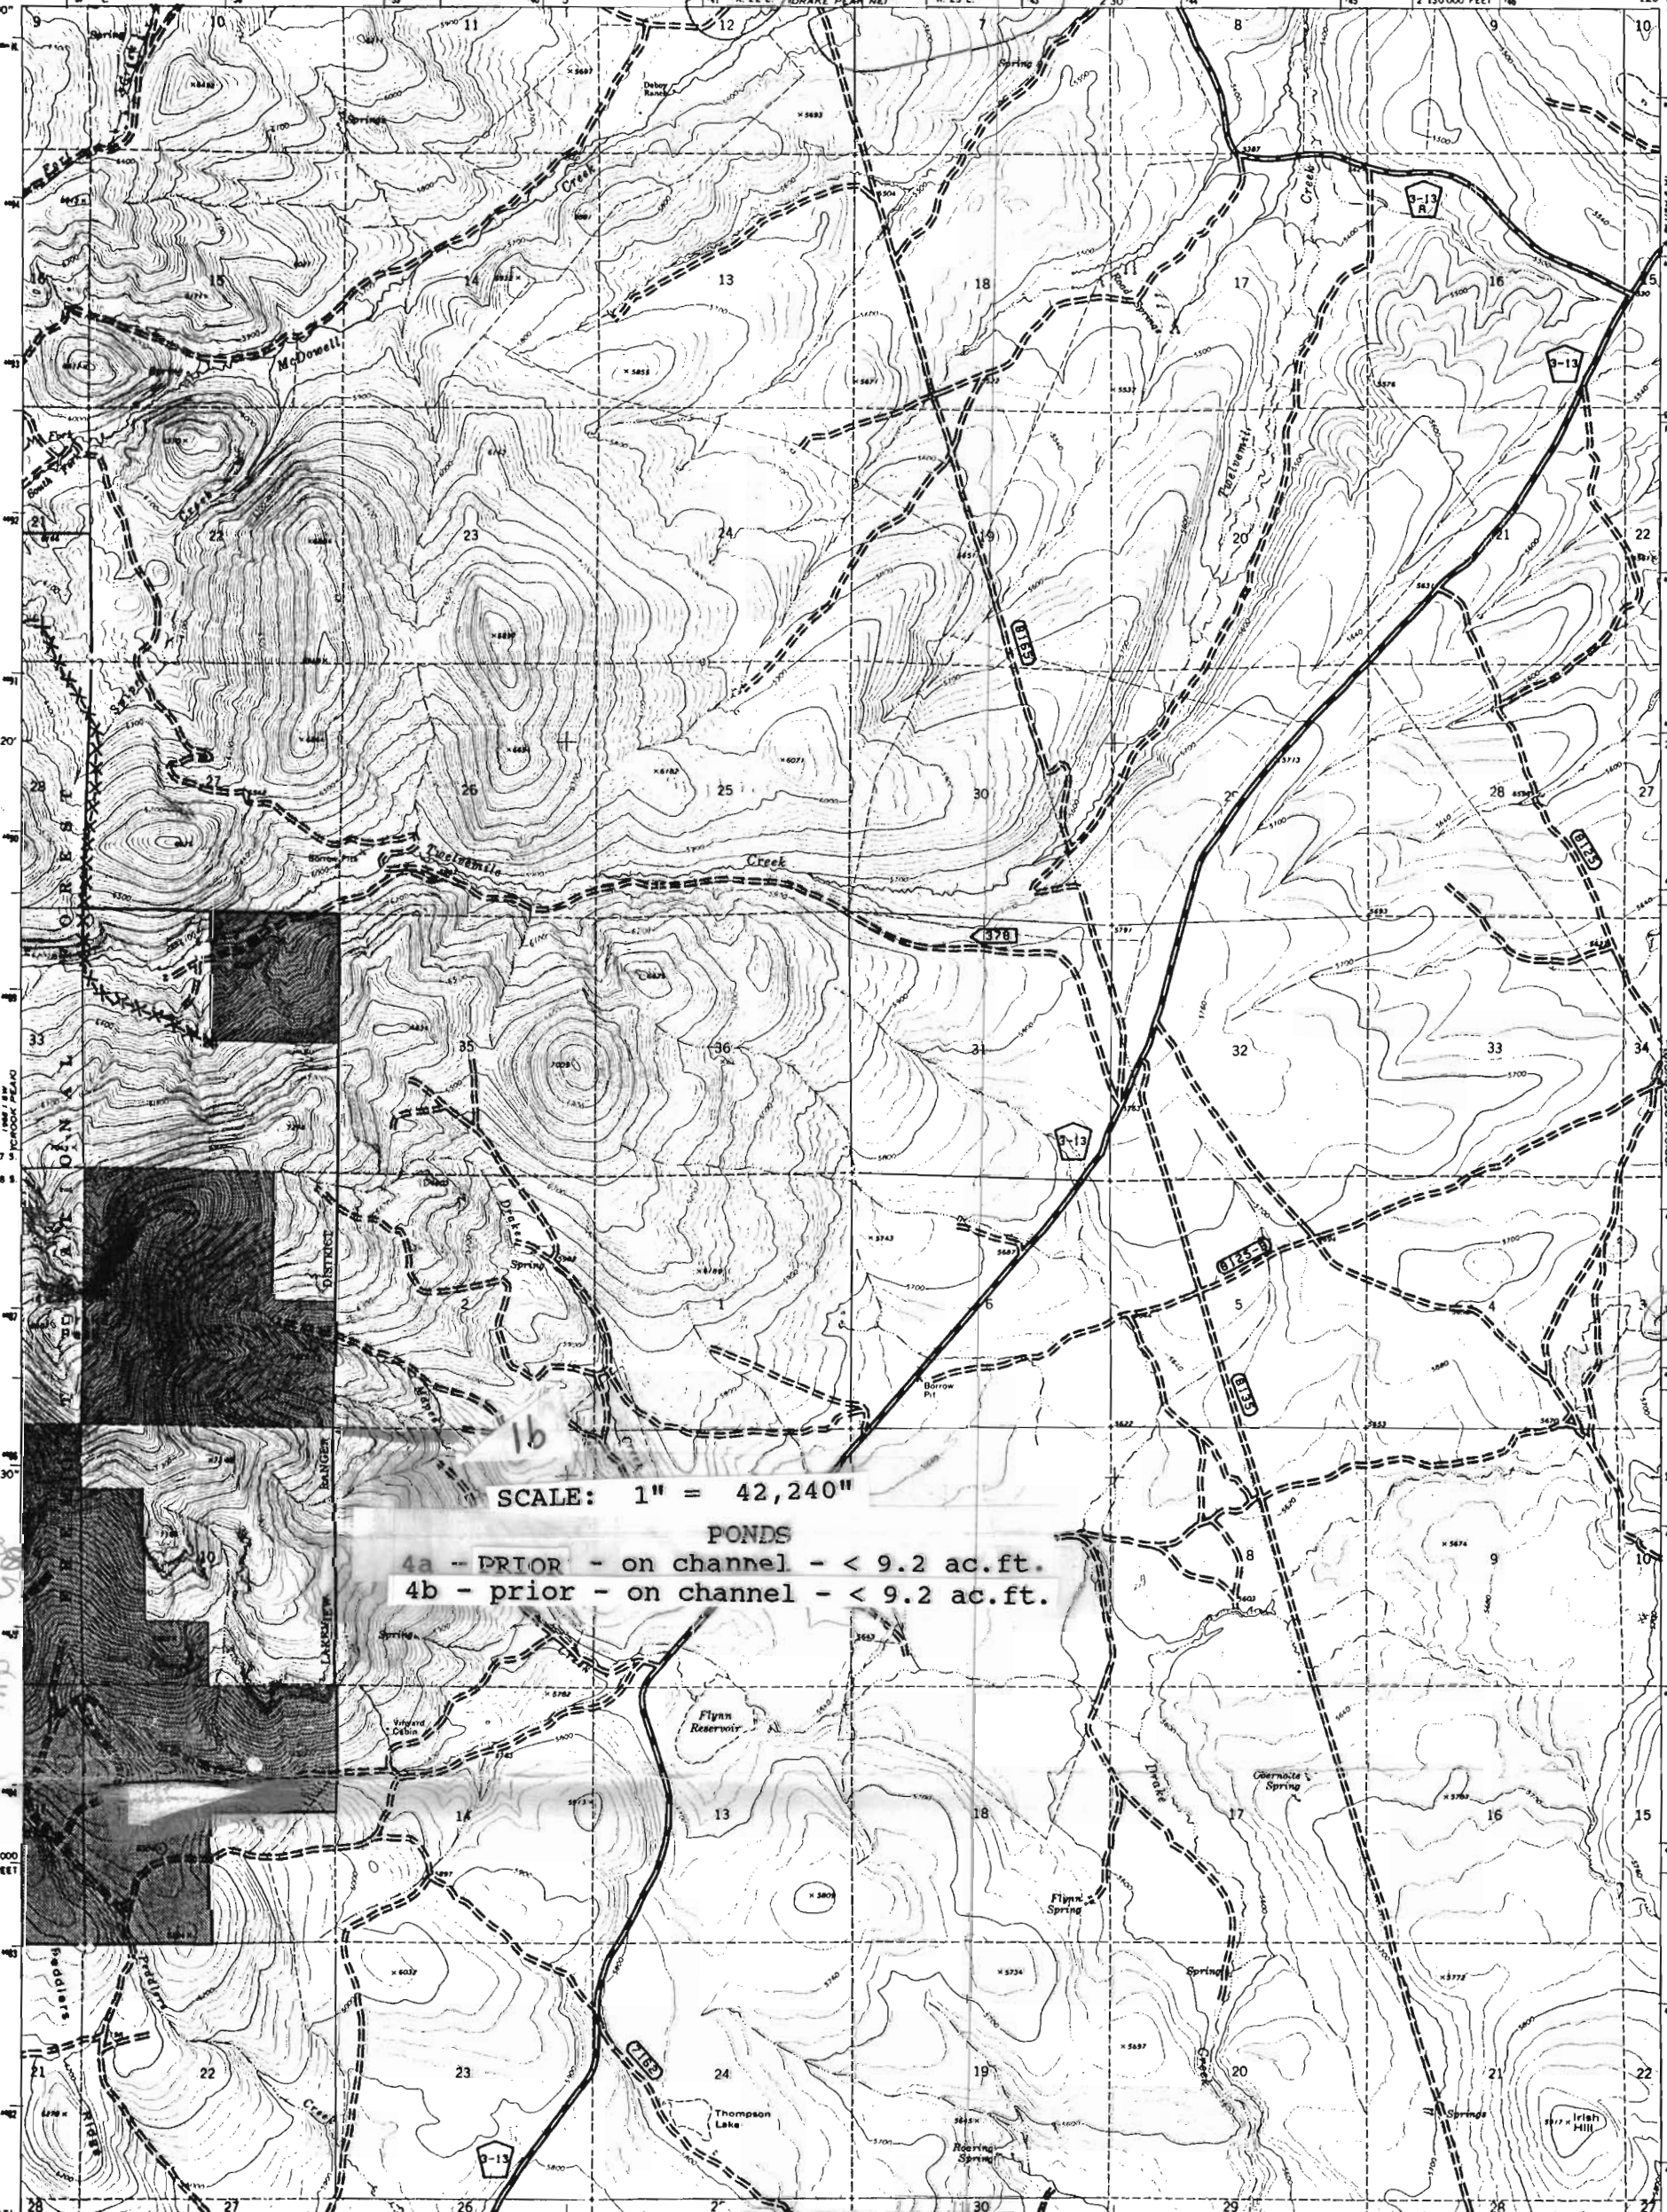

TRANSPORTATION SYSTEM UPDATE	
	PRIMARY
	SECONDARY
	IMPROVED
	GRAVEL
	DIRT
	UNIMPROVED
	TRAIL
	INTERSTATE HIGHWAY
	US HIGHWAY
	OREGON STATE HIGHWAY
	WASHINGTON STATE HIGHWAY
	COUNTY HIGHWAY
	HF PARTIAL
	HF COL
	HF LOC
	TRAIL
	FOREST
	PRIVATE
	BRIDGE
	ROAD TURN
	GATE
	BLOCK
	ROAD INTERSECTION

Base map prepared by the U.S. Geological Survey
Control by USGS and USC&GS
Topography by photogrammetric methods from aerial
photographs taken 1967. Field checked 1968
Polyconic projection. 1927 North American datum
10,000-foot grid based on Oregon coordinate system,
south zone
1000-meter Universal Transverse Mercator grid ticks,
zone 10, shown in blue
Fine red dashed lines indicate selected fence lines
Modification to USGS base map by the Geomatics Service
Center from 1979 aerial photography and 1982 correction
guides furnished by the Pacific Northwest Region.
Landnet revised according to additional Forest Service evidence.

UTM GRID AND 1982
MAGNETIC NORTH DECLINATION
AT CENTER OF SHEET


Legend

- National Forest Boundary
- Alienated Land within the National Forest Boundary as of June 1981
- Special Area Boundary
- TOWNSHIP AND SECTION LINE CLASSIFICATION
- Surveyed, Location Reliable
- Surveyed, Location Unreliable
- Unsurveyed, Protracted

SCALE: 1" = 42,240'

CONTOUR INTERVAL 20 FEET
DOTTED LINES REPRESENT 10-FOOT CONTOURS
DATUM IS MEAN SEA LEVEL

Application No. R-76167
Permit No.

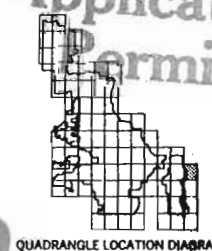

LAKEVIEW, OREG.
N4215-W12000/7.5
1968
DMA 1988 18E-SERIES V892

RECEIVED
DEC 28 1994

WATER RESOURCES DEP
SALEM, OREGON

CERTIFICATE NO. 70144

63

LP