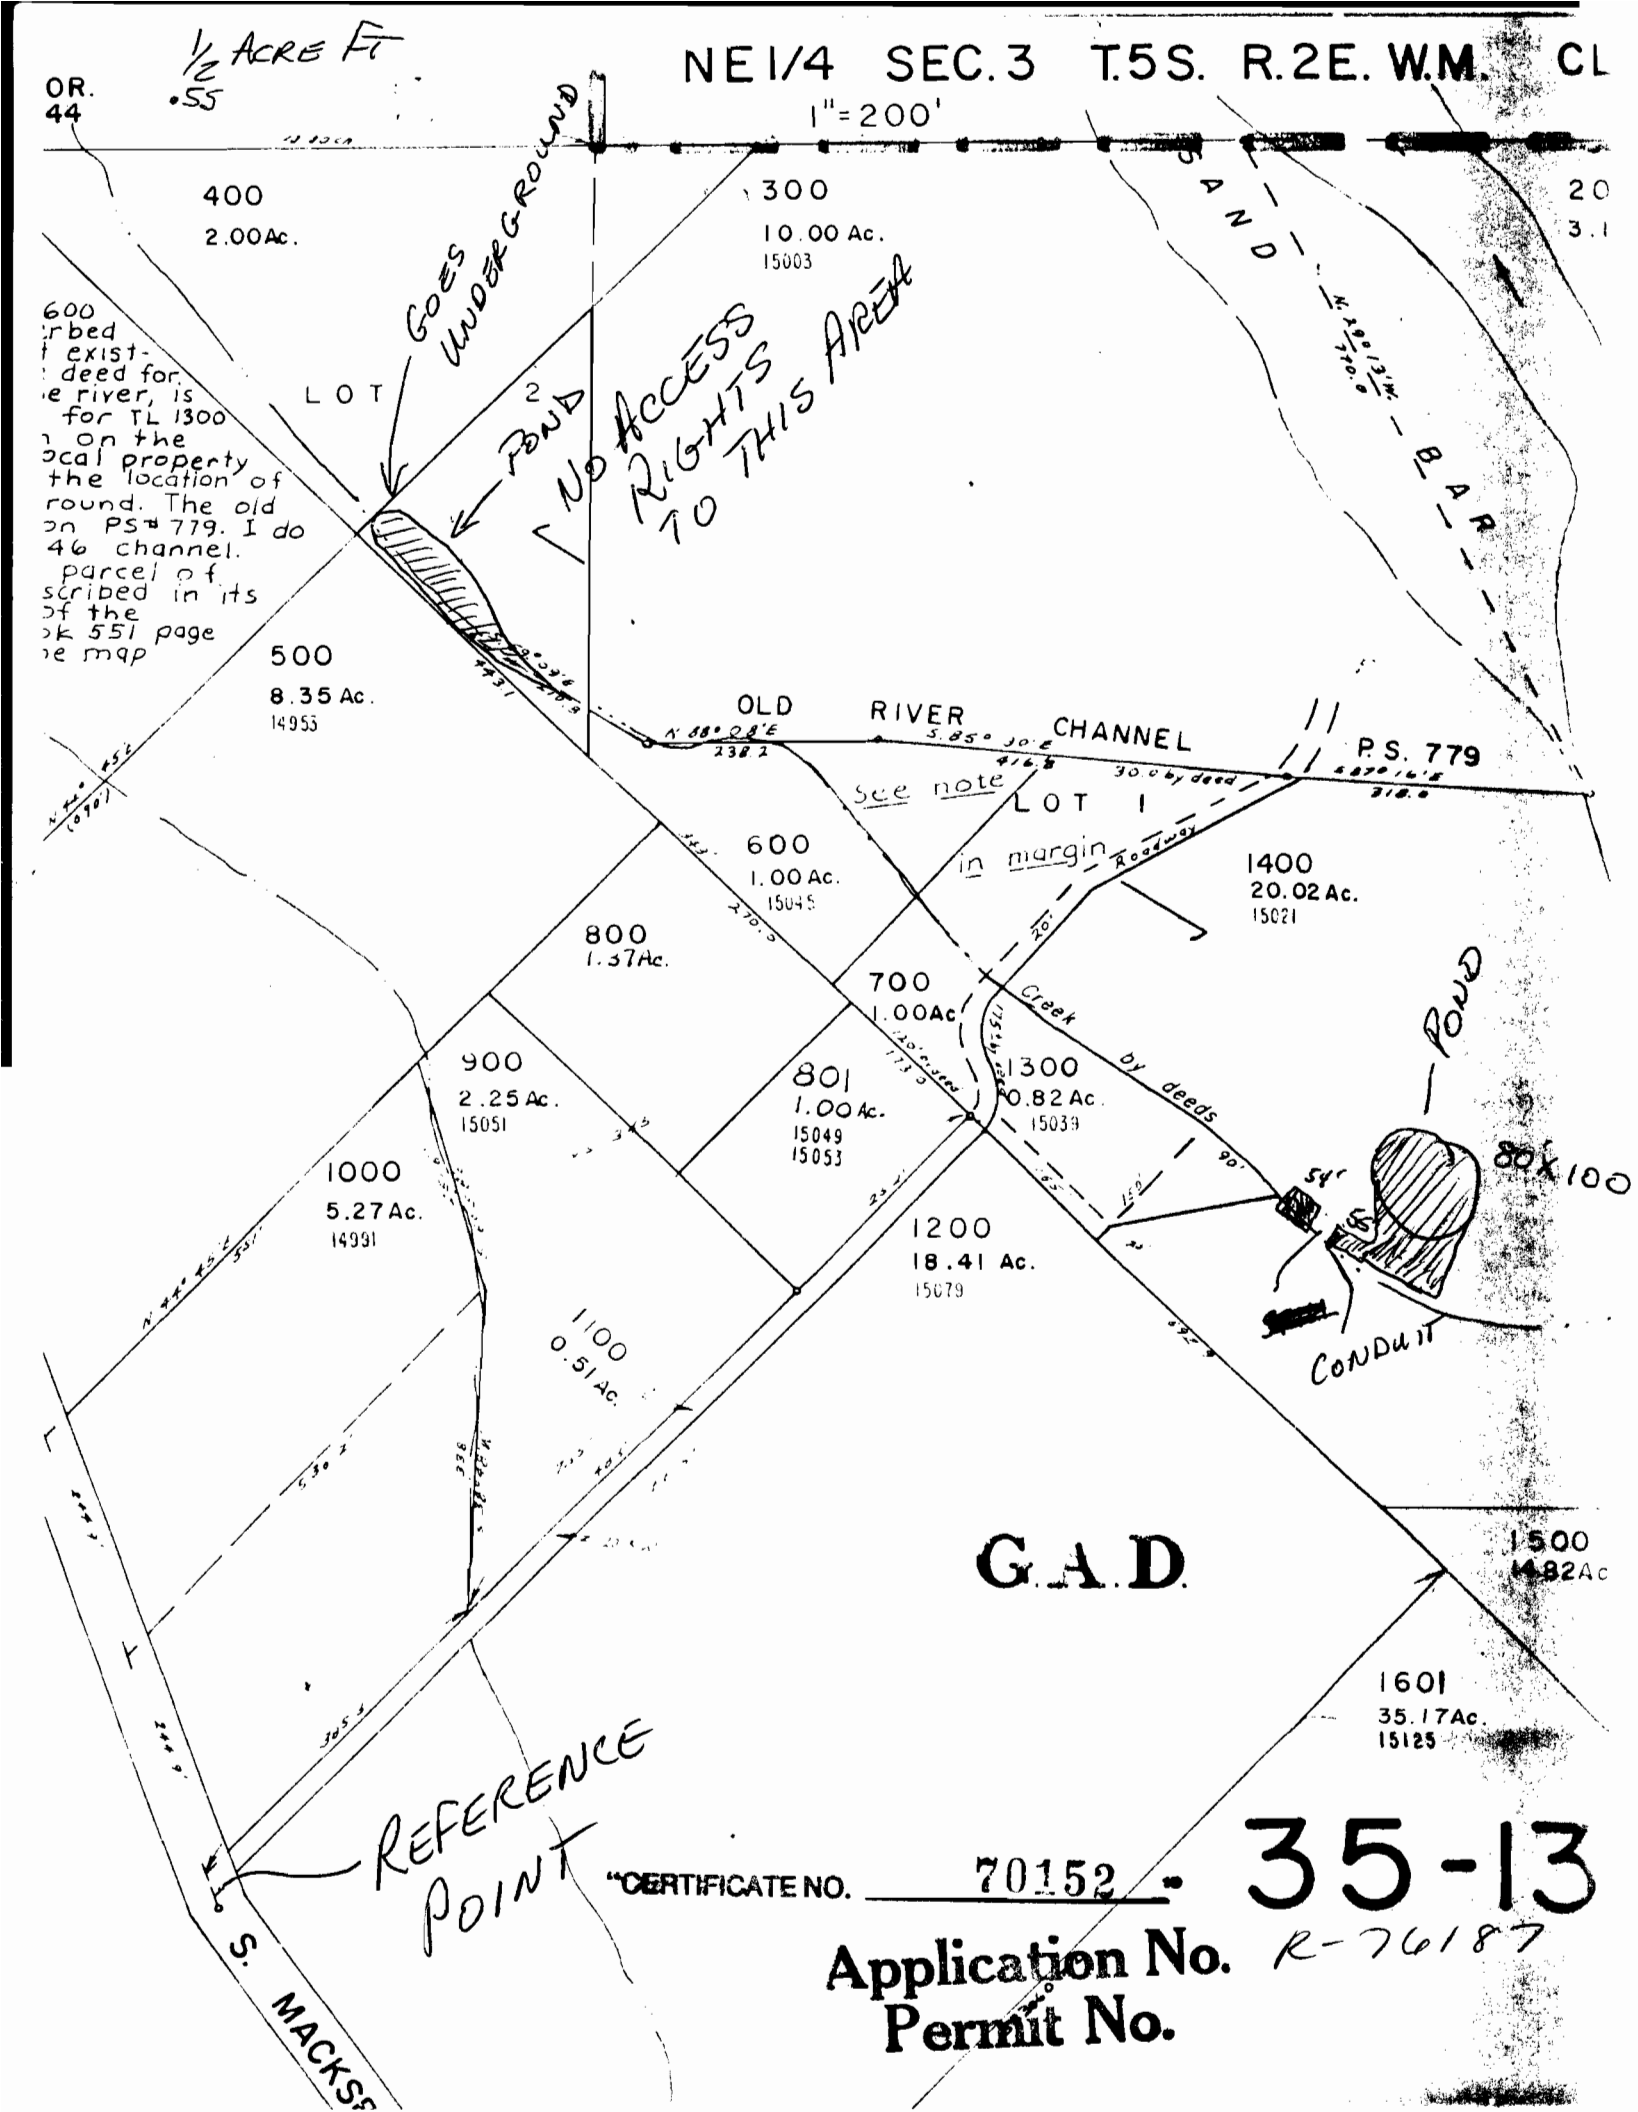
1/2 ACRE FT
.55
NE1/4 SEC. 3 T.5S. R.2E. W.M.
1"=200'
OR.
44
400
2.00Ac.
300
10.00 Ac.
15003
GOES UNDERGROUND
POND
LOT 2
No ACCESS RIGHTS TO THIS AREA
BAND
600
rbed
t exist-
deed for
e river, is
for TL 1300
on the
ocal property
the location of
round. The old
on PS 779. I do
46 channel.
parcel of
scribed in its
of the
k 551 page
e map
500
8.35 Ac.
14953
OLD RIVER CHANNEL
P.S. 779
See note in margin
LOT 1
Roadway
600
1.00 Ac.
15049
800
1.37Ac.
1400
20.02 Ac.
15021
700
1.00Ac.
Creek by deeds
POND
900
2.25 Ac.
15051
801
1.00 Ac.
15049
15053
1300
0.82 Ac.
15039
80X100
1000
5.27Ac.
14991
1200
18.41 Ac.
15079
CONDUIT
1100
0.51 Ac.
G.A.D.
1500
4.82Ac
1601
35.17Ac.
15125
REFERENCE POINT
S. MACKS
CERTIFICATE NO. 70152
35-13
Application No. R-76187
Permit No.