


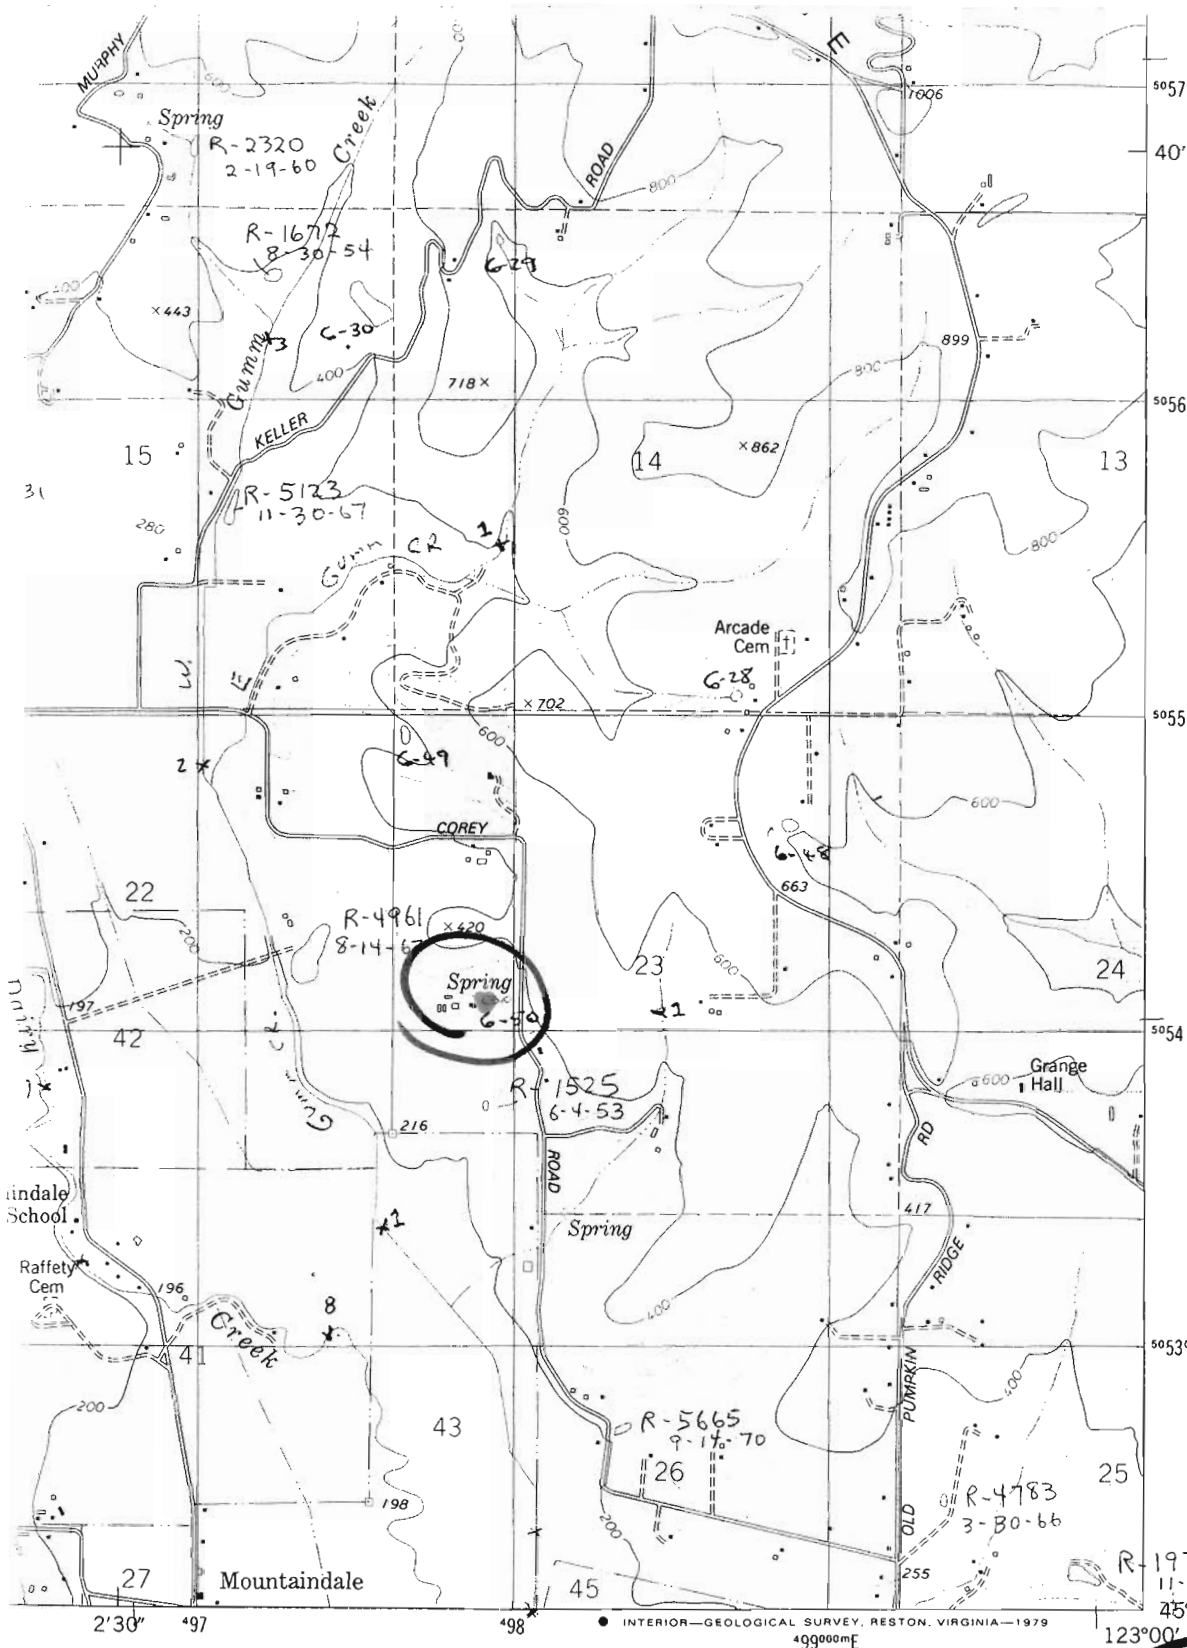

T2N
R3W

12
HILLBORO
OREGON

6

1 MILE
0 FEET

ER



ROAD CLASSIFICATION

Primary highway, hard surface ——— Light-duty road, hard or improved surface ———

Secondary highway, hard surface ——— Unimproved road - - - - -

○ Interstate Route □ U. S. Route ○ State Route

MEACHAM CORNER, OREG.

NE/4 FOREST GROVE 15' QUADRANGLE
N4537.5—W12300/7.5

1979

DMA 1375 II NE—SERIES V892

Application # 276192

CERTIFICATE NO. 70154

MINIA 22092
IT