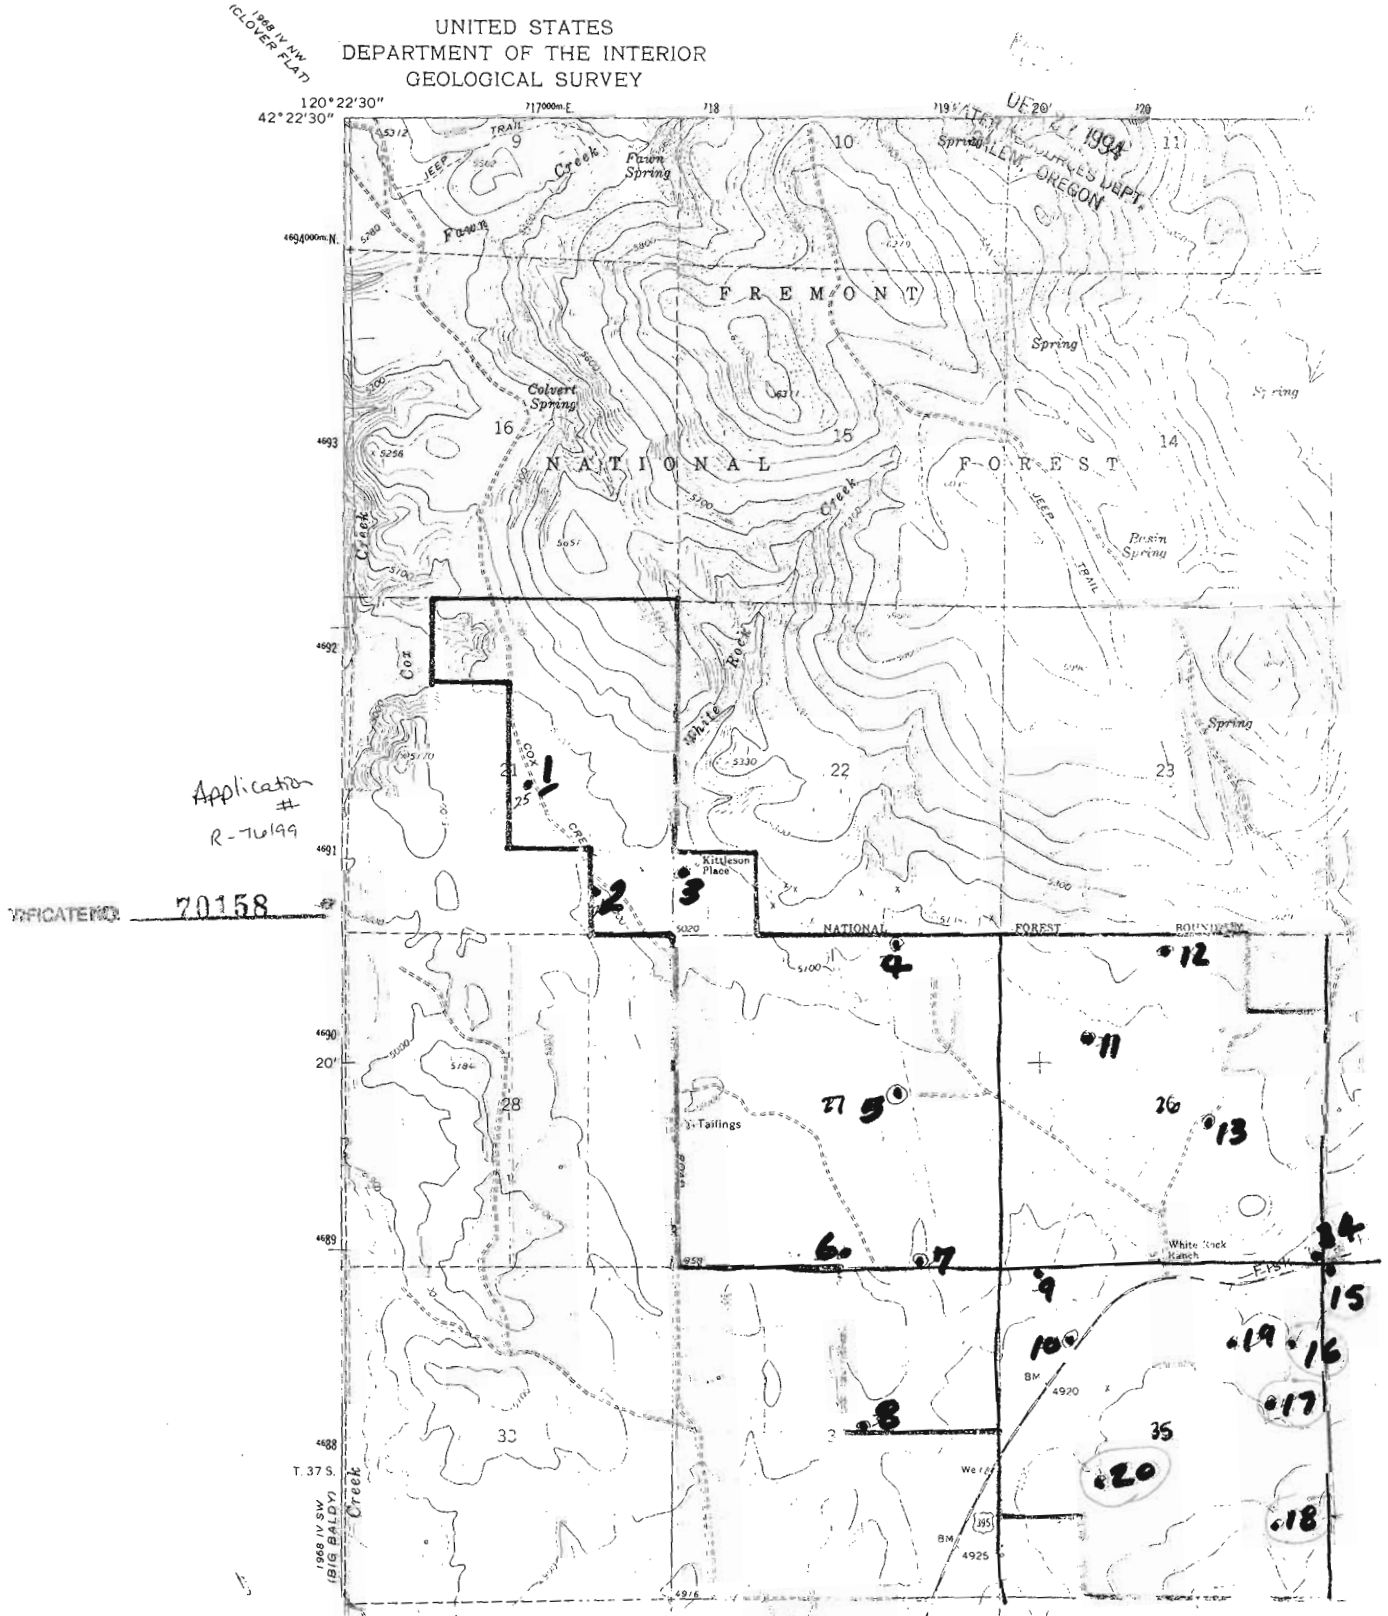app 76200 cert 70159