


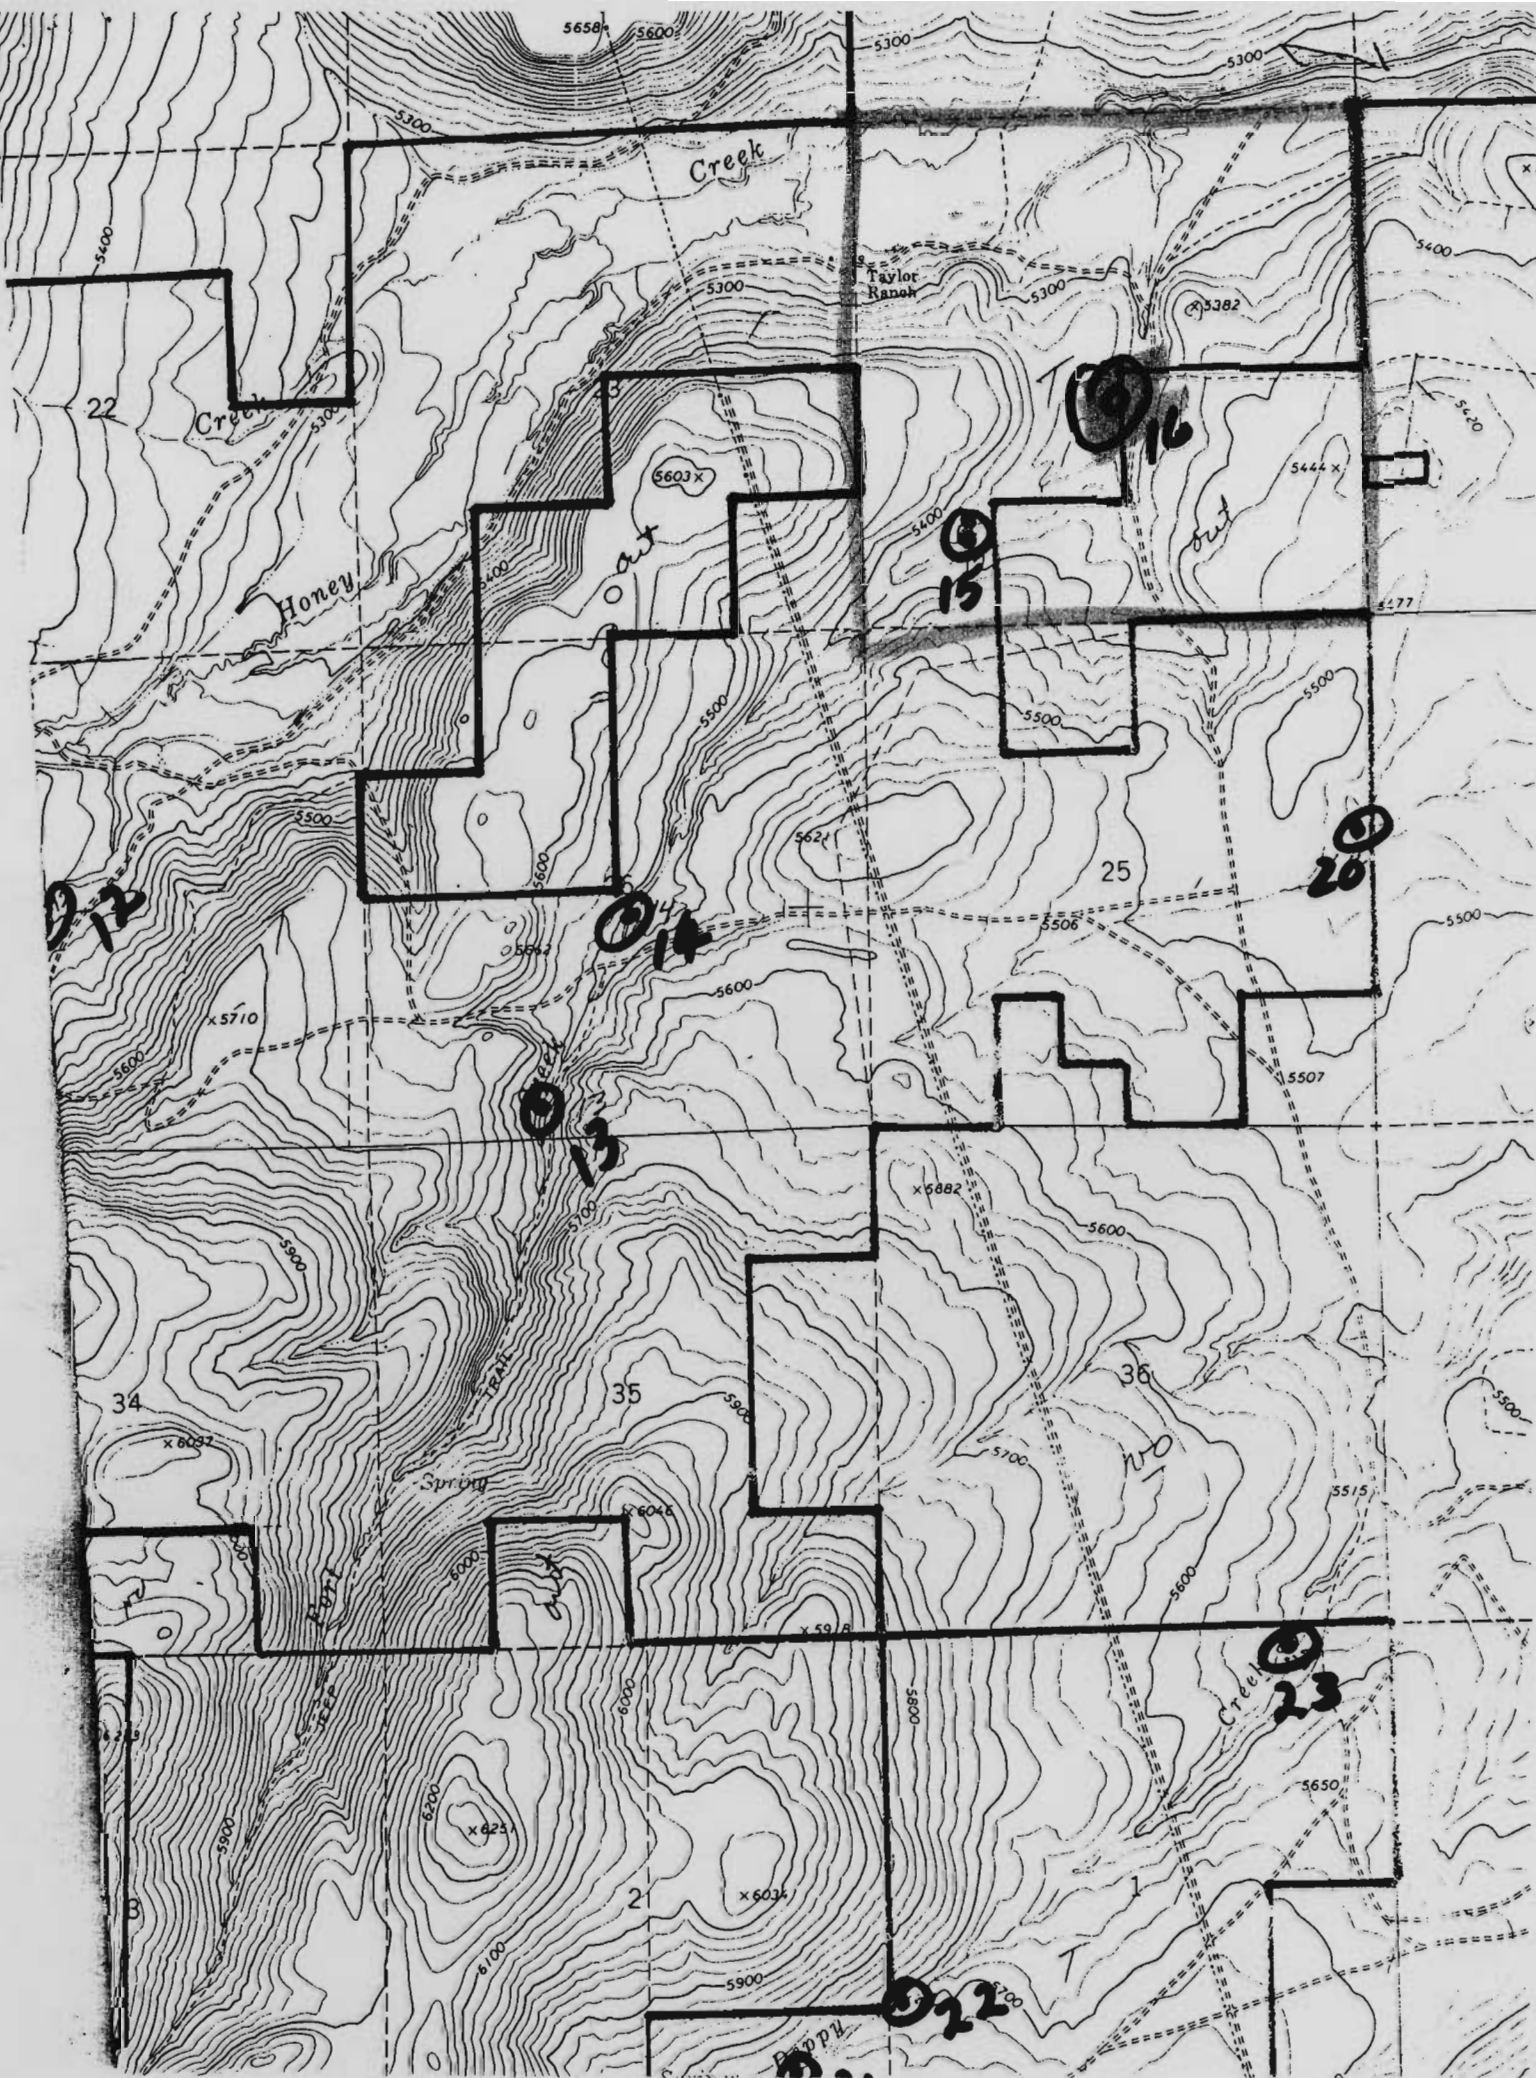

"CERTIFICAT"

4699

4698

T. 36 S.

T. 37 S.

4697

4696

260 000
FEET

42° 22' 30"
120° 07' 30"

1737

1738

2 110 000 FEET

11

Mapped, edited, and published by the Geological Survey

Control by USGS and USC&GS

Topography by photogrammetric methods from aerial
photographs taken 1967. Field checked 1968

Polyconic projection. 1927 North American datum
10,000-foot grid based on Oregon coordinate system,
south zone

1000-meter Universal Transverse Mercator grid ticks,
zone 10, shown in blue

Fine red dashed lines indicate selected fence lines



UTM GRID AND 1968 MAGNETIC NORTH
DECLINATION AT CENTER OF SHEET


(CROOK PEAK)
1968 1 SW

THIS MAP WAS PREPARED FOR
ASSESSMENT PURPOSE ONLY

T.36S. R.22E. W.M.
LAKE COUNTY

1"=2000'

36 22
& INDEX

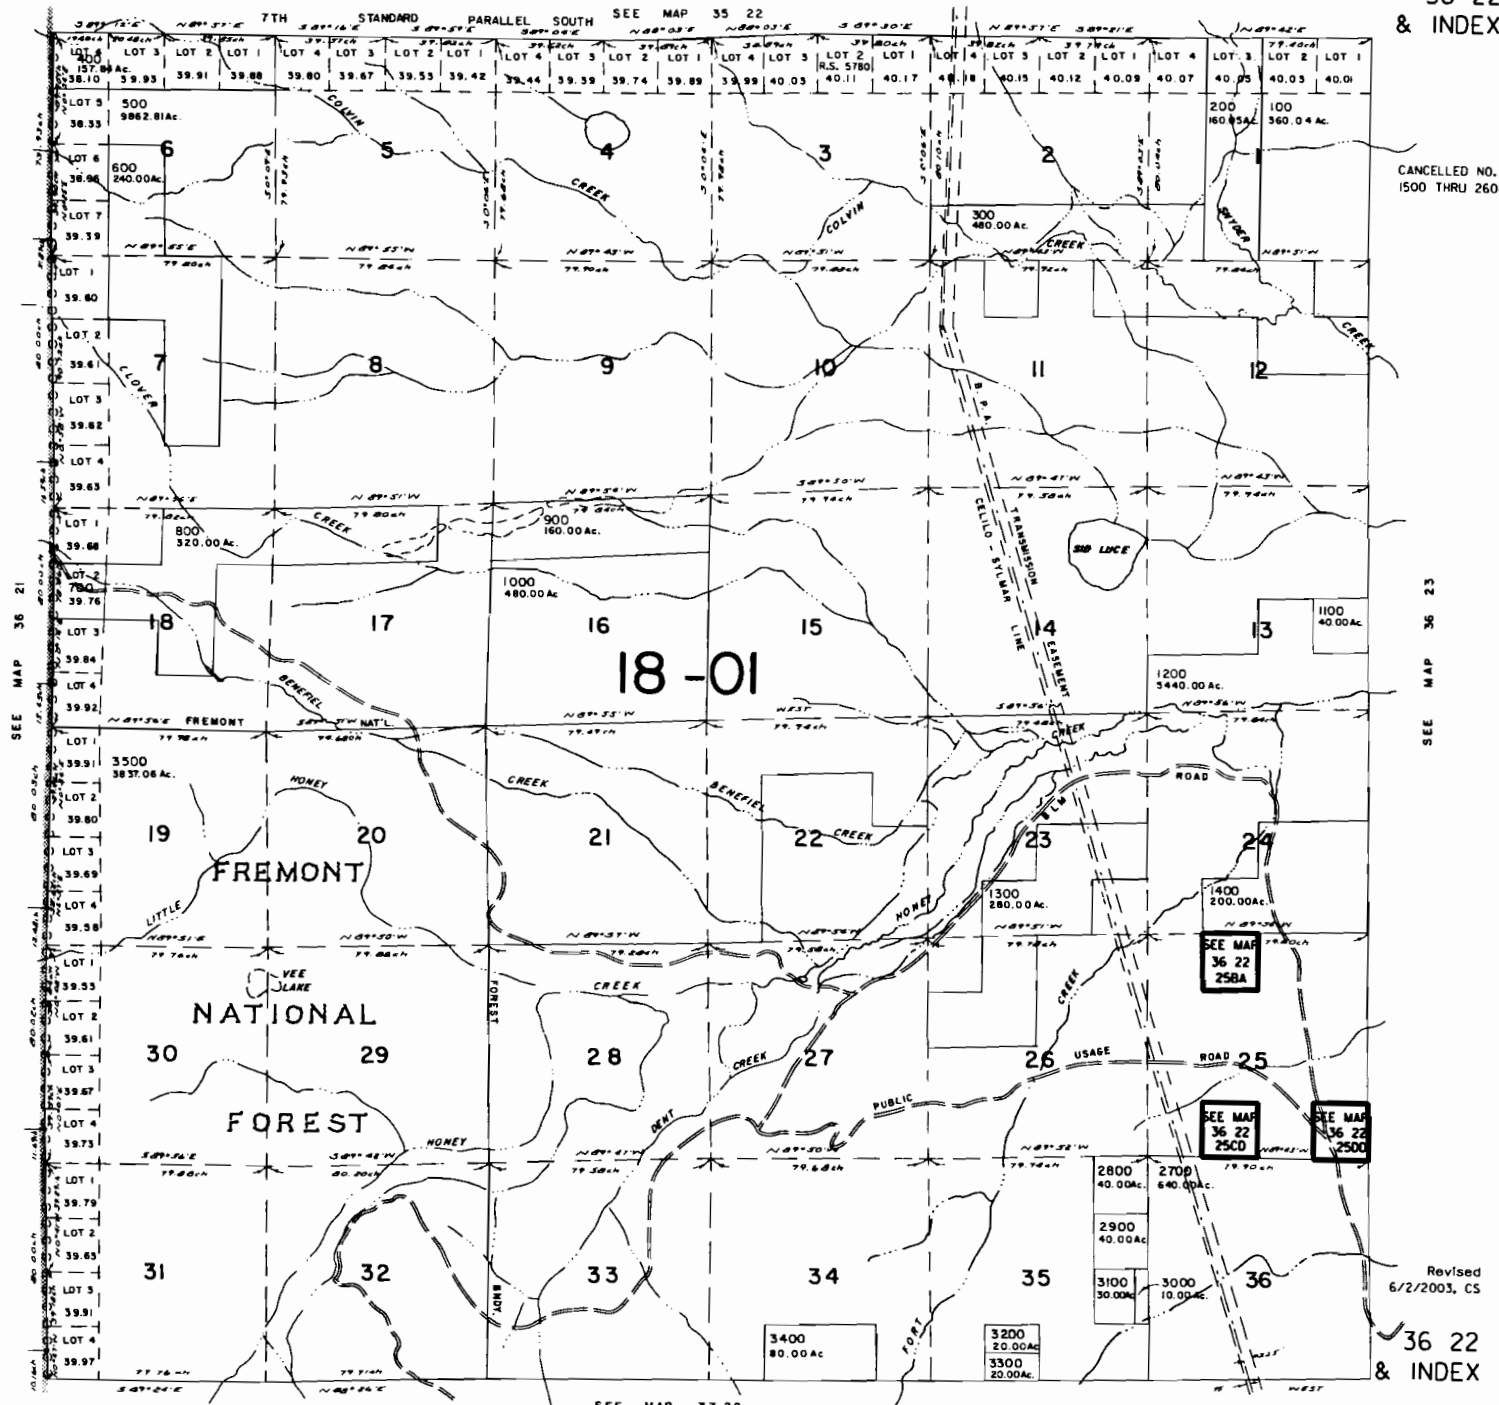

CANCELLED NO.
1500 THRU 2600

SEE MAP 36 23

Revised
6/2/2003, CS

36 22
& INDEX

SEE MAP 37 22

SEE MAP 36 22

1" = 2000'

SEE MAP 37 21

SEE MAP 37 23

