


Exhibit A (Golf Course Layout)

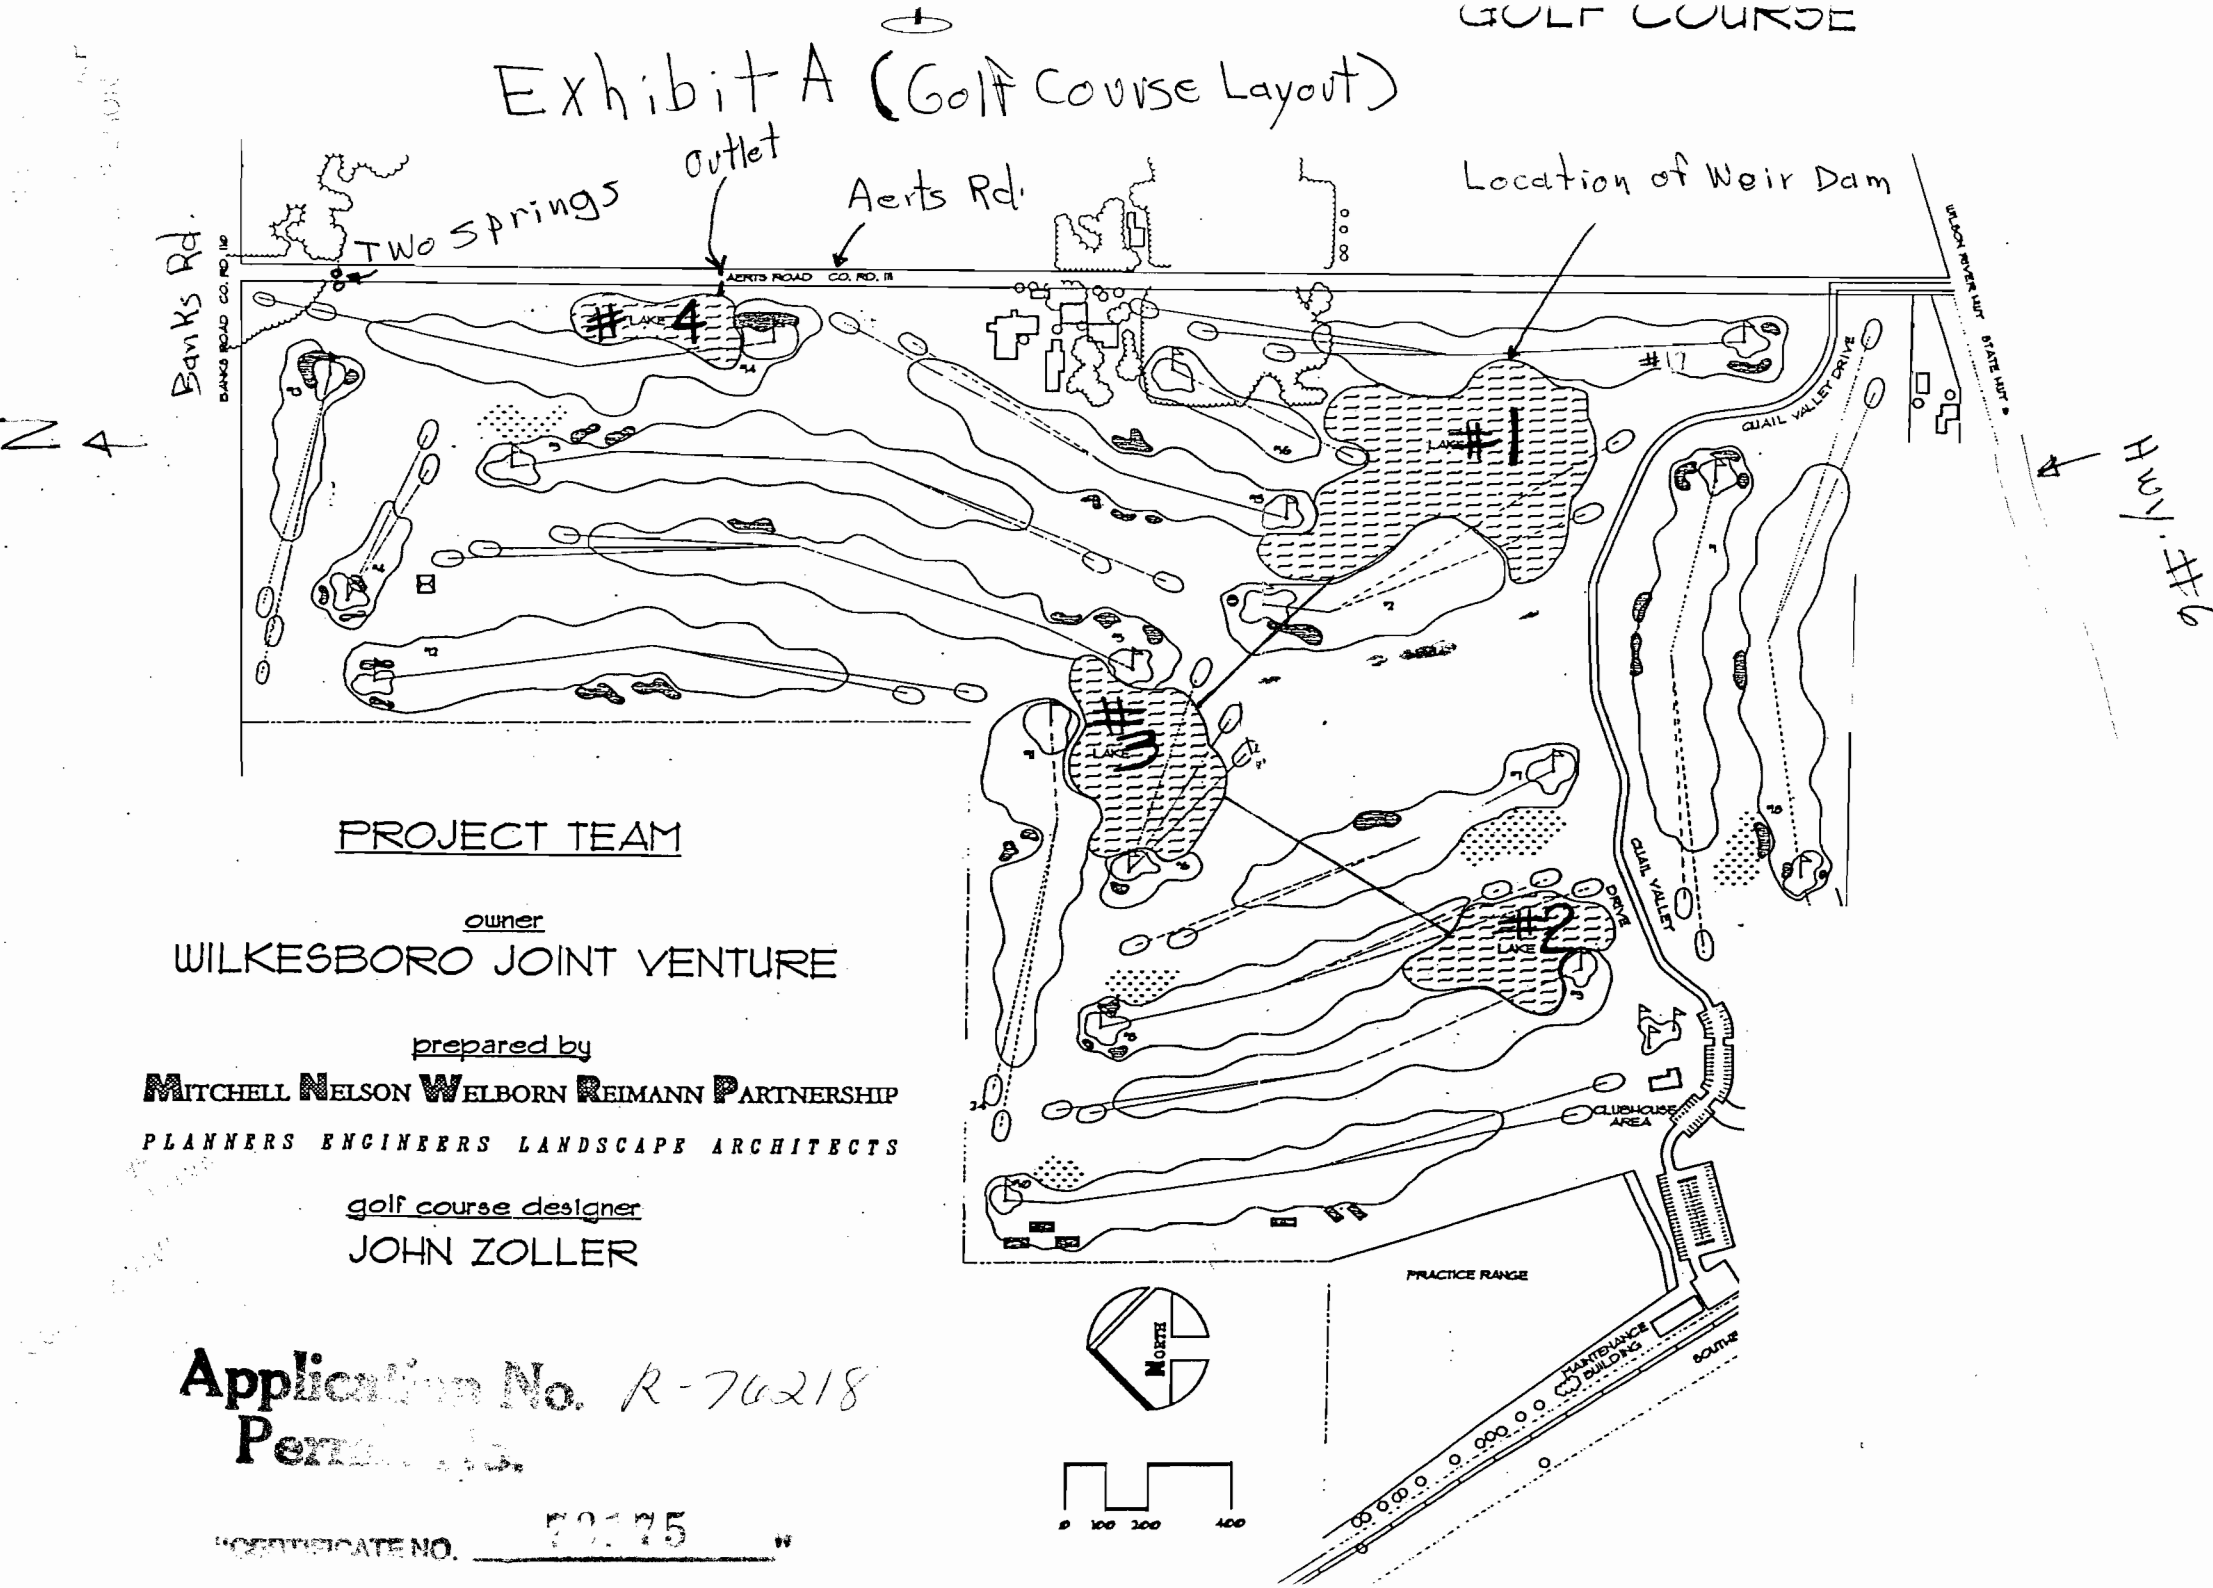

PROJECT TEAM

owner

WILKESBORO JOINT VENTURE

prepared by


MITCHELL NELSON WELBORN REIMANN PARTNERSHIP
PLANNERS ENGINEERS LANDSCAPE ARCHITECTS

golf course designer

JOHN ZOLLER

Application No. R-76218
Permits

CERTIFICATE NO. 70175

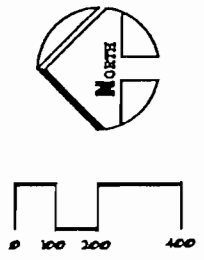

Am. #6