


BELSHAW MEADOWS QUADRANGLE
OREGON-GRANT CO.
7.5 MINUTE SERIES (TOPOGRAPHIC)

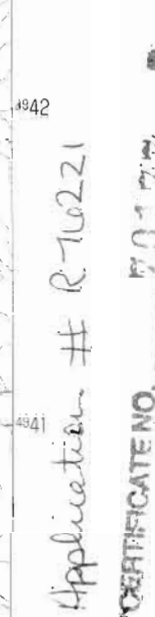

ROAD LEGEND

Improved Road

Unimproved Road 

Trail 

 Interstate Route  U.S. Route  State Route

44119,E2-TF-024