


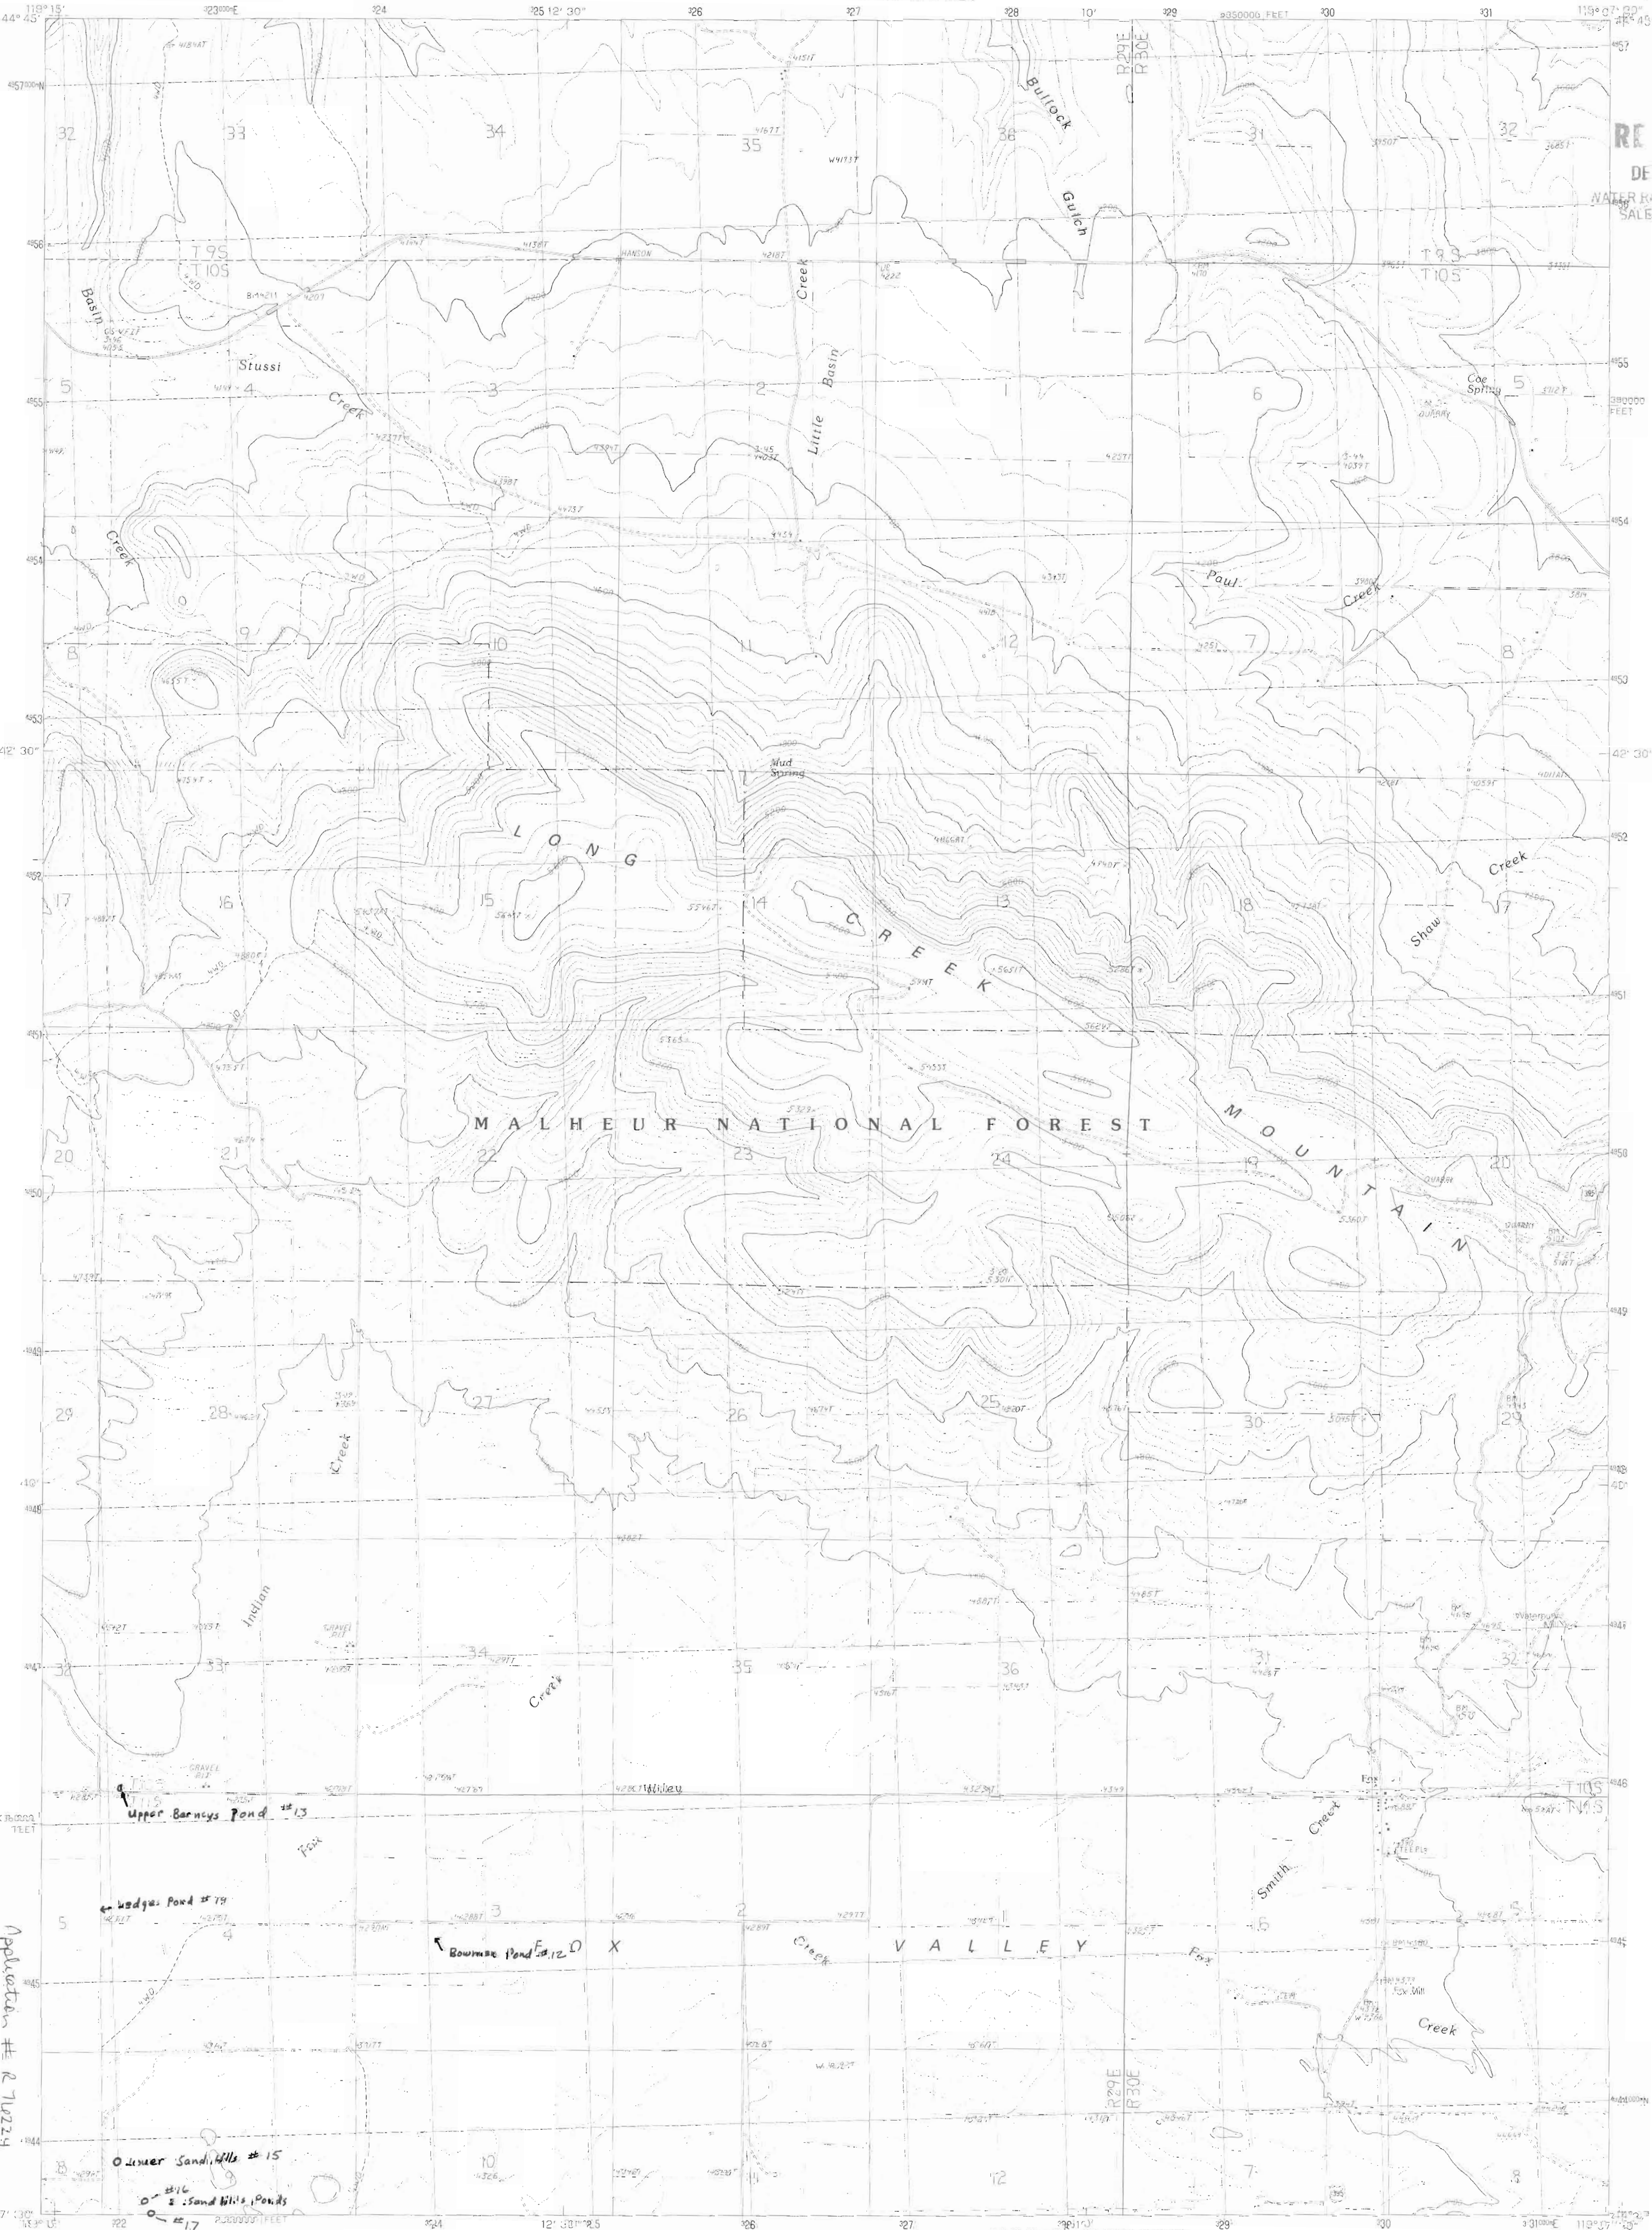

PRODUCED BY THE UNITED STATES GEOLOGICAL SURVEY
CONTROL BY: USGS AND NOS/NOAA
COMPILED FROM: AERIAL PHOTOGRAPHS TAKEN: 1984
FIELD CHECKED: 1987 MAP EDITED: 1989
PROJECTION: LAMBERT CONFORMAL CONIC
GRID: 1000-METER UNIVERSAL TRANSVERSE MERCATOR, ZONE 11
170,000-FOOT STATE GRID TICS: OREGON, NORTH ZONE
1718 GRID DECLINATION: 1.32 WEST
1990 MAGNETIC NORTH DECLINATION: 18.00 EAST
VERTICAL DATUM: 1927 NORTH-AMERICAN DATUM
To place on the predicted North American Datum of 1983,
move the projection lines as shown by dashed corner ticks
(19 meters north and 85 meters east)
There may be private inholdings within the boundaries of any
Federal or State reservations shown on this map

PROVISIONAL MAP
Produced from original
manuscript drawings. Infor-
mation shown as of date of
field check.

SCALE 1:24 000
KILOMETERS
METERS
MILES
CONTOUR INTERVAL 40 FEET
SUPPLEMENTARY CONTOUR INTERVAL 10 FEET
To convert meters to feet, multiply by 1.2508
To convert feet to meters, multiply by .3048
THIS MAP COMPLIES WITH NATIONAL MAP ACCURACY STANDARDS
FOR SALE BY U.S. GEOLOGICAL SURVEY
DENVER, COLORADO 80225, OR RESTON, VIRGINIA 22092

ROAD LEGEND
Improved Road
Unimproved Road
Trail
Interstate Route
U.S. Route
State Route
QUADRANGLE LOCATION
FOX, OREGON
PROVISIONAL EDITION 1990
94119-F2-TF-024



PRODUCED BY THE UNITED STATES GEOLOGICAL SURVEY
CONTROL BY: USGS AND NOS/NOAA
COMPILED FROM AERIAL PHOTOGRAPHS TAKEN: 1984
FIELD CHECKED: 1987. MAP EDITED: 1990
PROJECTION: LAMBERT CONFORMAL CONIC
GRID: 1000-METER UNIVERSAL TRANSVERSE MERCATOR, ZONE 11
12,000-FOOT STATE GRID TICKS OREGON NORTH ZONE
UTM GRID DECLINATION: 18° 00' WEST
1990 MAGNETIC NORTH DECLINATION: 18° 00' EAST
VERTICAL DATUM: NATIONAL GEODETIC VERTICAL DATUM OF 1929
HORIZONTAL DATUM: 1927 NORTH AMERICAN DATUM
To place on the predicted North American Datum of 1983,
move the projection lines as shown by dashed corner ticks
(19 meters north and 85 meters east)
There may be private inholdings within the boundaries of any
Federal or State reservations shown on this map

PROVISIONAL MAP
Produced from original
manuscript drawings. Infor-
mation shown as of date of
field check.

THIS MAP COMPLIES WITH NATIONAL MAP ACCURACY STANDARDS
FOR SALE BY U.S. GEOLOGICAL SURVEY
DENVER, COLORADO 80225, OR RESTON, VIRGINIA 22092

SCALE 1:24 000
CONTOUR INTERVAL 40 FEET



1	2	3	1 Monument
4	5	2 Steel Mtn	
6	7	3 Bullock Gulch	
		4 Courthouse Rock	
		5 Fox	
		6 Sheep Ridge	
		7 Donaldson Creek	
		8 Belshaw Meadows	

Improved Road
Unimproved Road
Trail
Interstate Route
U.S. Route
State Route

HAMILTON, OREGON
PROVISIONAL EDITION 1994