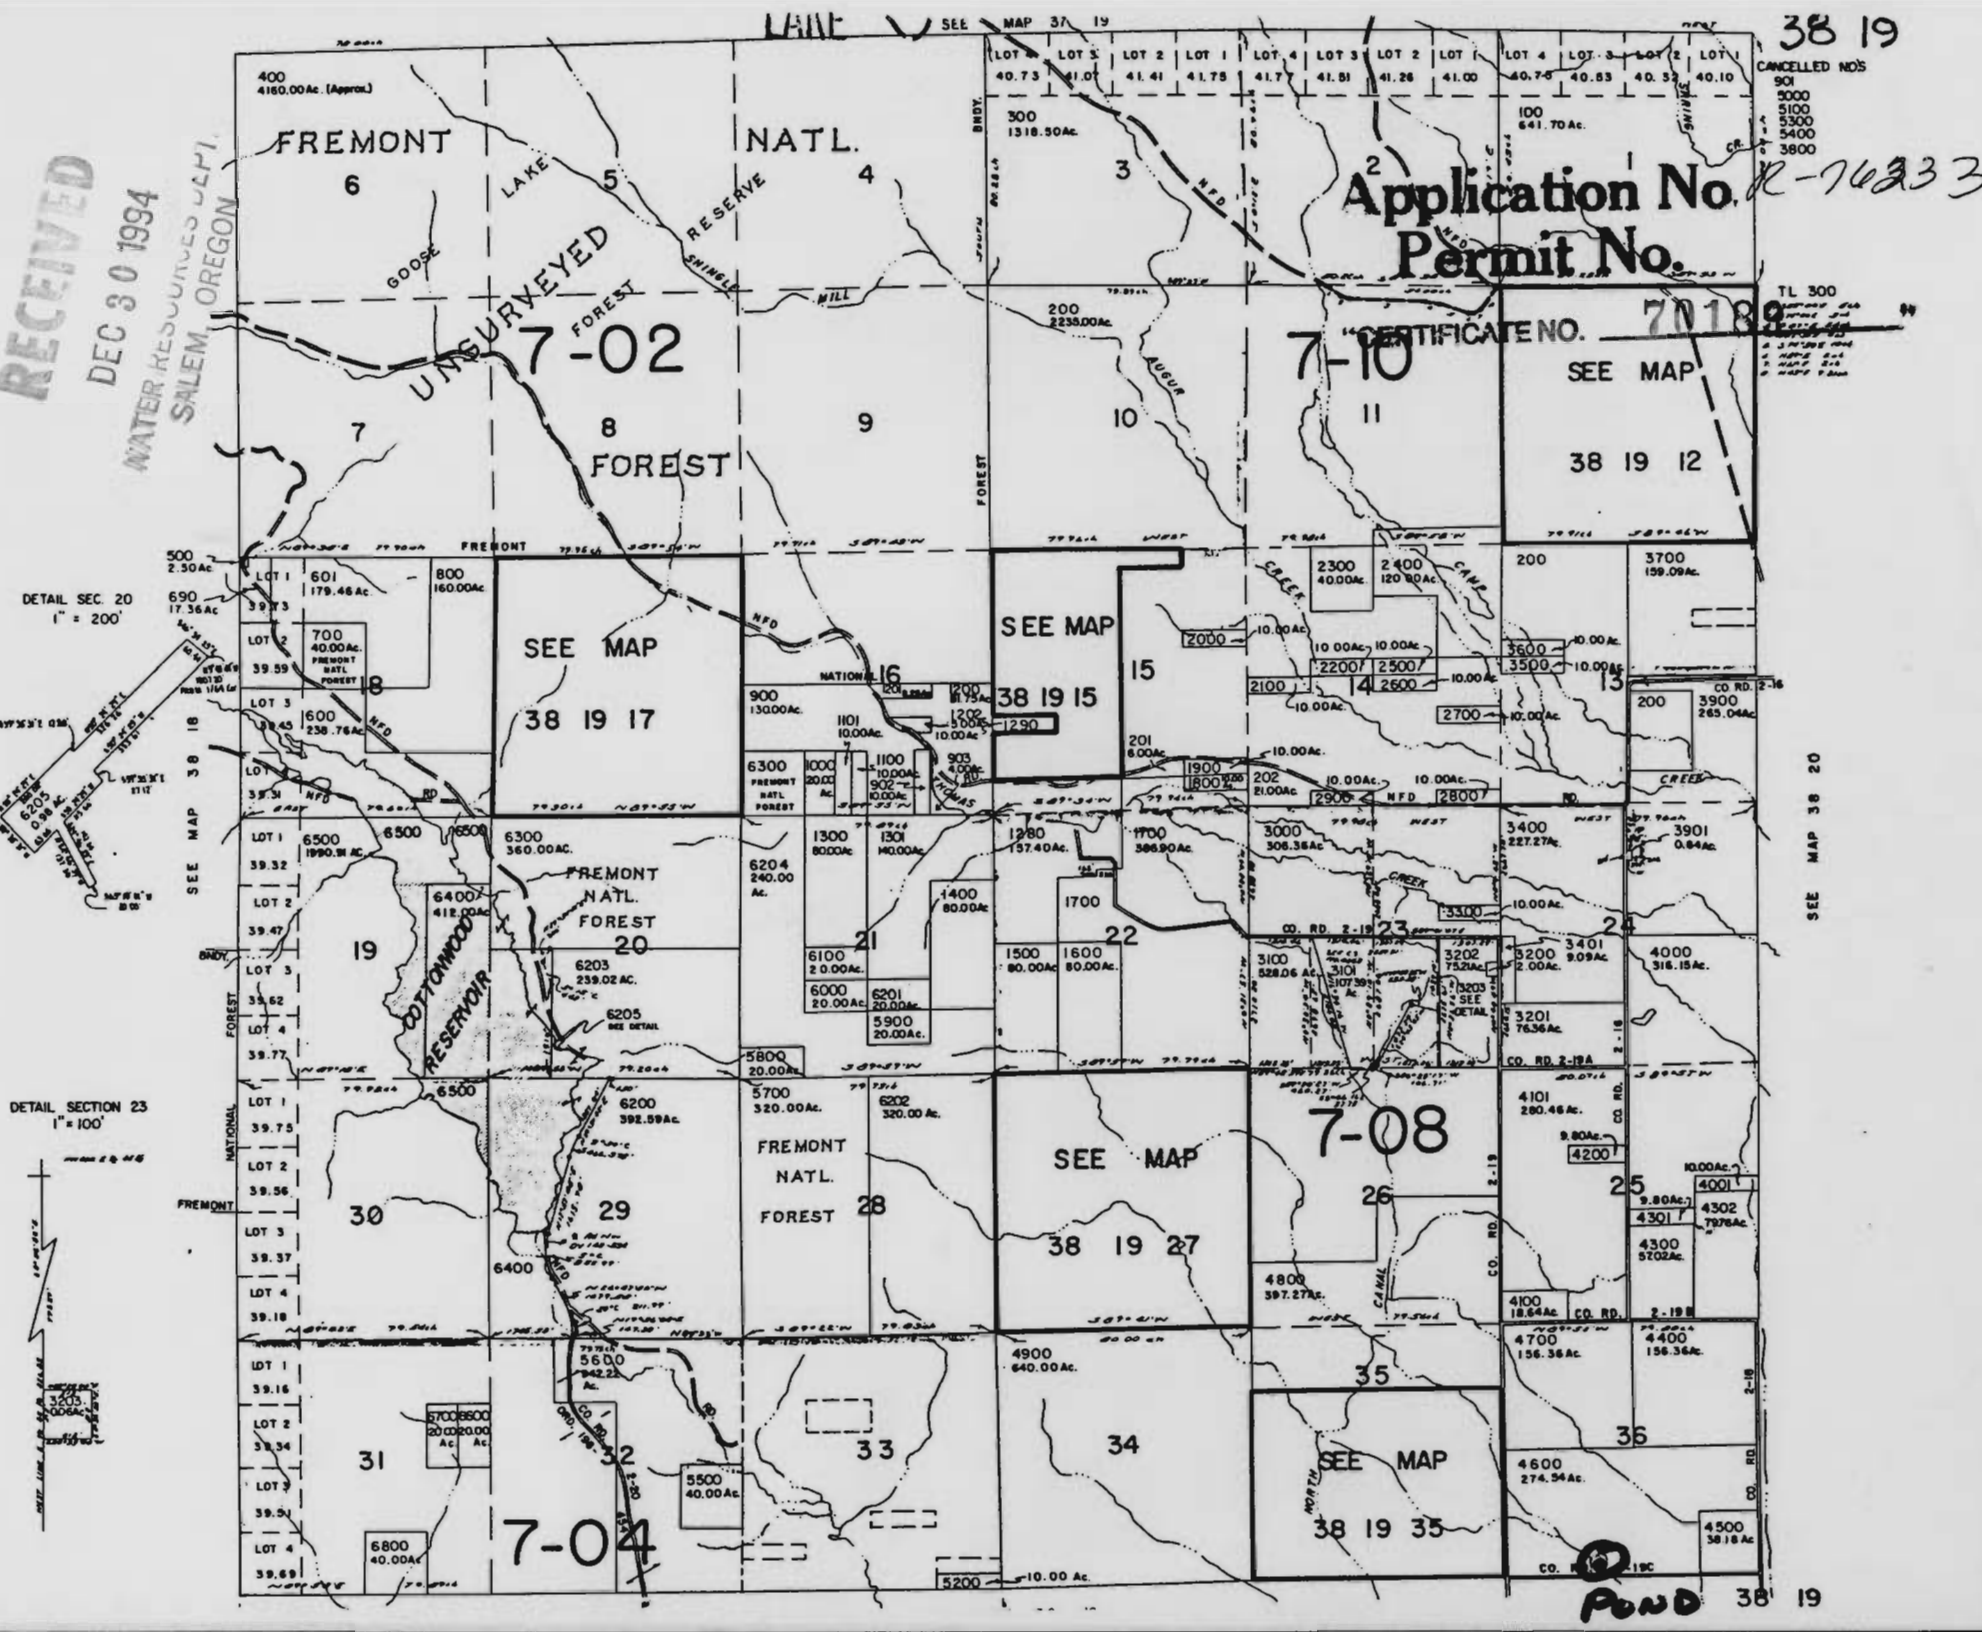
38 19
CANCELLED NOS
901
5000
5100
5300
5400
3800
Application No. R-76233
Permit No.
CERTIFICATE NO. 70189
RECEIVED
DEC 30 1994
WATER RESOURCES DEPT.
SALEM, OREGON
FREMONT NATL. FOREST
UNSURVEYED
7-02
7-10
7-08
7-04
SEE MAP 38 19 17
SEE MAP 38 19 15
SEE MAP 38 19 12
SEE MAP 38 19 27
SEE MAP 38 19 35
DETAIL SEC. 20
1" = 200'
DETAIL SECTION 23
1" = 100'
COTTONWOOD RESERVOIR
POND
38 19