



Application No. R-76235
Permit No.

RECEIVED

DEC 30 1994

WATER RESOURCES DEPT.
SALEM, OREGON

47'30"
TOLLGATE 9.4 MI
ELGIN 31 MI


CERTIFICATE NO.

70191

T3N1236

5067000m N.

BINGHAM SPR
2375 N. N.

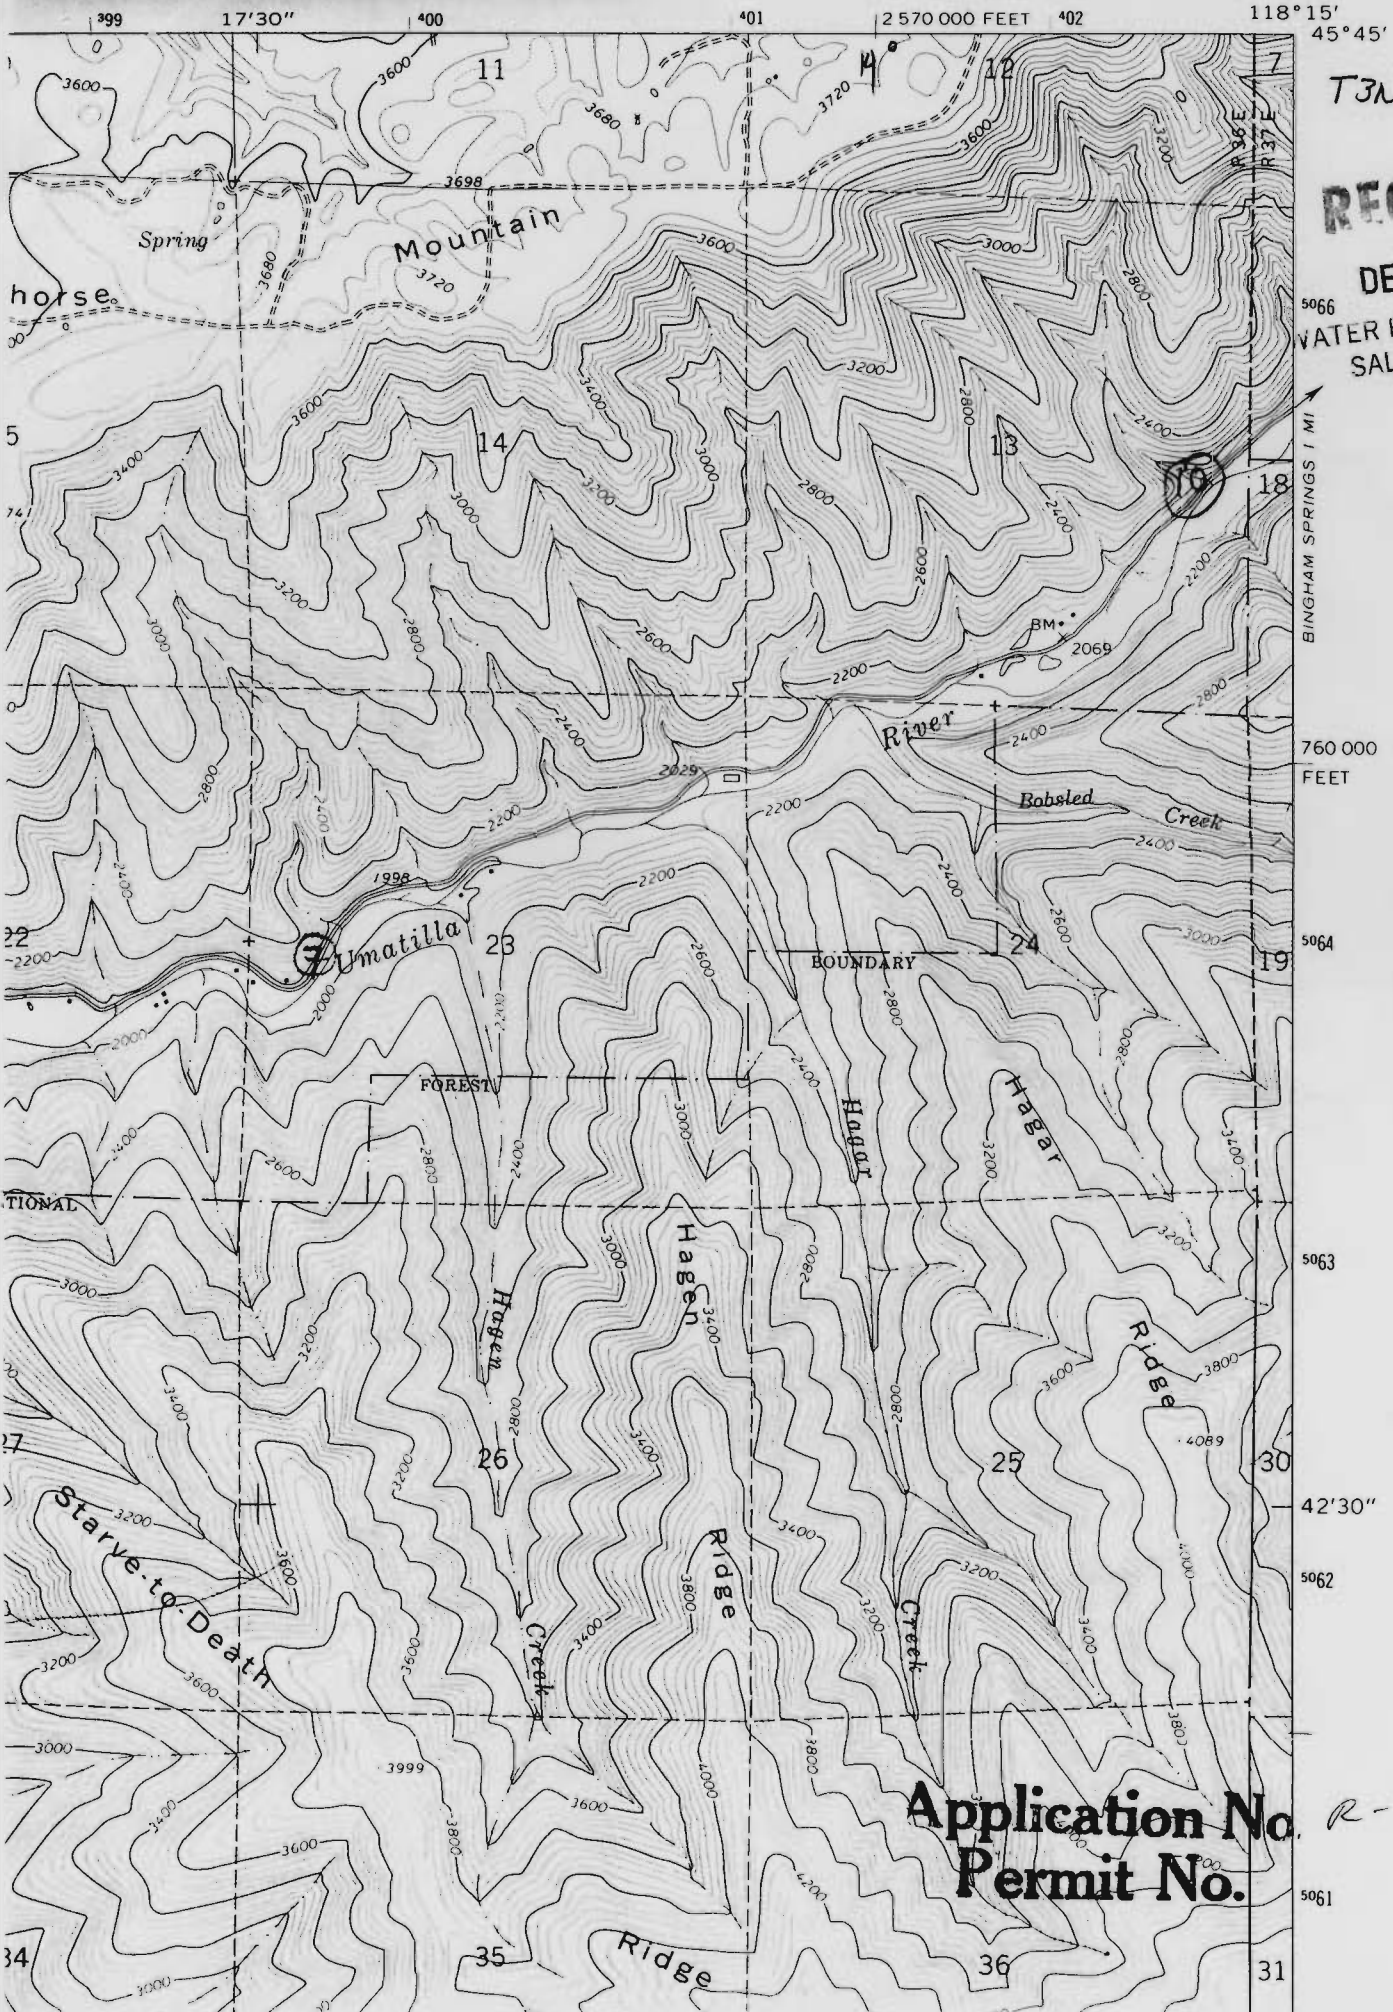

RECEIVED

DEC 30 1994

WATER RESOURCES DEPT.
SALEM, OREGON

CERTIFICATE NO.

70191

Application No.
Permit No.

R-74235