



SCHADLER
RANCH, INC.

SCALE 1:48000

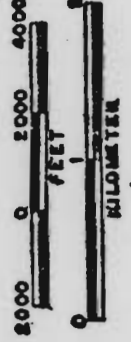

SEE MAP 39 21

RECEIVED

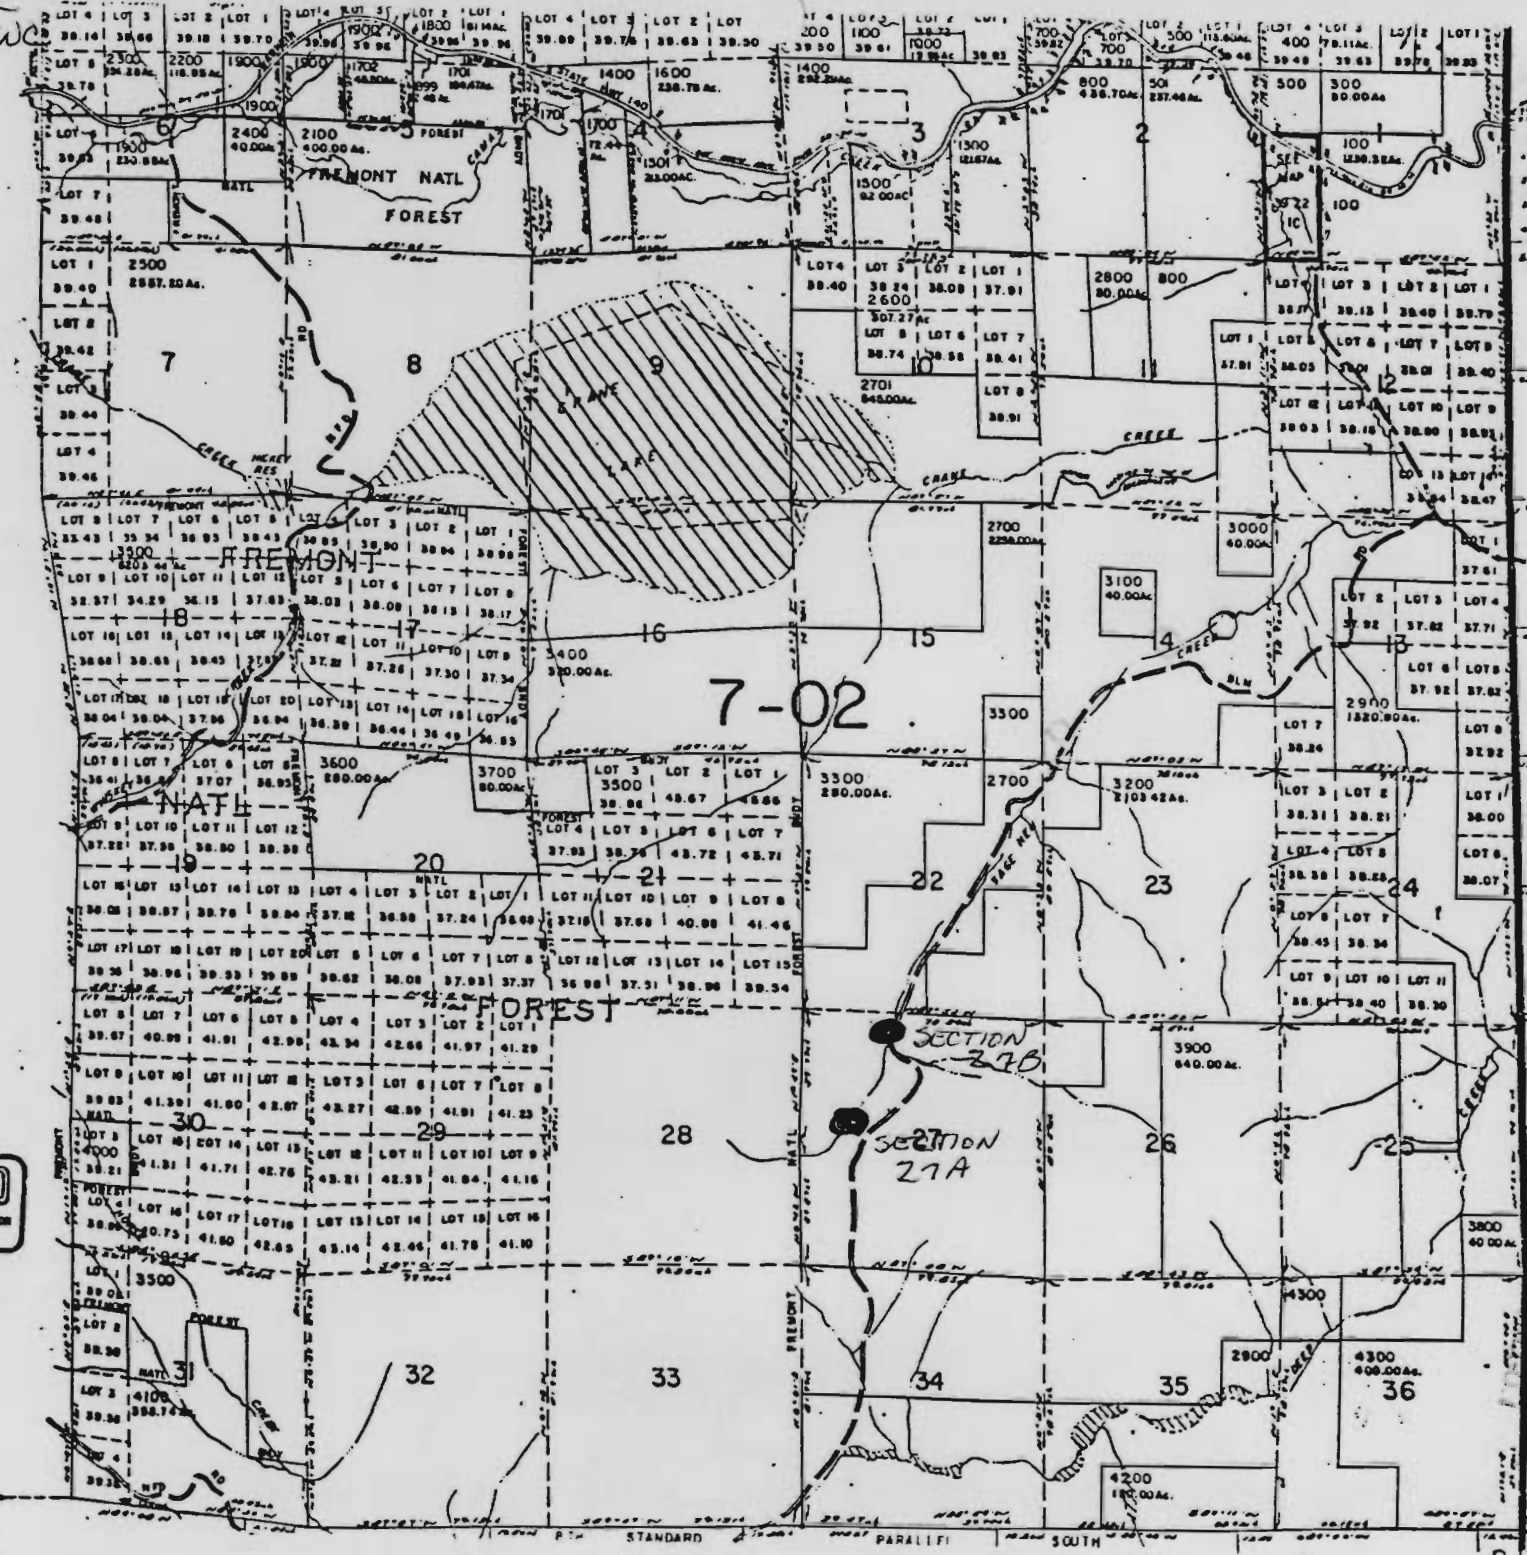

Index

Application No. 2-76239
Permit No. 70195
CERTIFICATE NO.

RECEIVED

DEC 30 1934
WATER RES. SALEN

39 22