

Application No. R-76231

RECEIVED RECEIVED

DEC 30 1994

DEC 30 1994

DEPARTMENT OF THE INTERIOR
BIOLOGICAL SURVEY
MODIFIED PERMIT SERVICE

Permit No.

DOO LAKE QUADRANGLE
ON 100-11-1994
15 MINUTE SERIES (1:50,000)
WATER RESOURCES
SHEM-11-1994
WATER RESOURCES DEPT.


P. O. BOX 1340
LAKEVIEW, OR 97630

947-2018

FRENCH HILL COMPANY

26102

CERTIFICATE NO.

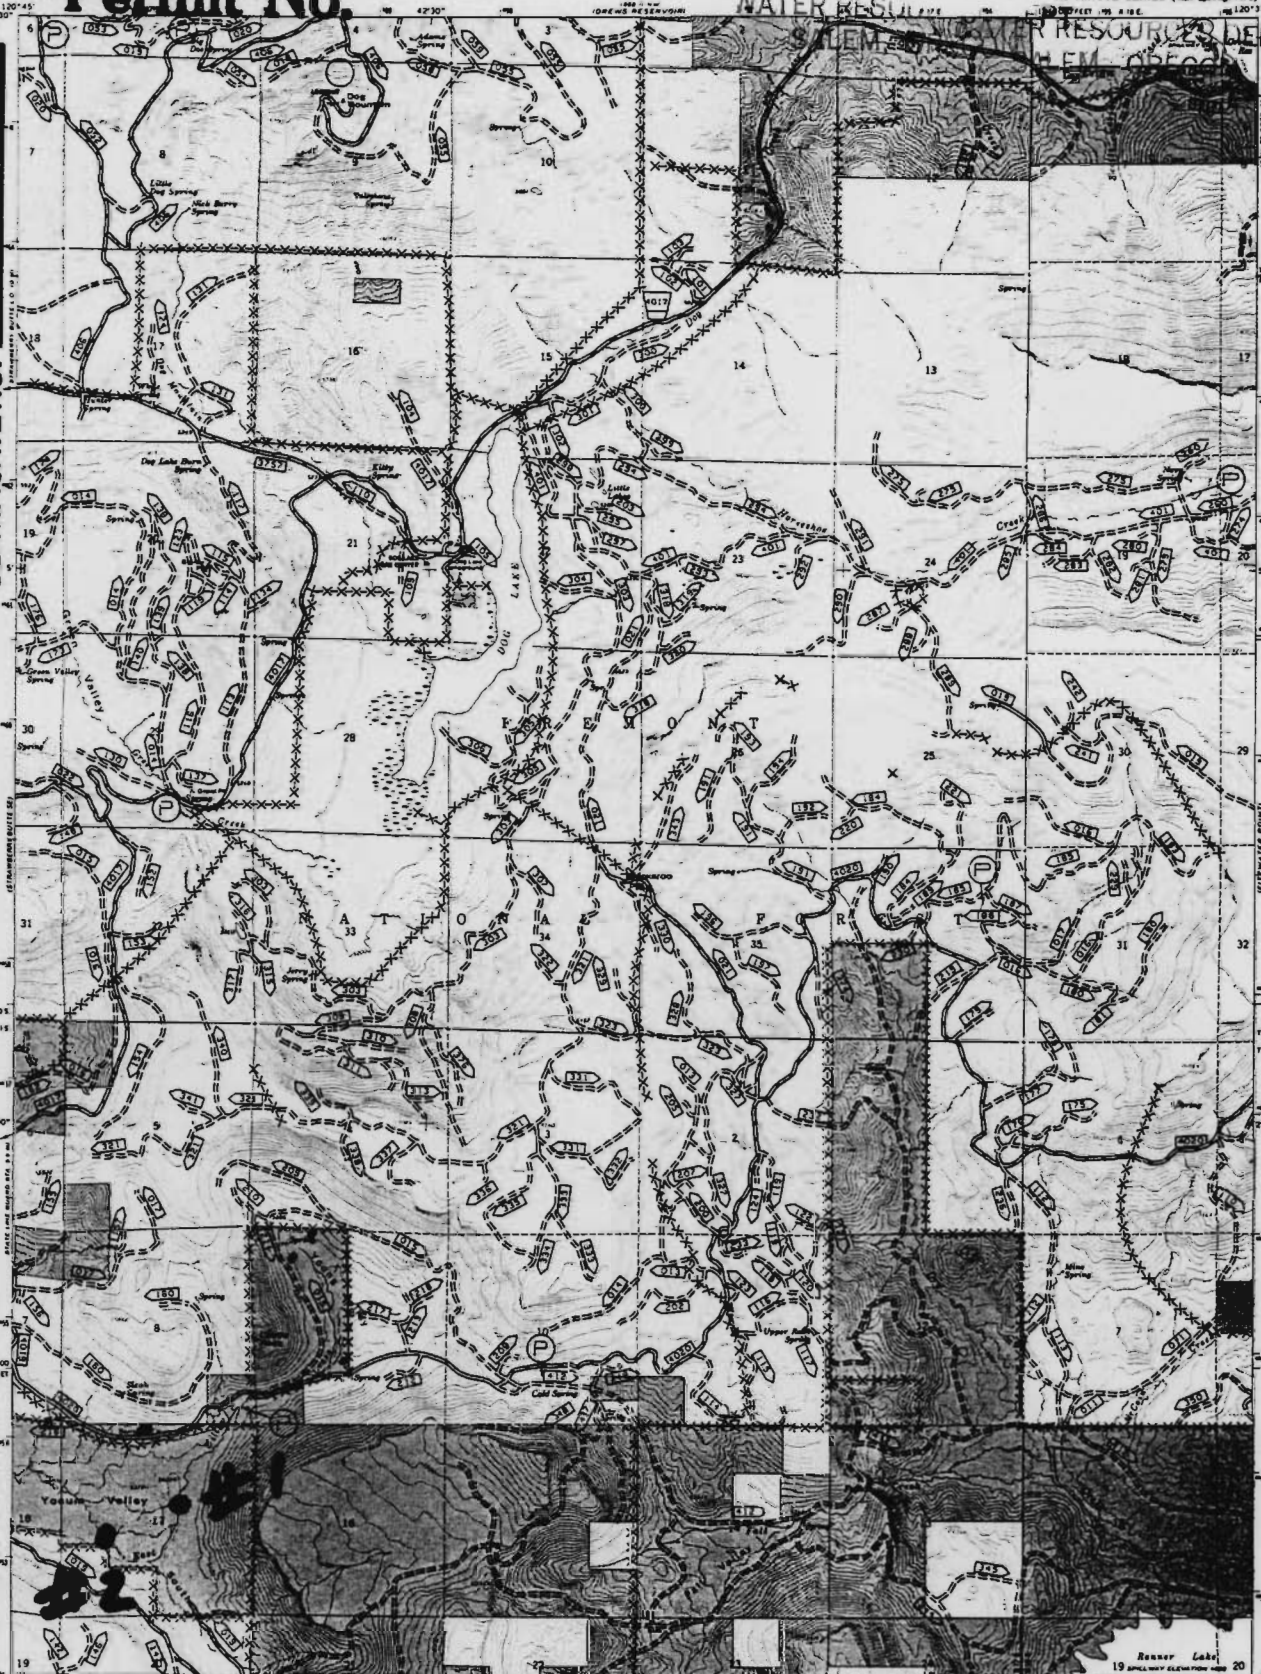

TRANSPORTATION SYSTEM UPDATE	
	PRIMARY HIGHWAY
	SECONDARY HIGHWAY
	IMPROVED ROAD
	IMPROVED ROAD SHOULDER
	IMPROVED ROAD GRVEL
	UNIMPROVED RD
	TRAIL
	INTERSTATE HIGHWAY
	US HIGHWAY
	OREGON STATE HIGHWAY
	WASHINGTON STATE HIGHWAY
	COUNTY ROAD
	MF MATERIAL
	MF COLLECTOR
	MF LOCAL
	TRAIL
	FOREST HIGHWAY
	PRIVATE ROAD
	BRIDGE
	ROAD TURN-OFF
	DITCH
	BLOCKED ROAD
	ROAD PARTIALLY OPENED

CONTRACTED BY THE REGIONAL OFFICE, PORTLAND, OREGON, IN 1987 FROM U.S. FOREST SERVICE PERMITTEE STATE BOARD AND U.S. GEOLOGICAL SURVEY. DIMENSIONS, ROAD WIDTHS, AND ROAD SPACING ARE CONTROLLED BY THE FOREST SERVICE. ROAD WIDTHS ARE SHOWN IN FEET. ROAD SPACING IS SHOWN IN FEET. 

Base map prepared by the U.S. Geological Survey
Control by USGS and NGS/NOAA
Topography by photogrammetric methods from aerial photographs taken 1960. 7 and checked 1964.
Photographic projection, 1927 North American datum, 10,000-foot grid based on Oregon coordinate system, south zone.
1000-meter Universal Transverse Mercator grid ticks, zone 10, known - 4.
To place on the predicted North American Datum 1983, raise the elevation lines 18 meters north and 90 meters east as shown by dashed corner data.
Few red dashed lines indicate former fence lines.
There may be gross encroachments within the boundaries of the National or State Reservations shown on this map.
Modification to USGS base map by the Geomorphics Service Center from 1979 aerial photography and 1982 contour data furnished by the Pacific Northwest Region.
Landscape oriented according to additional Forest Service materials.



SCALE 1:24,000
CONTOUR INTERVAL 20 FEET
DOTTED LINES REPRESENT FORMER CONTOURS
NATIONAL GEOGRAPHIC DATUM OF 1929
LEGEND
National Forest Boundary
Altered Land within the National Forest Boundary as of June 1983
Special Area Boundary
TOWNSHIP AND SECTION LINE CLASSIFICATION
Surveyed, Location (Unusable)
Surveyed, Location (Usable)
Unsurveyed, Proposed



DOO LAKE, OREG.
N4200-112037.5/7.5
1986
PHOTO REVISSED 1980
DMA 1:50,000 15-MINUTE SERIES

77