

SECTION 24 T.24S. R.7W. W.M.
DOUGLAS COUNTY

REVISED ON
8-8-94

24 7 24


WAS PREPARED FOR
ENT PURPOSE ONLY.

1"=400'

Application No. *R-76246*
Permit No.

CANCELLED NO.S
902

"CERTIFICATE NO. 70202"

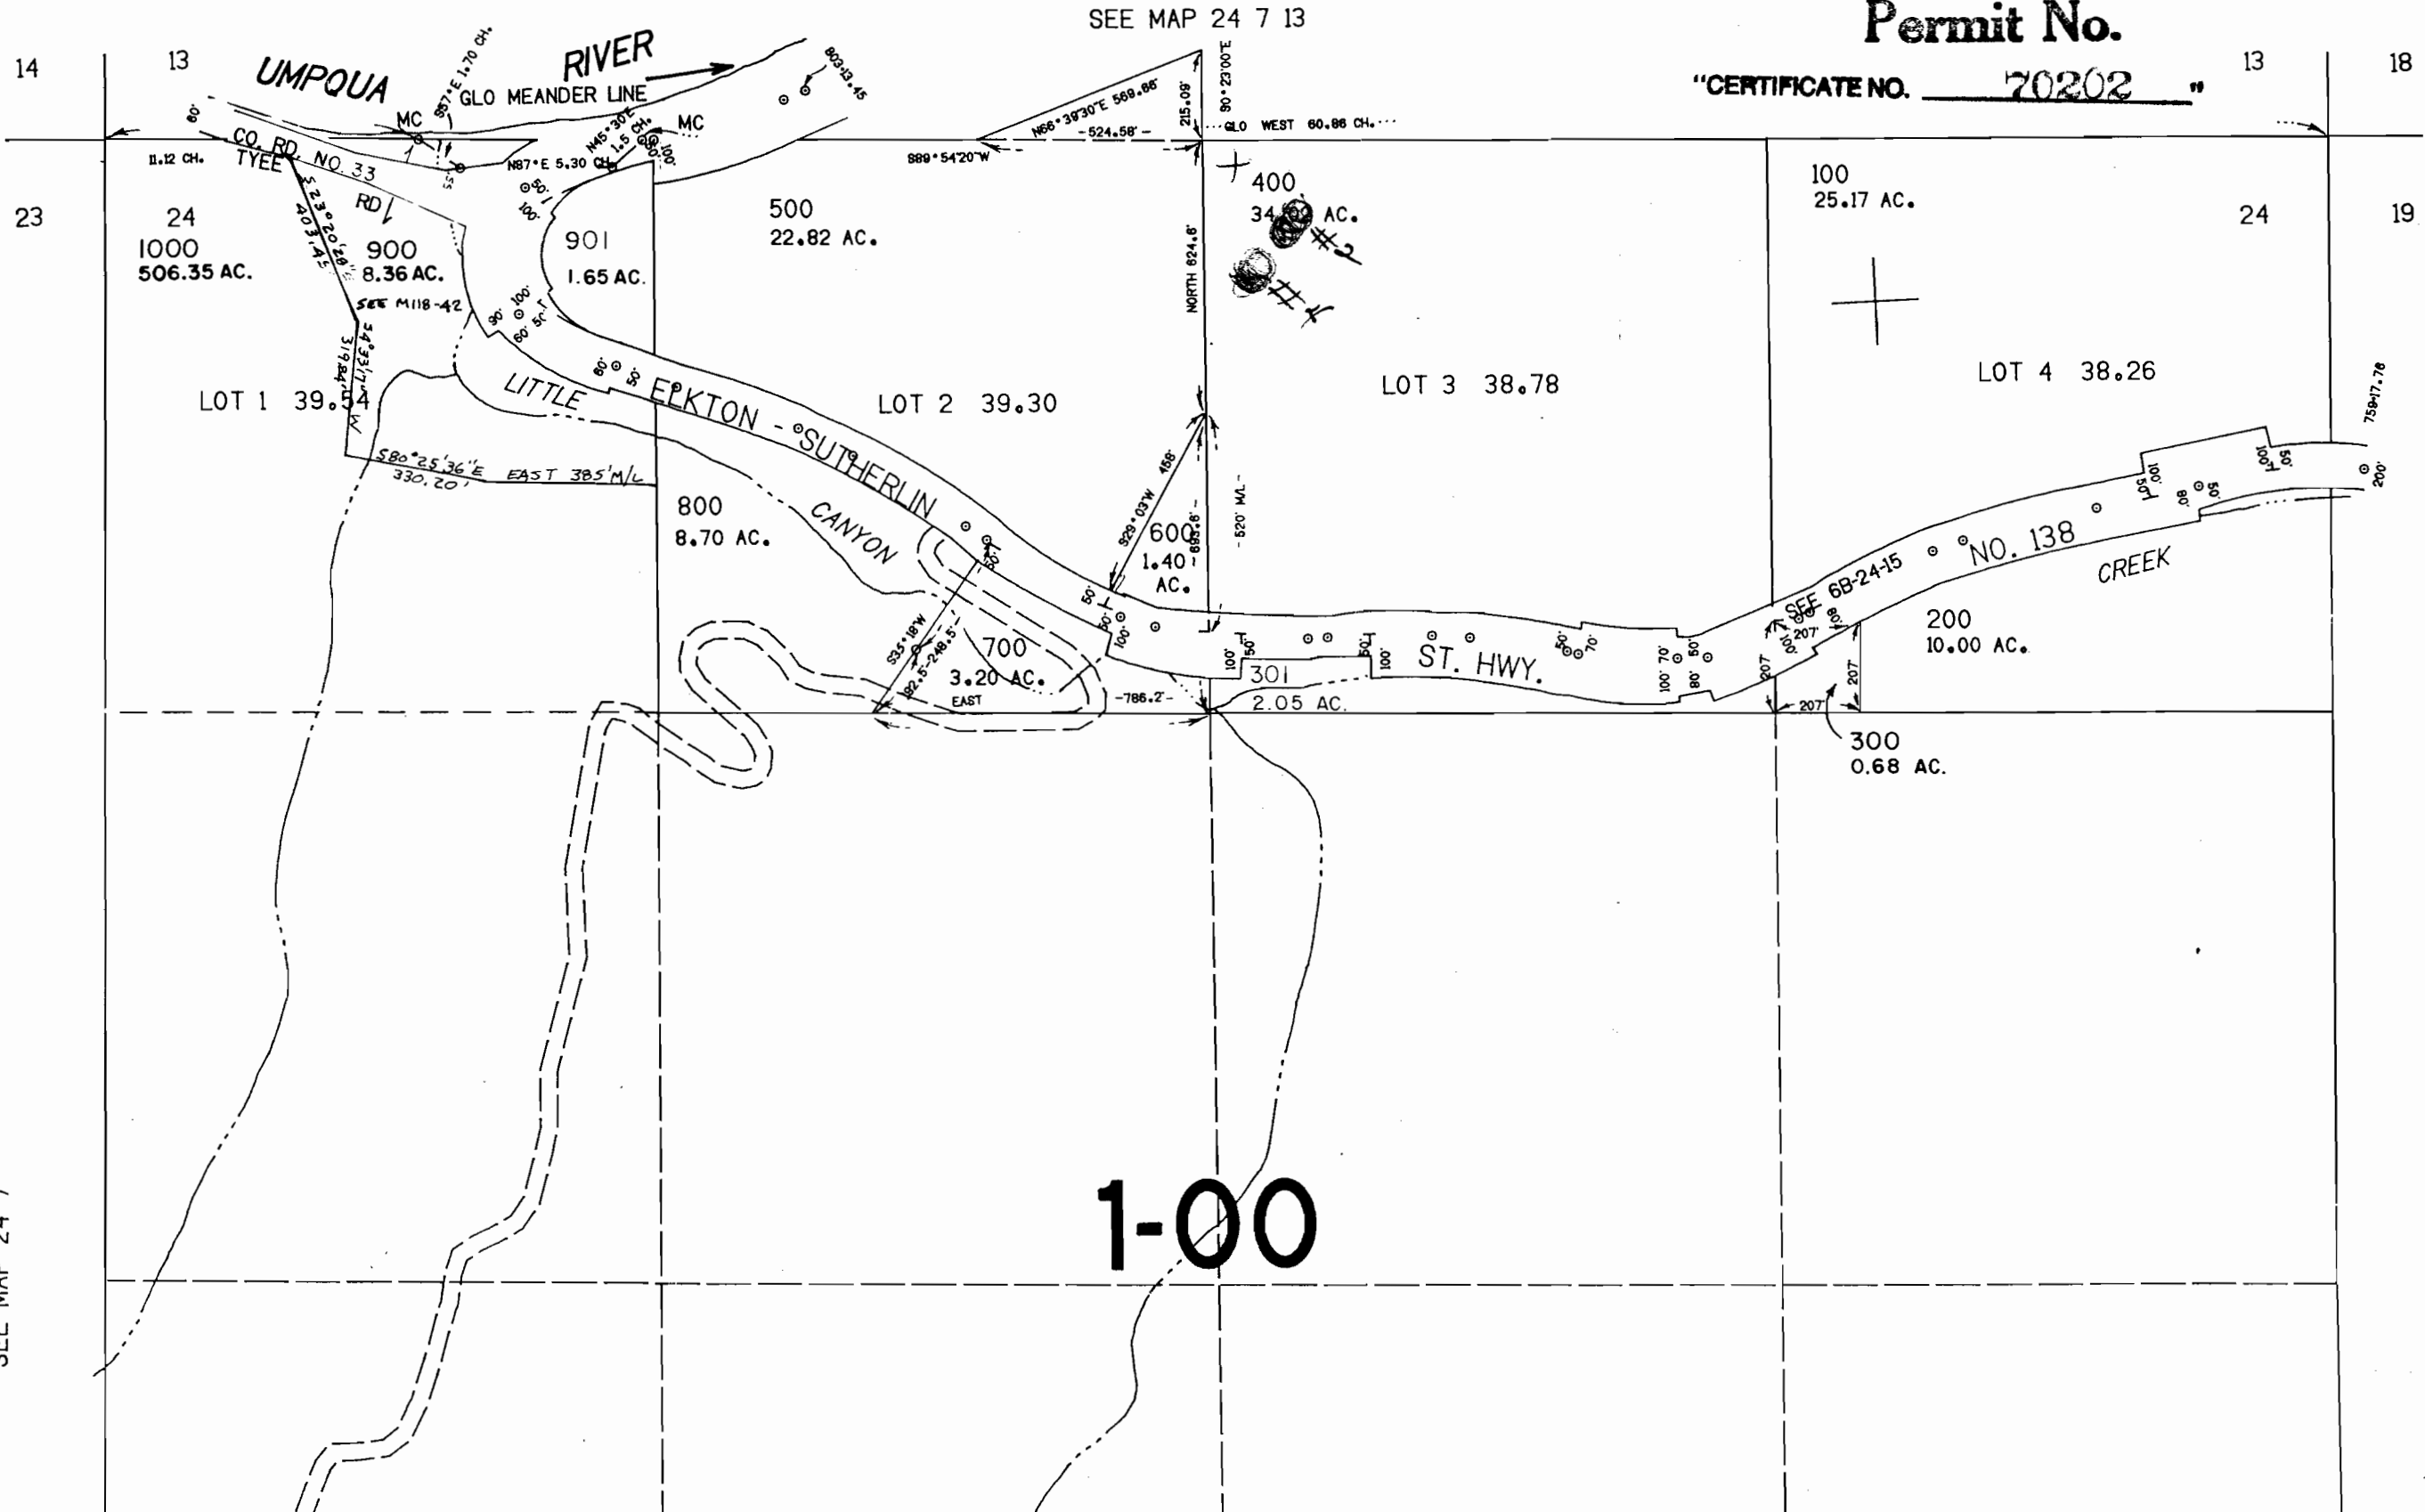

SECTION 18 T.24S. R.6W. W.M.
DOUGLAS COUNTY

1"=400'

23
DEC 1904
RECORDED
JAN 1905

S MAP WAS PREPARED FOR
ASSESSMENT PURPOSE ONLY.

Application No. *R-96246*
Permit No.

"CERTIFICATE NO. 70202"

SEE MAP 24 6

QLO N89°55'E 81.94 CH

