


1"=400'

T28S, R5W, S12

SEE MAP 28 5 1

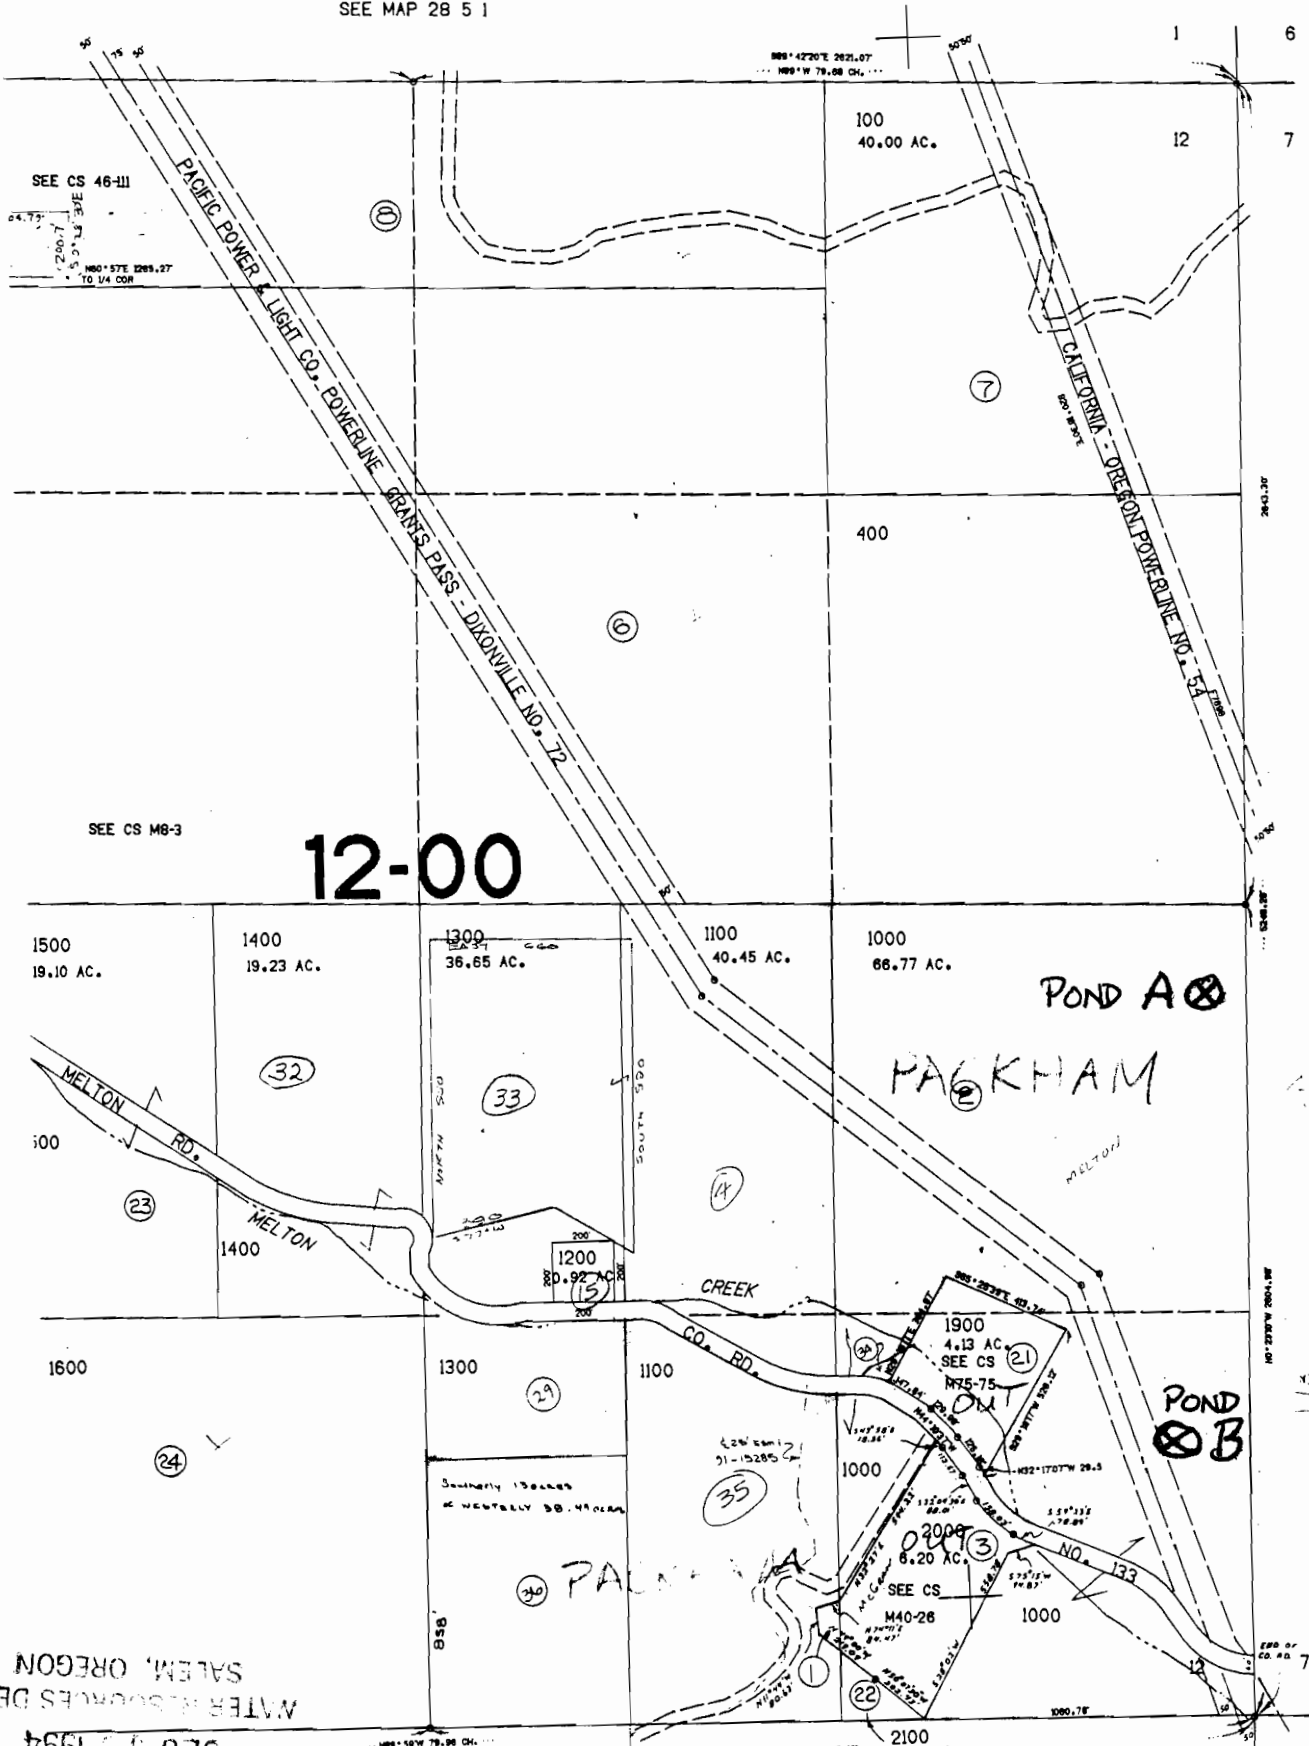

SEE CS M8-3

12-00

SEE MAP 28 4 7

WATER RESOURCES DEPT.
SALEM, OREGON

SEE MAP 28 5 3

Application No. R-76247

Permit No.

70203 28

CERTIFICATE NO.