



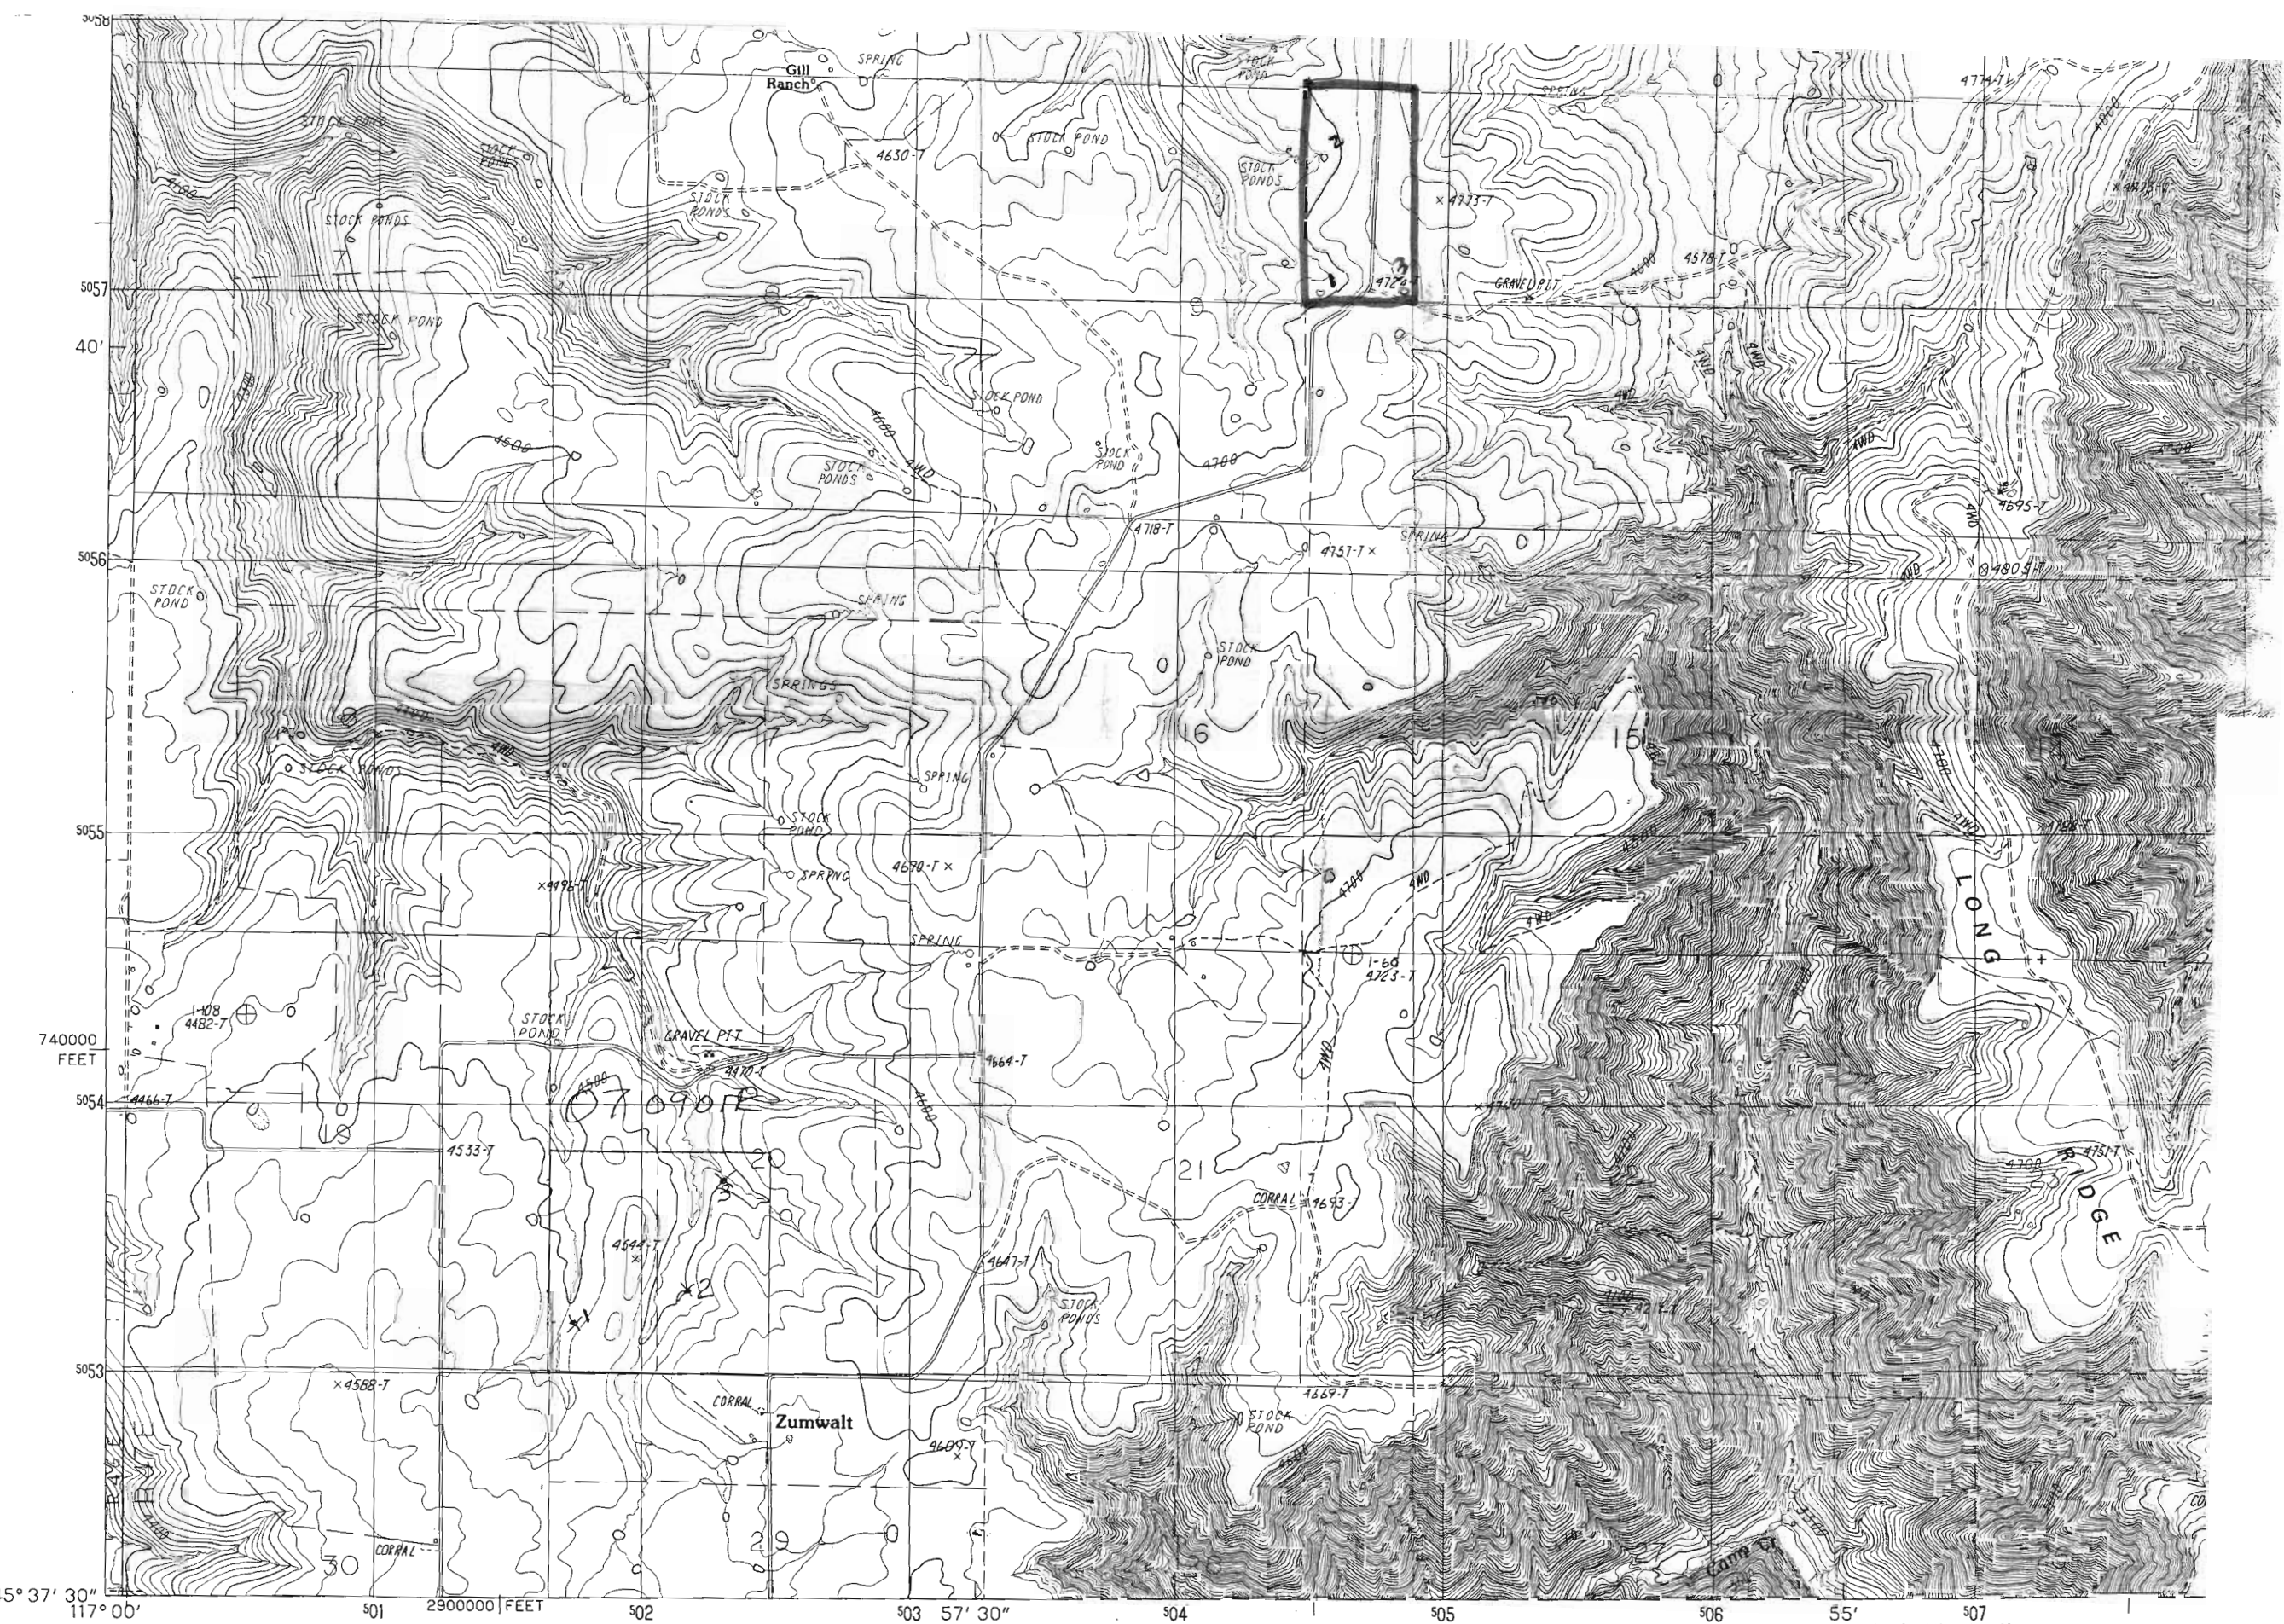

PRODUCED BY THE UNITED STATES GEOLOGICAL SURVEY  
 CONTROL BY.....USGS AND NOS/NOAA  
 COMPILED FROM AERIAL PHOTOGRAPHS TAKEN.....1984  
 FIELD CHECKED.....1987. MAP EDITED.....1990  
 PROJECTION.....LAMBERT CONFORMAL CONIC  
 GRID: 1000-METER UNIVERSAL TRANSVERSE MERCATOR.....ZONE 11  
 10,000-FOOT STATE GRID TICKS.....OREGON, NORTH ZONE  
 UTM GRID DECLINATION.....0°03' EAST  
 1990 MAGNETIC NORTH DECLINATION.....17°30' EAST  
 VERTICAL DATUM.....NATIONAL GEODETIC VERTICAL DATUM OF 1929  
 HORIZONTAL DATUM.....1927 NORTH AMERICAN DATUM  
 To place on the predicted North American Datum of 1983,  
 move the projection lines as shown by dashed corner ticks  
 (17 meters north and 78 meters east)  
 There may be private inholdings within the boundaries of any  
 Federal or State reservations shown on this map  
 Certain land lines are omitted because of insufficient data

Date

**PROVISIONAL MAP**  
 Produced from original  
 manuscript drawings. Infor-  
 mation shown as of date of  
 field check.

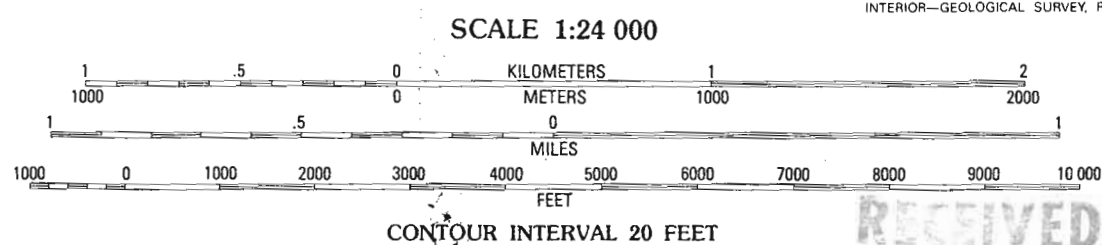

THIS MAP COMPLIES WITH NATIONAL MAP ACCURACY STANDARDS  
 FOR SALE BY U. S. GEOLOGICAL SURVEY  
 DENVER, COLORADO 80225, OR RESTON, VIRGINIA 22060

"CERTIFICATE NO. 70205"

Application No.  
 Permit No.

|   |   |   |                 |
|---|---|---|-----------------|
| 1 | 2 | 3 | 1 Billy Meadows |
| 4 |   | 5 | 2 Poison Point  |
| 6 | 7 | 8 | 3 Deadhorse F   |
|   |   |   | 4 Greenwood     |
|   |   |   | 5 Haas Hollow   |
|   |   |   | 6 Elk Mountain  |
|   |   |   | 7 Findley Butt  |
|   |   |   | 8 Innaha        |

ADJOINING 7.5' QUADRANGLE NA