

21

25

26

20

SCALE 1:24,000
 0 1000 2000 3000 4000 5000 6000 7000 FEET
 0 1 KILOMETER

CONTOUR INTERVAL 10 FEET
 NATIONAL GEODETIC VERTICAL DATUM OF 1929



QUADRANGLE LOCATION

ROAD CLASSIFICATION
 Heavy-duty ——— Light-duty ———
 Medium-duty ——— Unimproved dirt - - - - -
 Interstate Route U.S. Route State Route

BEAVERTON, OREG.
 NE/4 BEAVERTON 15' QUADRANGLE
 45122-D7-TF-024

COMPLIES WITH NATIONAL MAP ACCURACY STANDARDS
 NATIONAL GEODETIC SURVEY, DENVER, COLORADO 80225, OR RESTON, VIRGINIA 22092
 LIST OF TOPOGRAPHIC MAPS AND SYMBOLS IS AVAILABLE ON REQUEST

Revisions shown in purple compiled by Geological Survey
 from aerial photographs taken 1981 and other sources
 This information not field check. Map edited 1984
 Purple tint indicates extension of urban areas

1961
 PHOTOREVISED 1984
 1:24,000 1474 IV (NE)-SERIES V892

CERTIFICATE NO. 70209

Application No. R-76253
 Permit No.


SE 1/4 SE 1/4 SECTION 2 T2S RIW W.M.

WASHINGTON COUNTY OREGON

SCALE 1" = 100'

CERTIFICATE NO. 78809

Application No R-76253
Permit No.

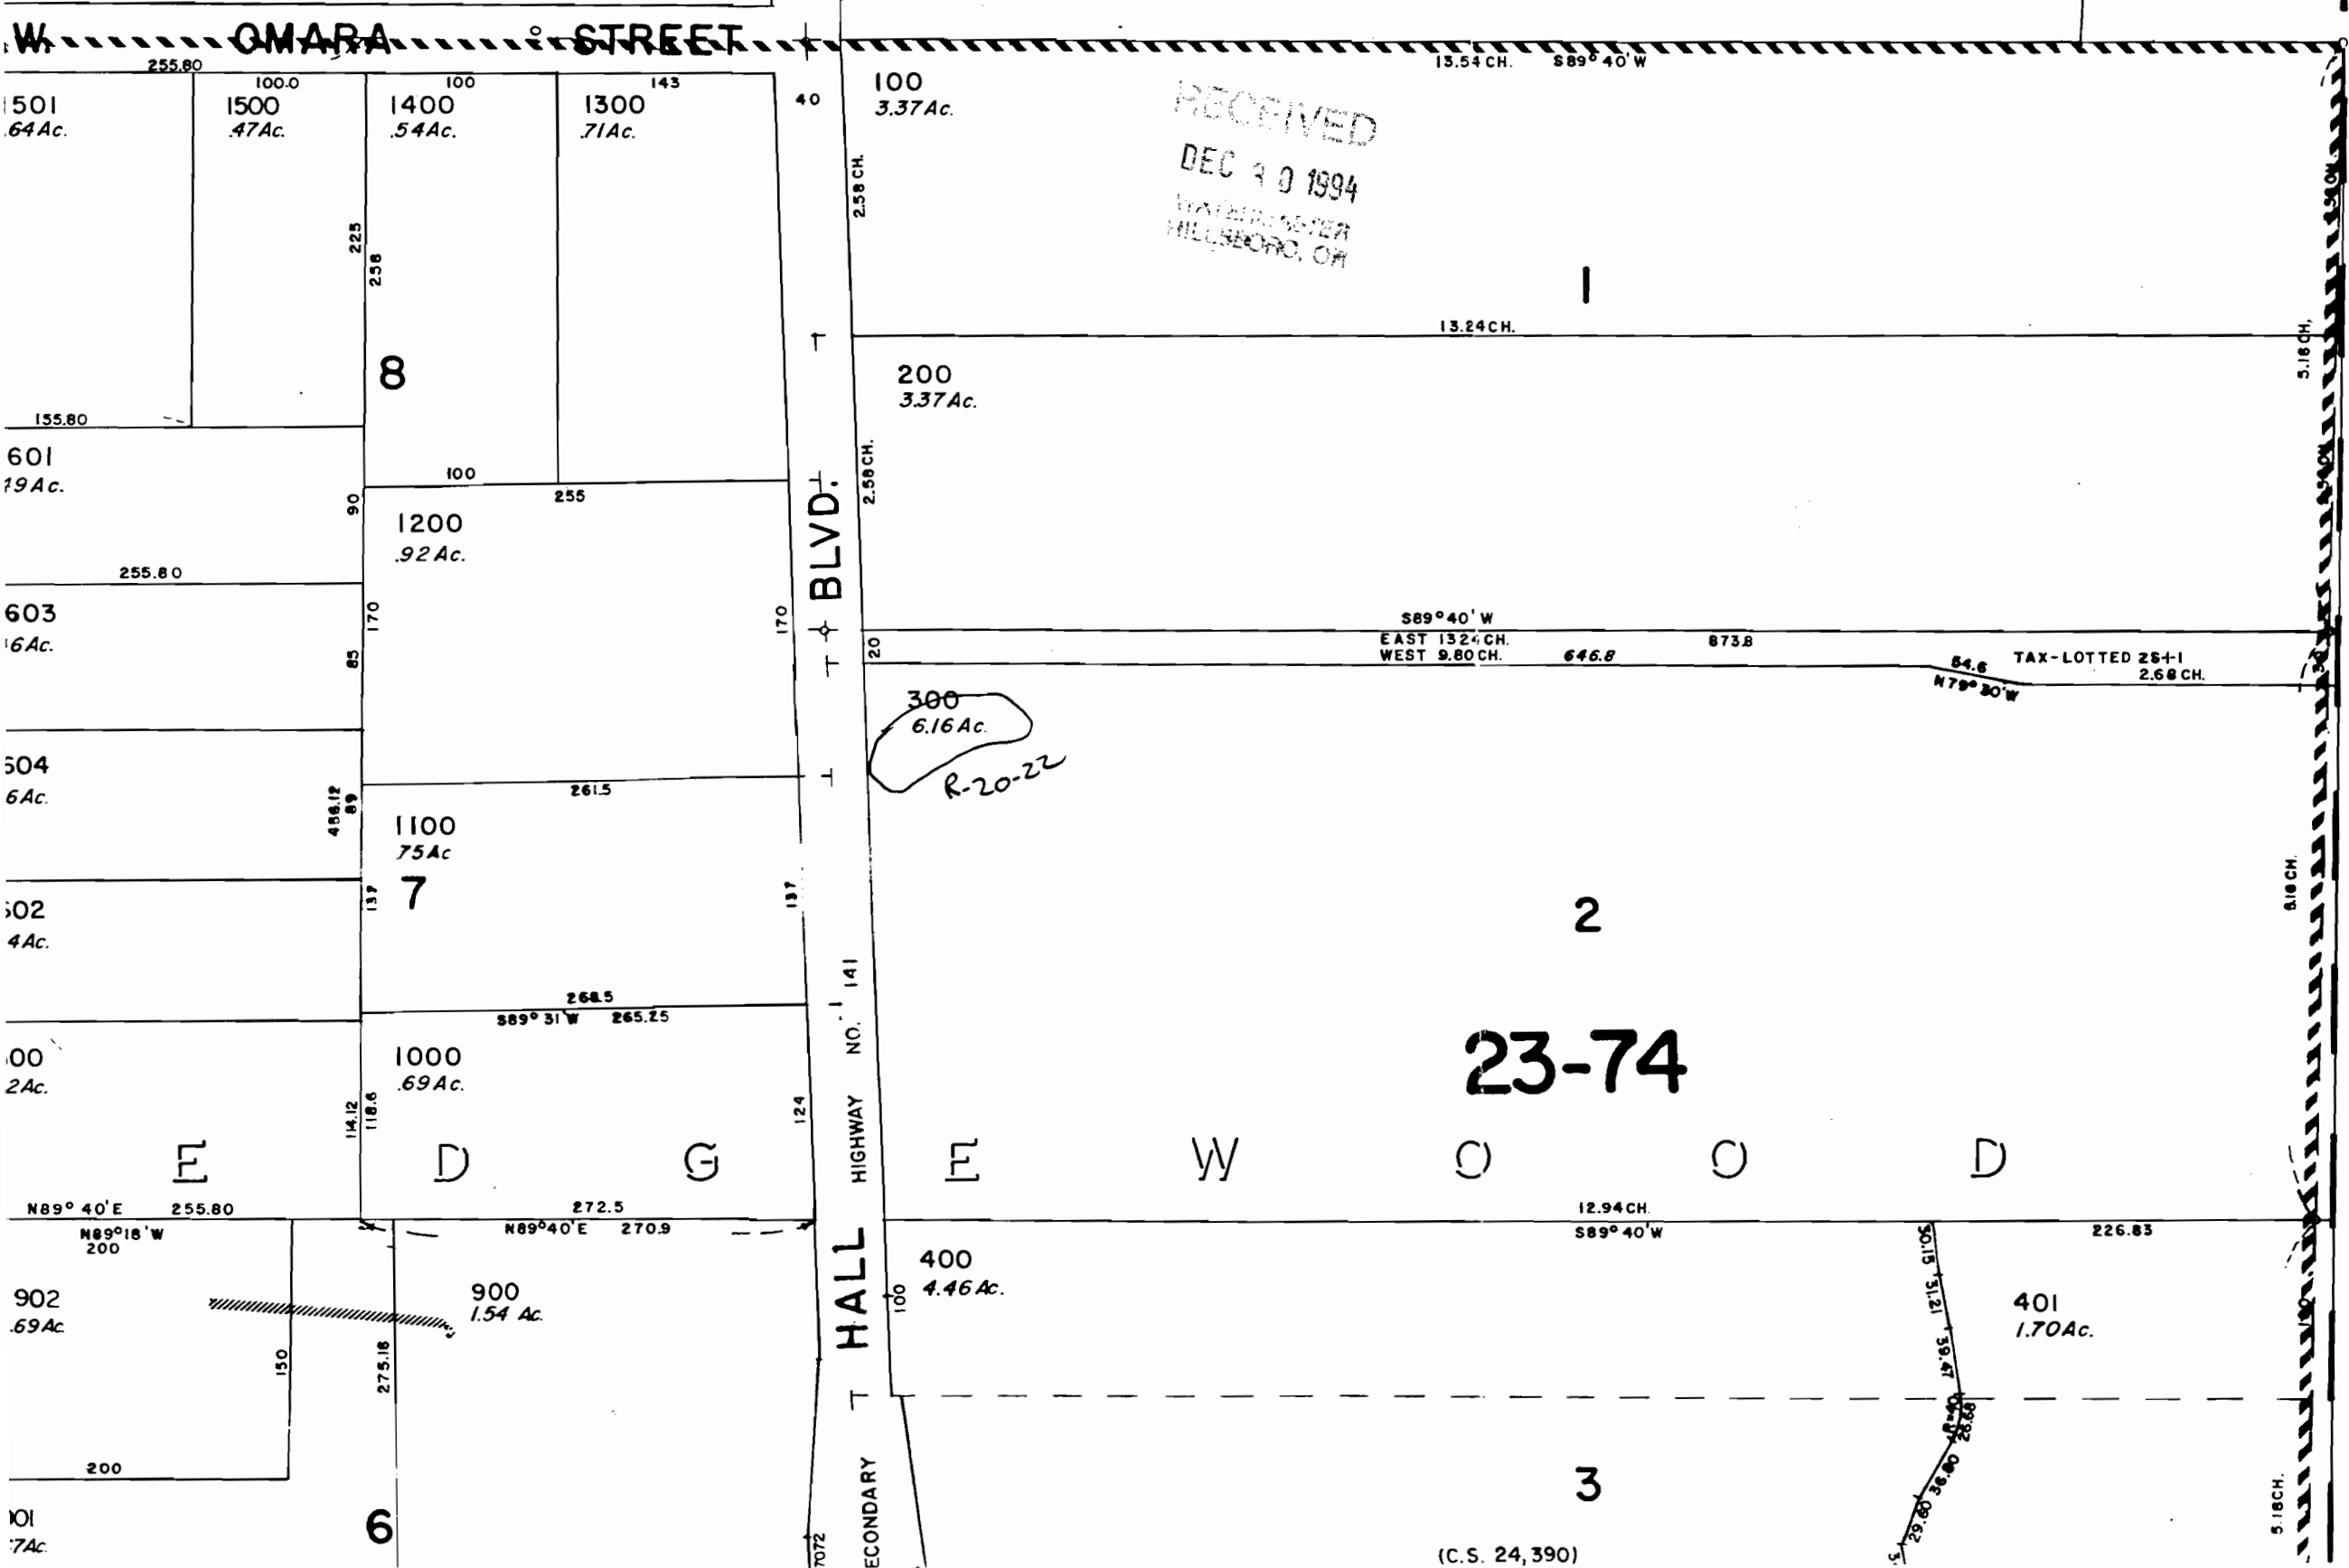

RECEIVED
DEC 30 1994
WASHINGTON COUNTY
HILLSBORO, OR

CANCELLED
807
500
700
4000

SEE MAP
2S 1 1

(C.S. 24,390)