


SCALE: 1" = 400'

"CERTIFICATE NO.

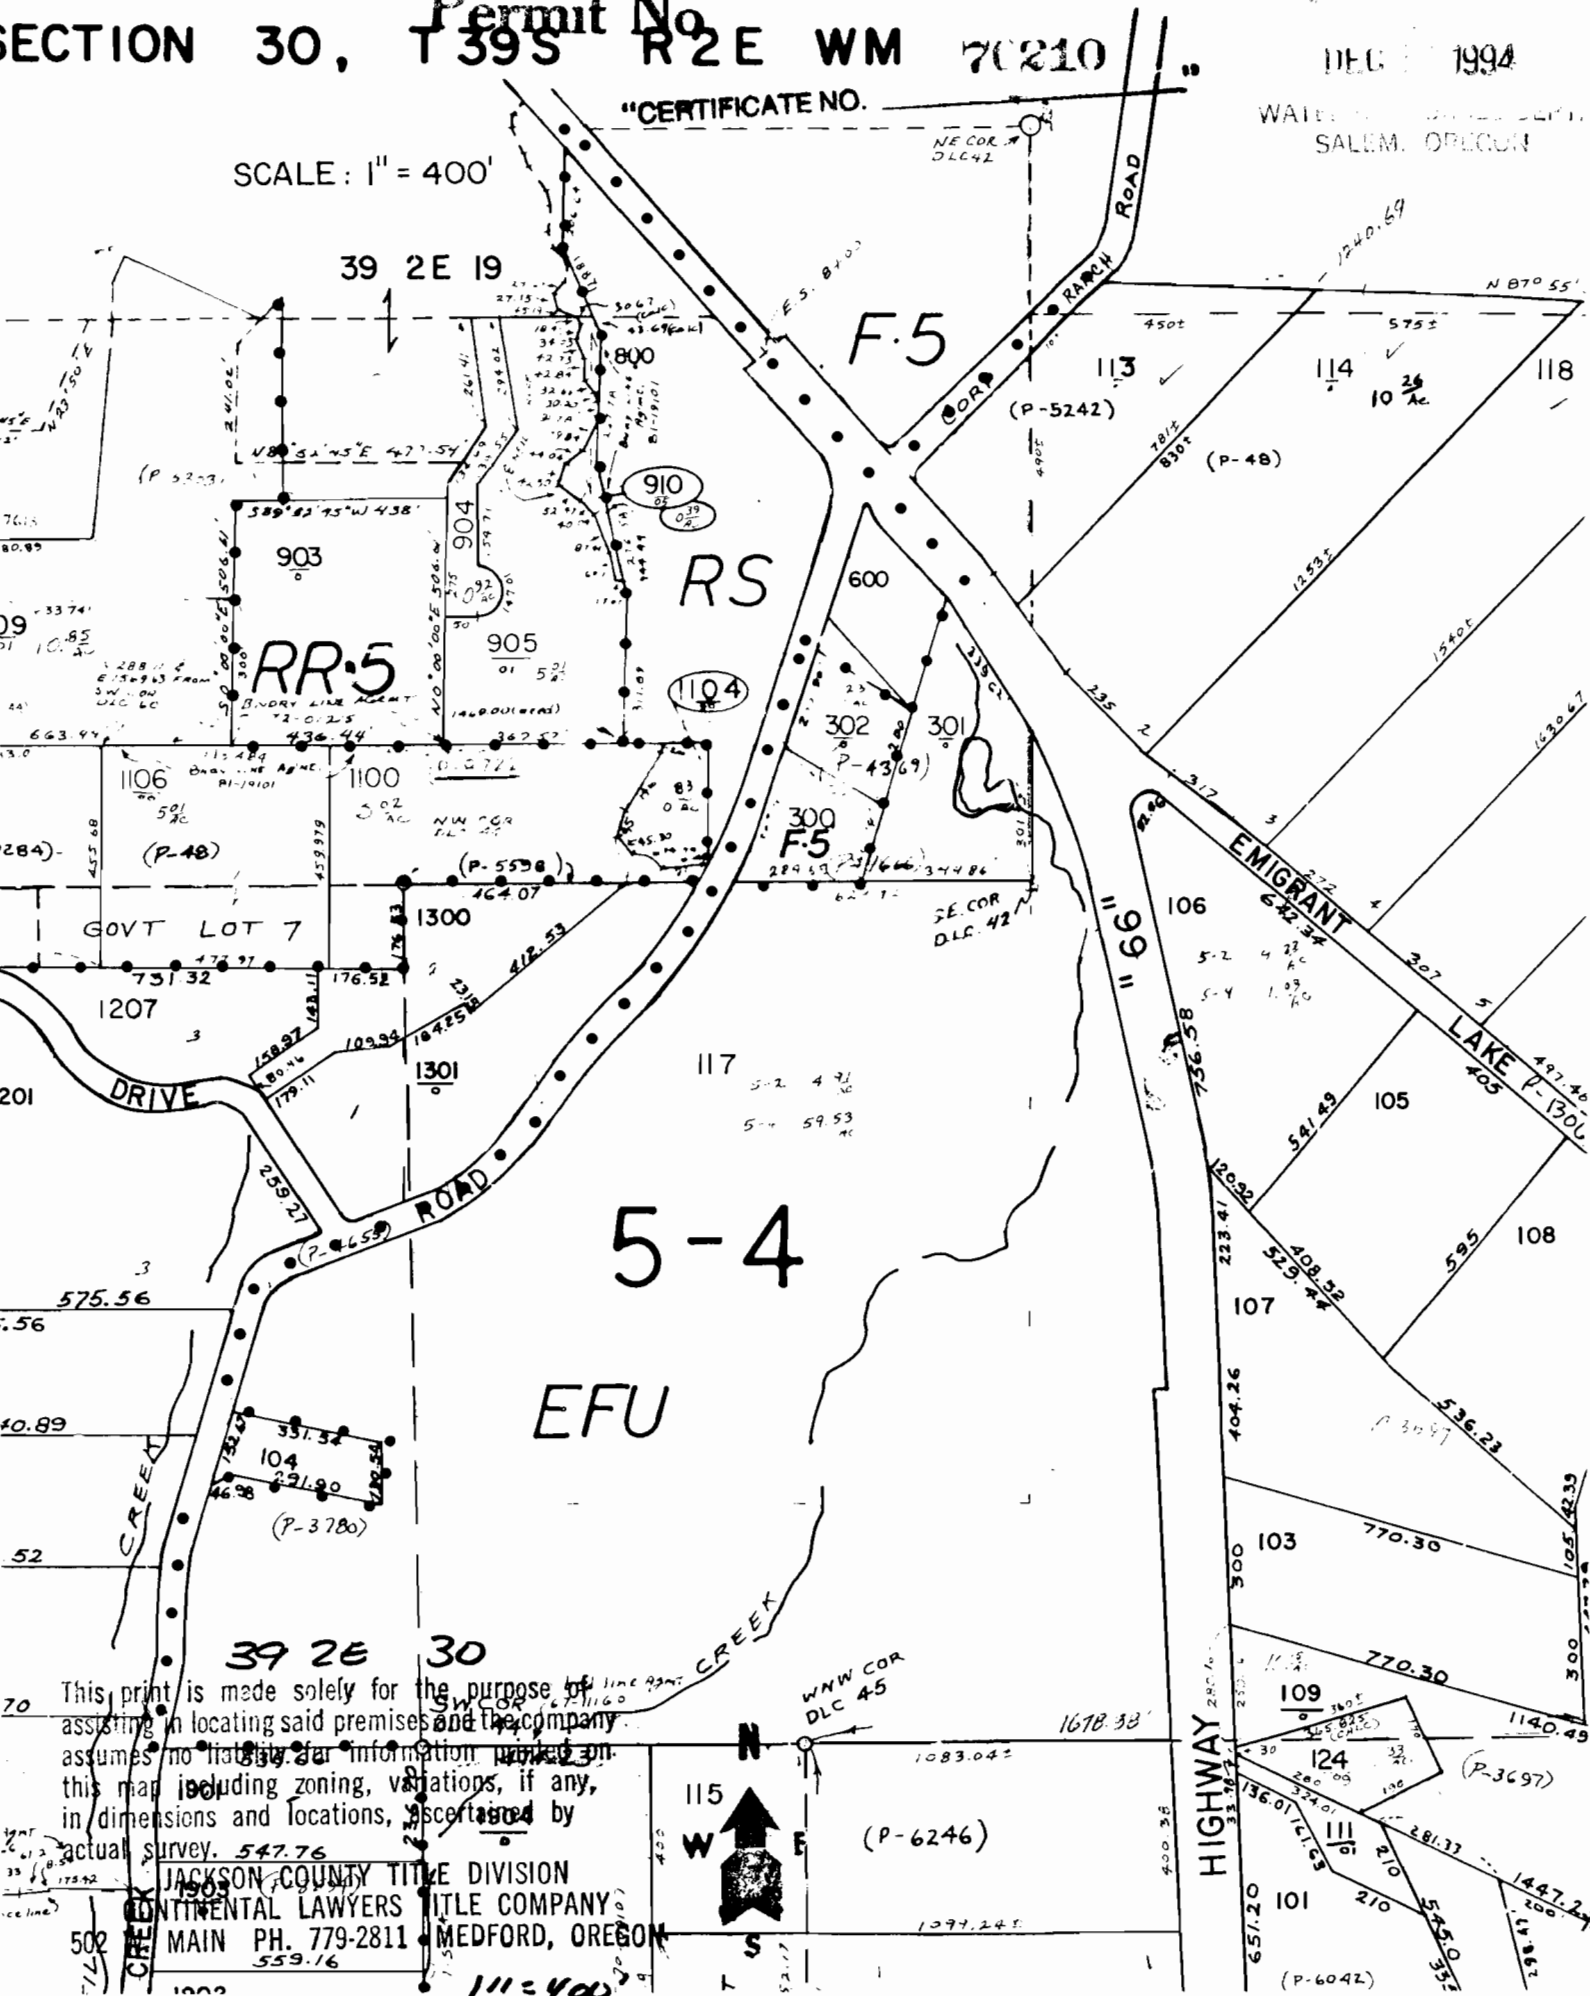

This print is made solely for the purpose of assisting in locating said premises and the company assumes no liability for information printed on this map including zoning, variations, if any, in dimensions and locations, ascertained by actual survey.

JACKSON COUNTY TITLE DIVISION
CONTINENTAL LAWYERS TITLE COMPANY
502 MAIN PH. 779-2811 MEDFORD, OREGON
559.16



WWW COR
DLC 45

(P-6246)

1083.042

1097.245

1678.33'

HIGHWAY

109

124

111

101

(P-6042)

770.30

770.30

281.37

525.0

1447.2

1140.49

(P-3697)

105.4239


