


RECEIVED

JAN - 6 1995

WATER RESOURCES DEPT.
SALEM, OREGON

Application No. R-76279
Permit No.

"CERTIFICATE NO. 70235"

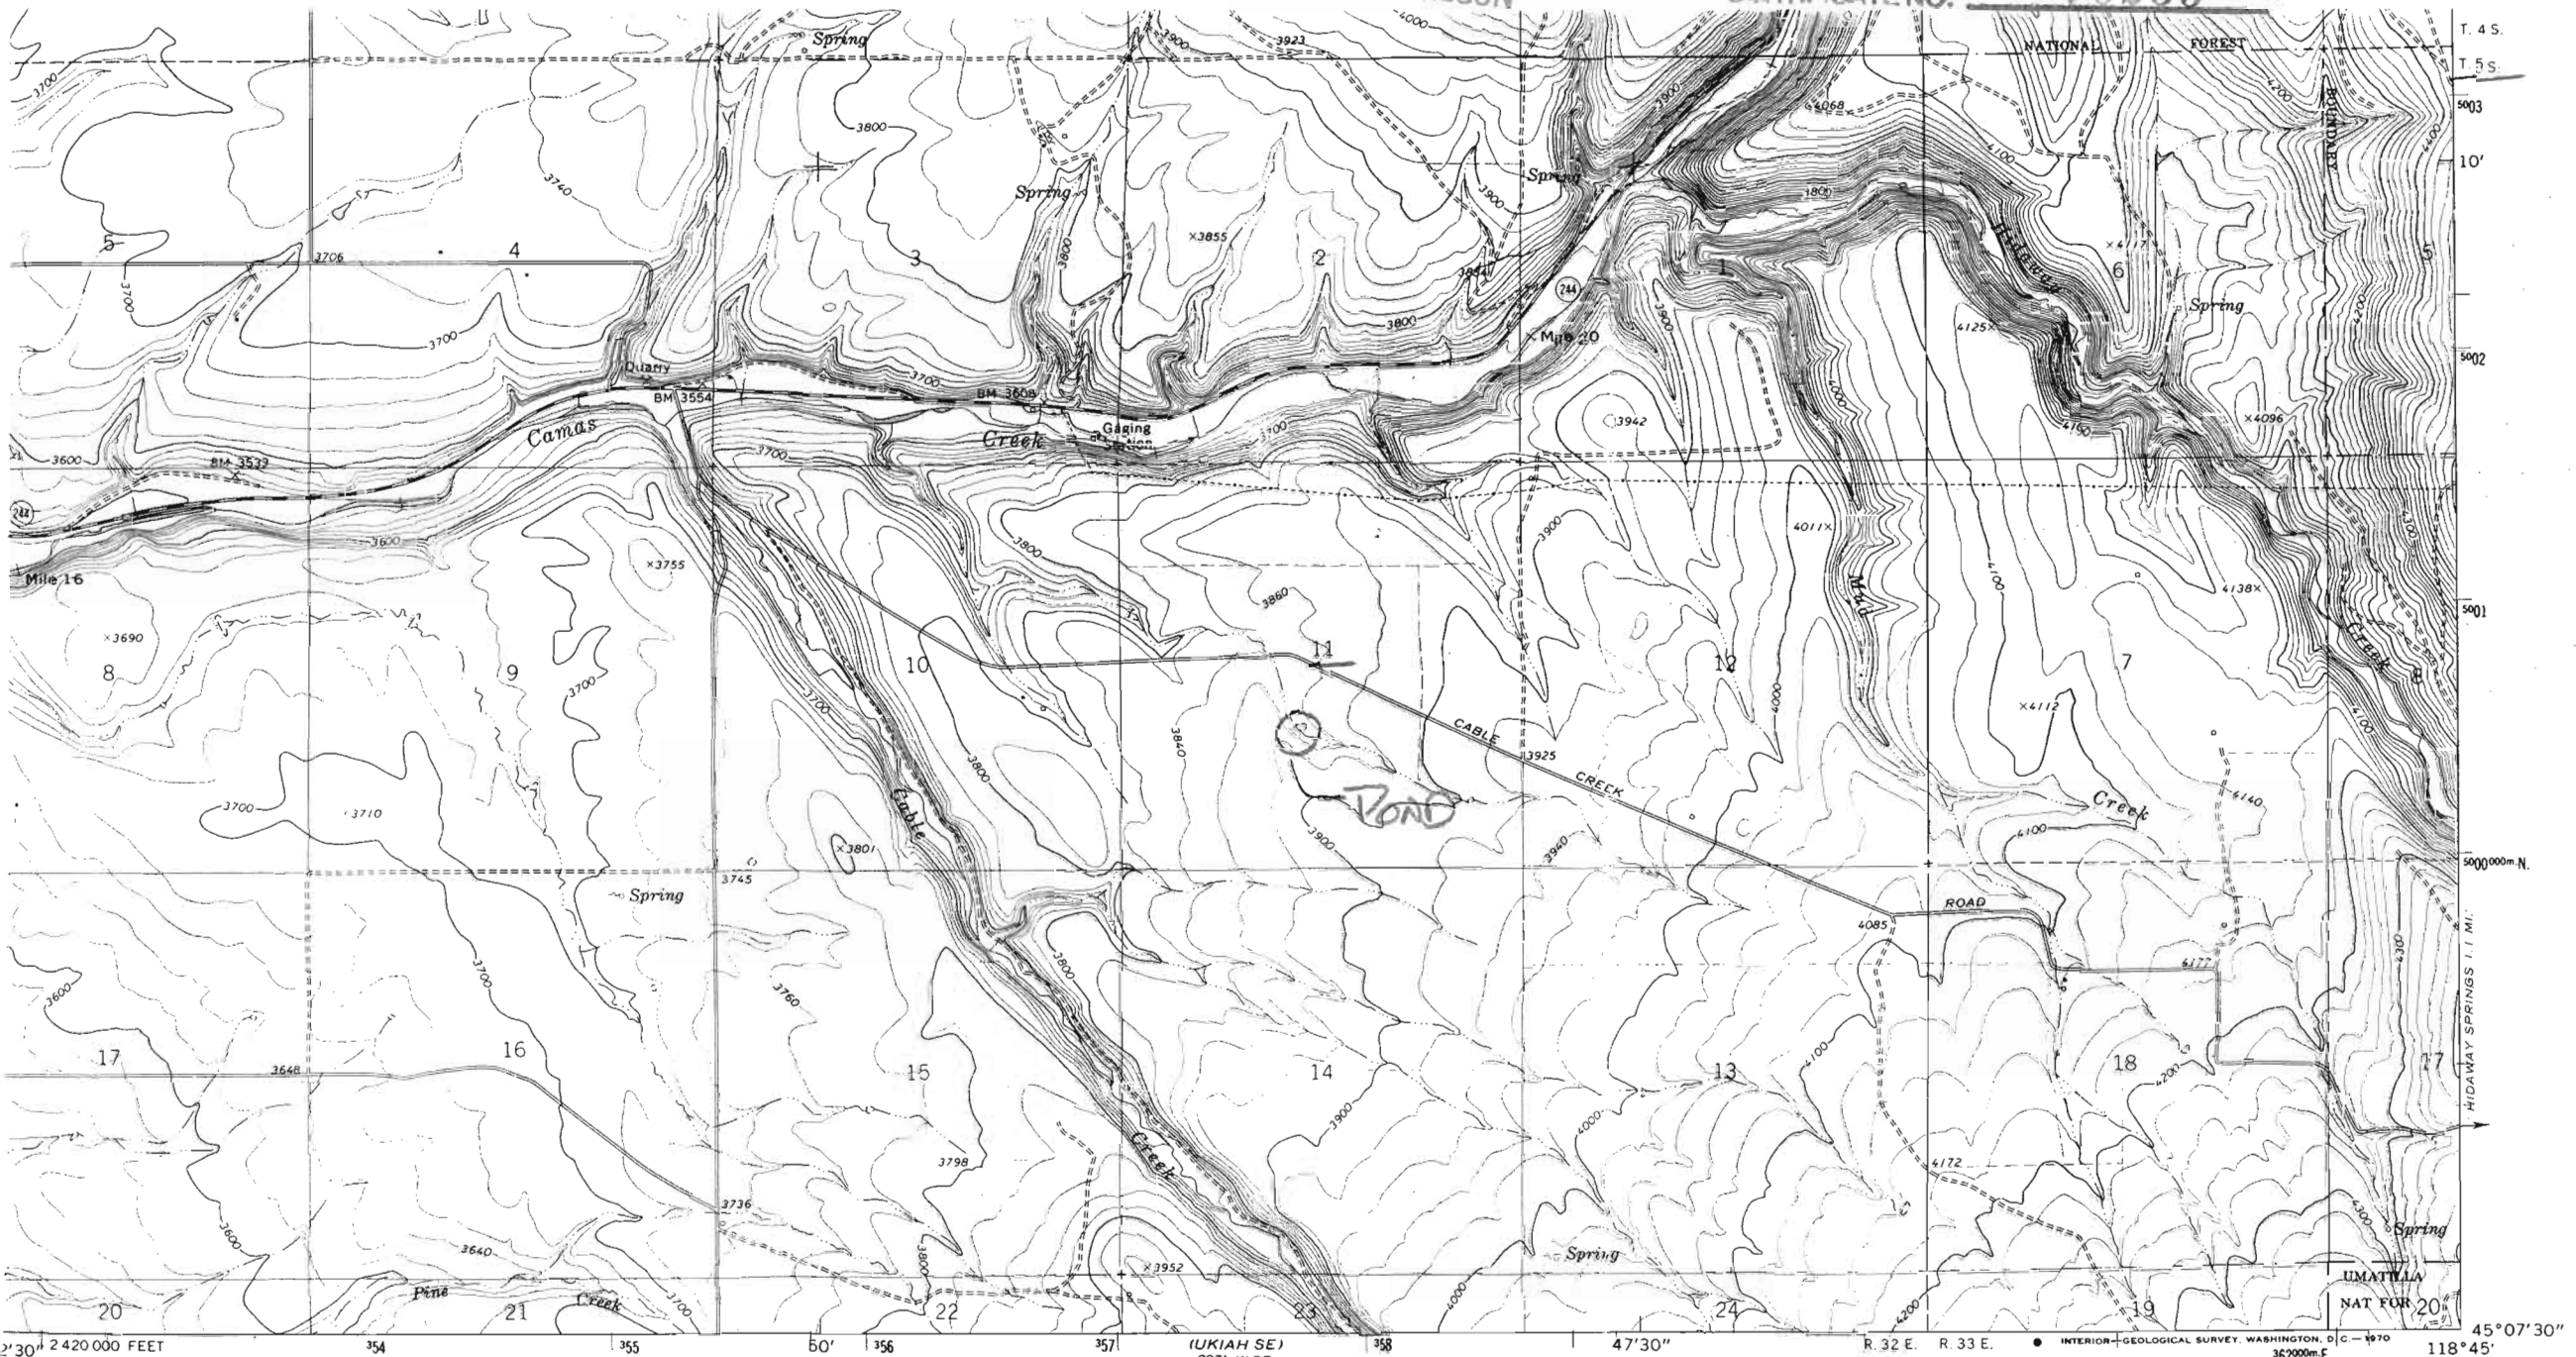

Mapped, edited, and published by the Geological Survey



Control by USGS and USC&GS

Topography by photogrammetric methods from aerial photographs taken 1965. Field checked 1967

Polyconic projection. 1927 North American datum
10,000-foot grid based on Oregon coordinate system,
north zone

1000-meter Universal Transverse Mercator grid ticks,
zone 11, shown in blue


Fine red dashed lines indicate selected fence lines

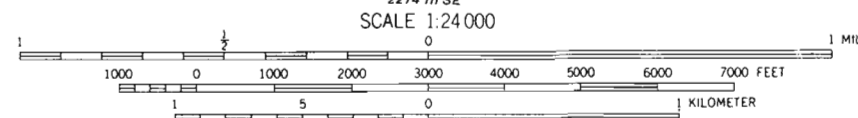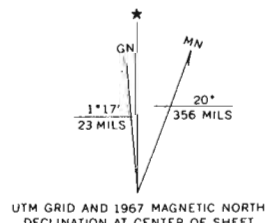

CONTOUR INTERVAL 20 FEET
DATUM IS MEAN SEA LEVEL



QUADRANGLE LOCATION

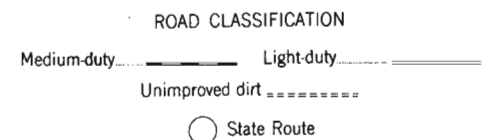

OWENS BUTTE, OREG.
N4507.5—W11845.7.5

1967

AMS 2274 III NE—SERIES V892

THIS MAP COMPLIES WITH NATIONAL MAP ACCURACY STANDARDS
FOR SALE BY U. S. GEOLOGICAL SURVEY, DENVER, COLORADO 80225, OR WASHINGTON, D. C. 20242
A FOLDER DESCRIBING TOPOGRAPHIC MAPS AND SYMBOLS IS AVAILABLE ON REQUEST