

RECEIVED


JAN - 6 1995

WATER RESOURCES DEP
SALEM, OREGON

Application No. R-76281
Permit No.

"CERTIFICATE NO. 70237"

1" = 200'

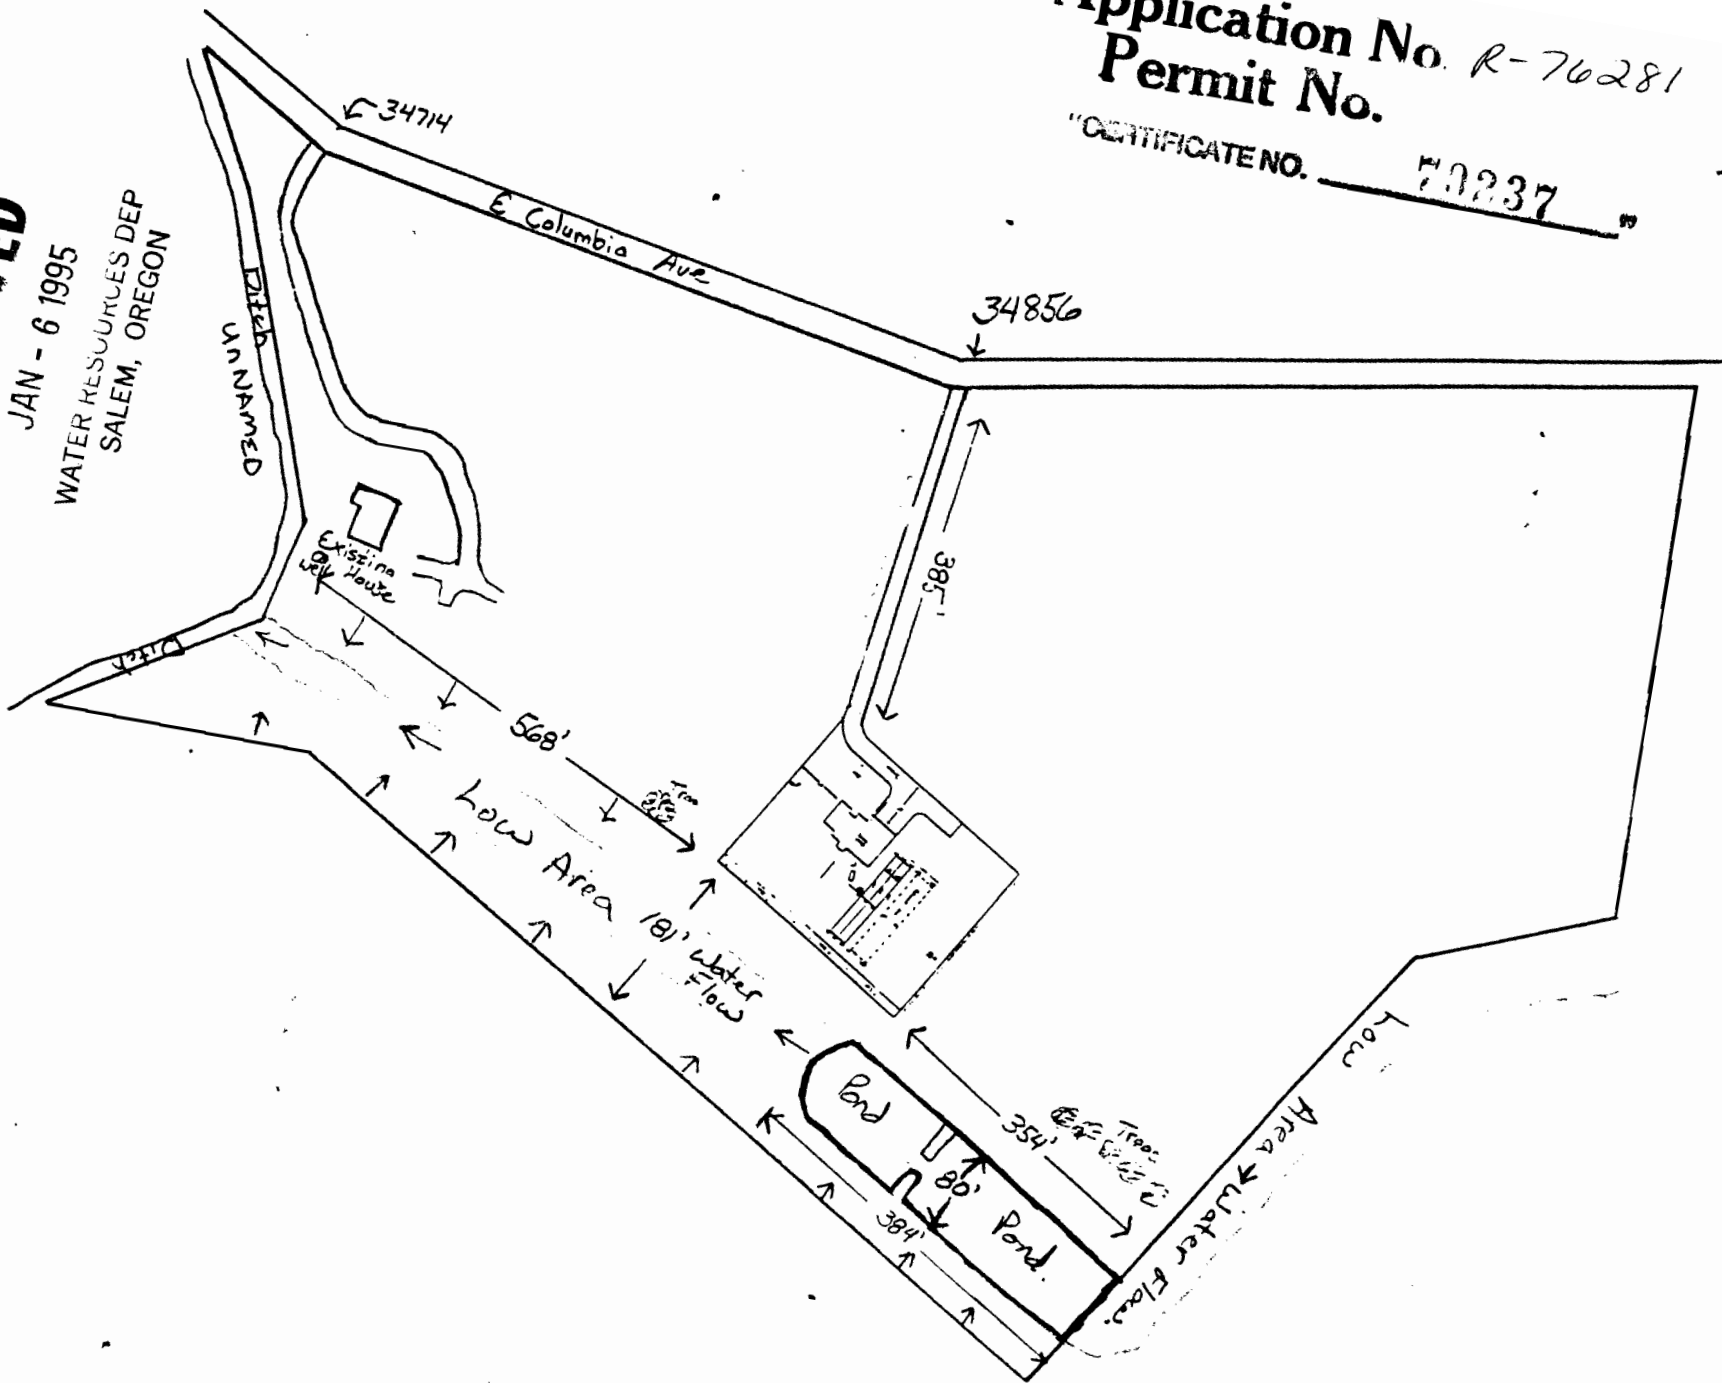

T3, R1 Sec. 18