


T. 35 S., R. 2 W., W.M.

RECEIVED

JAN - 6 1995

WATER RESOURCES DEPT.
SALEM, OREGON

Application No *R-76283*
Permit No.

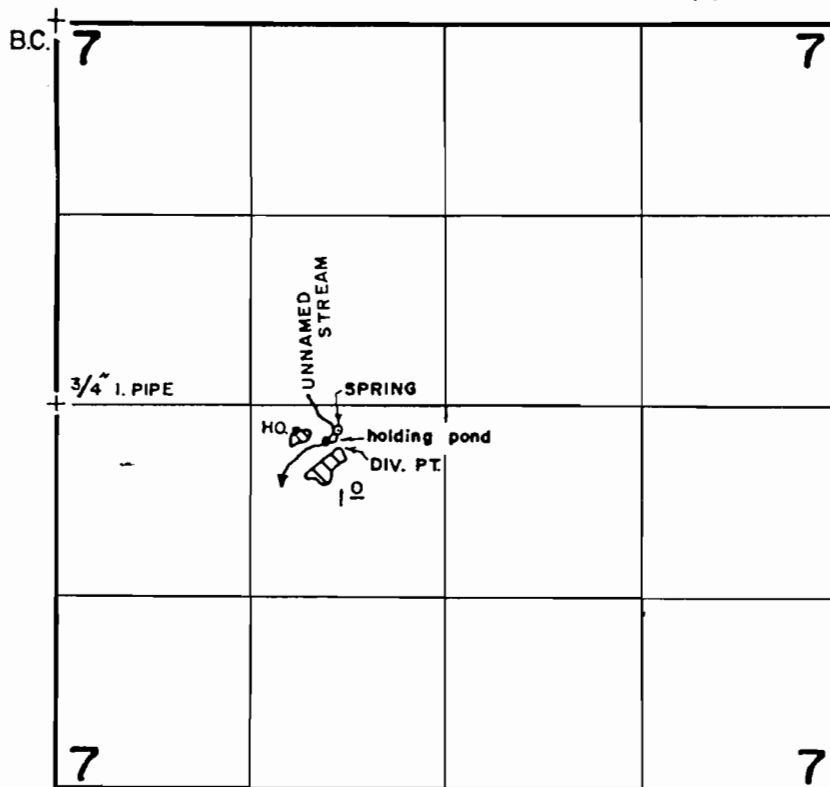

SPRING: 170'S & 1900'E from the W 1/4 COR.

DIV. PT.: 250'S & 1830'E from the W 1/4 COR.

FINAL PROOF SURVEY UNDER

Application No. 53717 Permit No. 40341.....
IN NAME OF

STEVEN PLOTNICK.....

Surveyed JULY 23, 1982, by B.S. JAMES

I have read the above and foregoing proof of appropriation of water; I know the contents thereof, and that the facts therein stated are true.

IN WITNESS WHEREOF I have hereunto set my hand this

day of

19