RECEIVED
JAN - 3 1995
WATER RESOURCES DEPT.
SALEM, OREGON

RECEIVED
DEC 19 1994
WATER RESOURCES DEPT.
SALEM, OREGON

Application No. R-76291
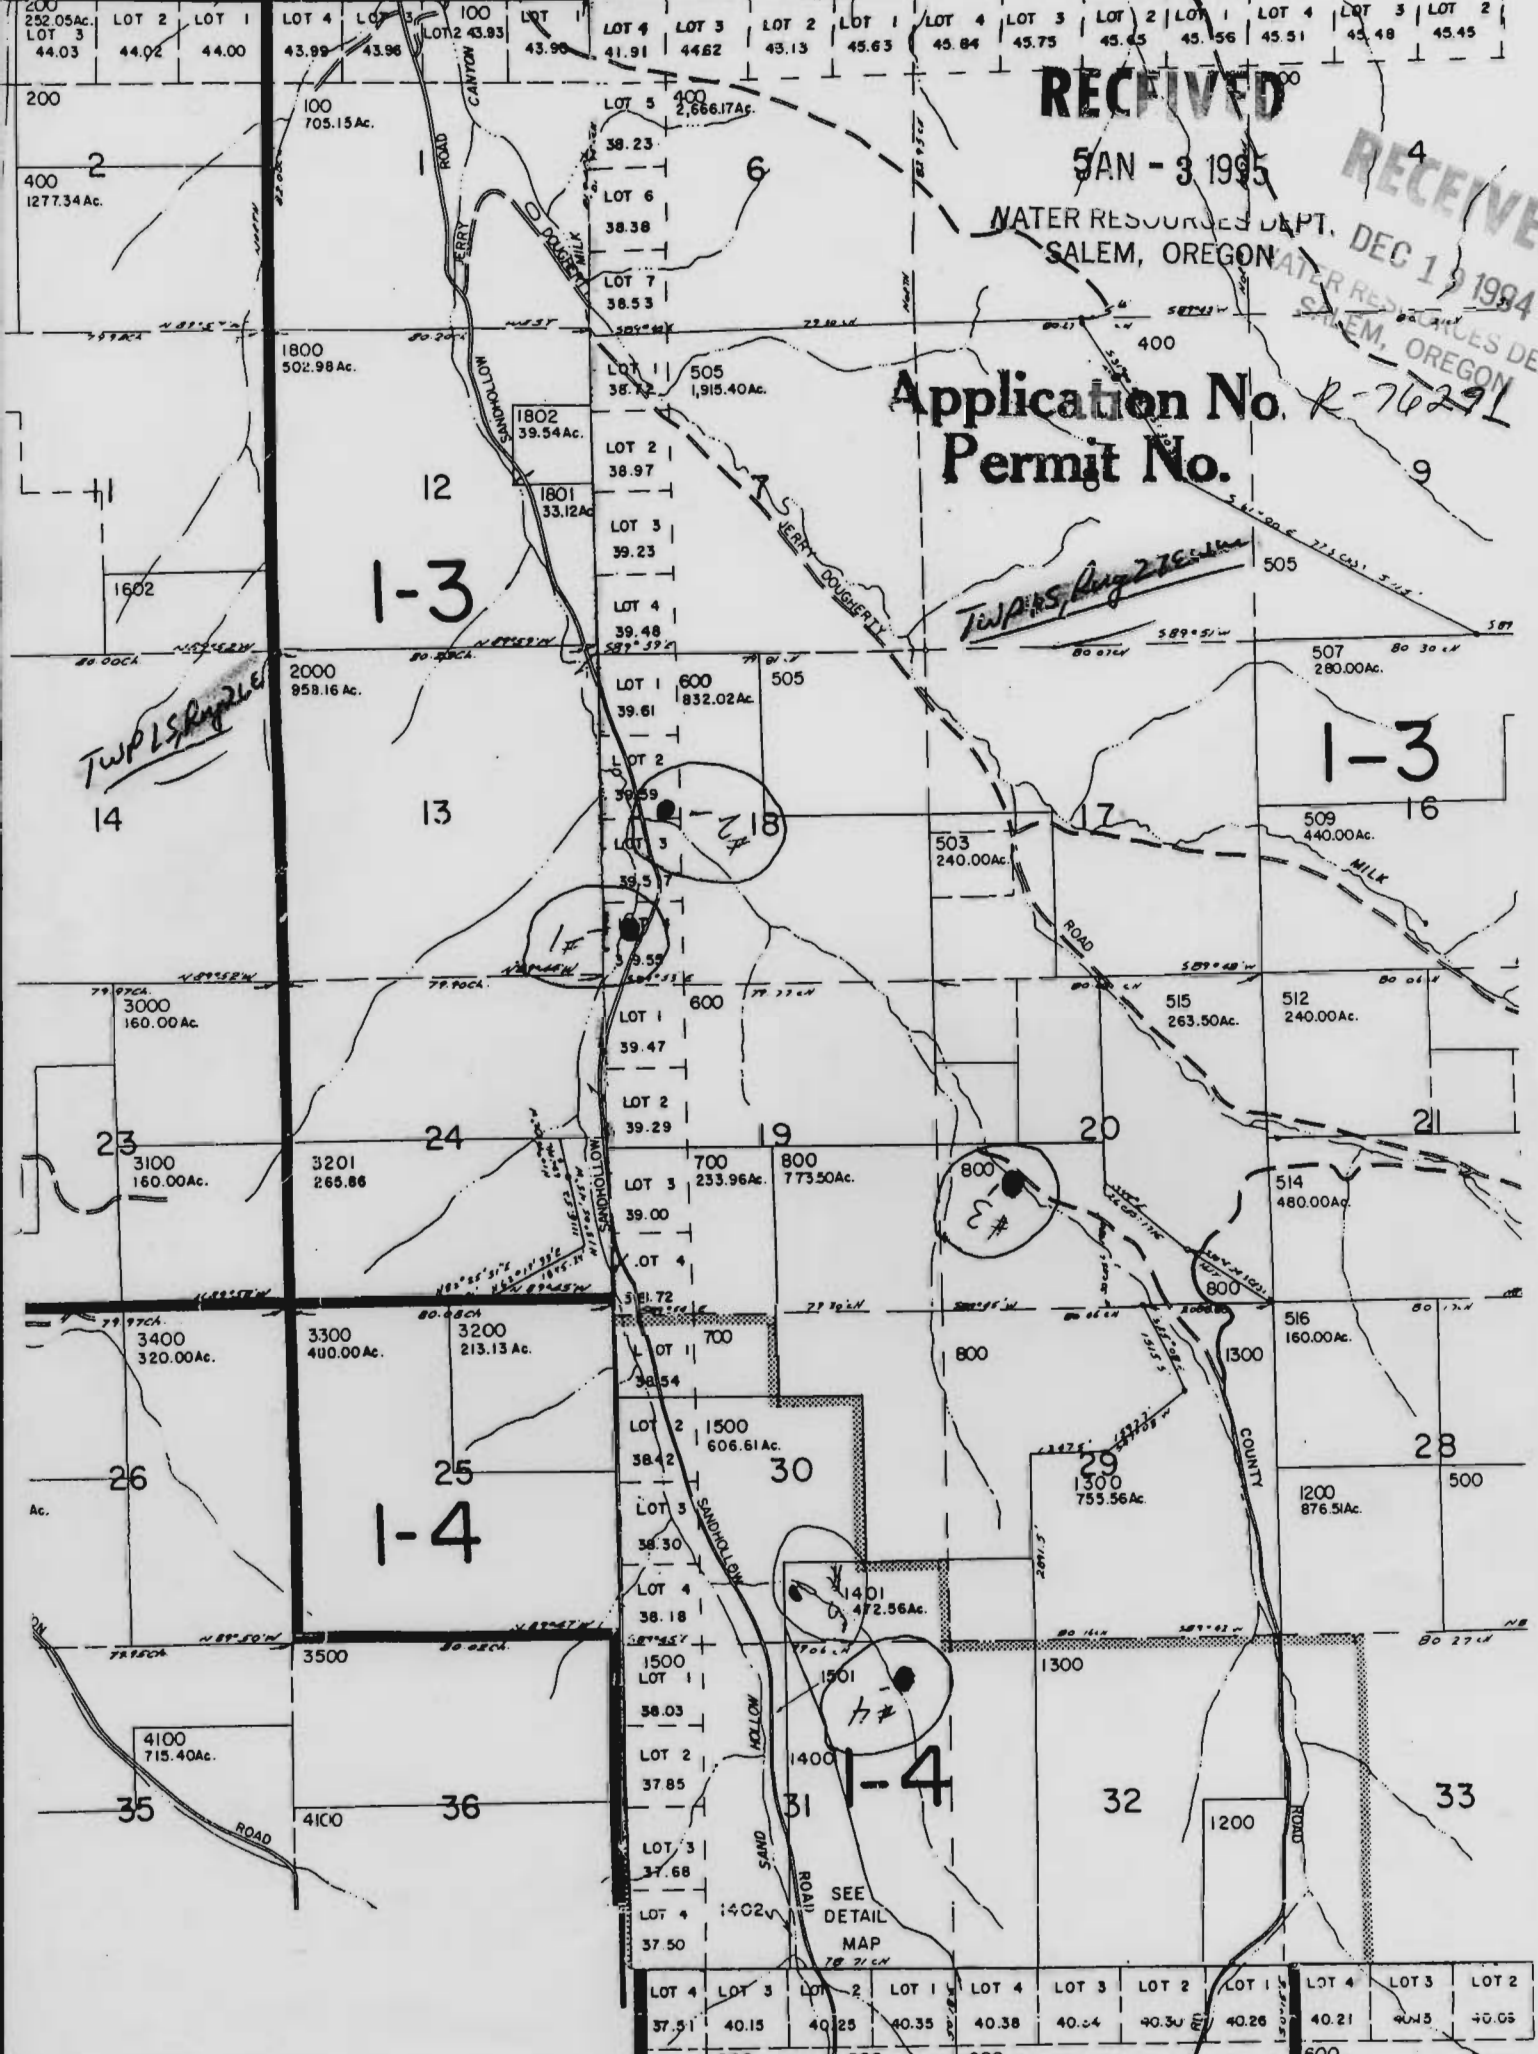
Permit No.