


JAN - 3 1995

WATER RESOURCES DEPT.
SALEM, OREGON

5-08^s

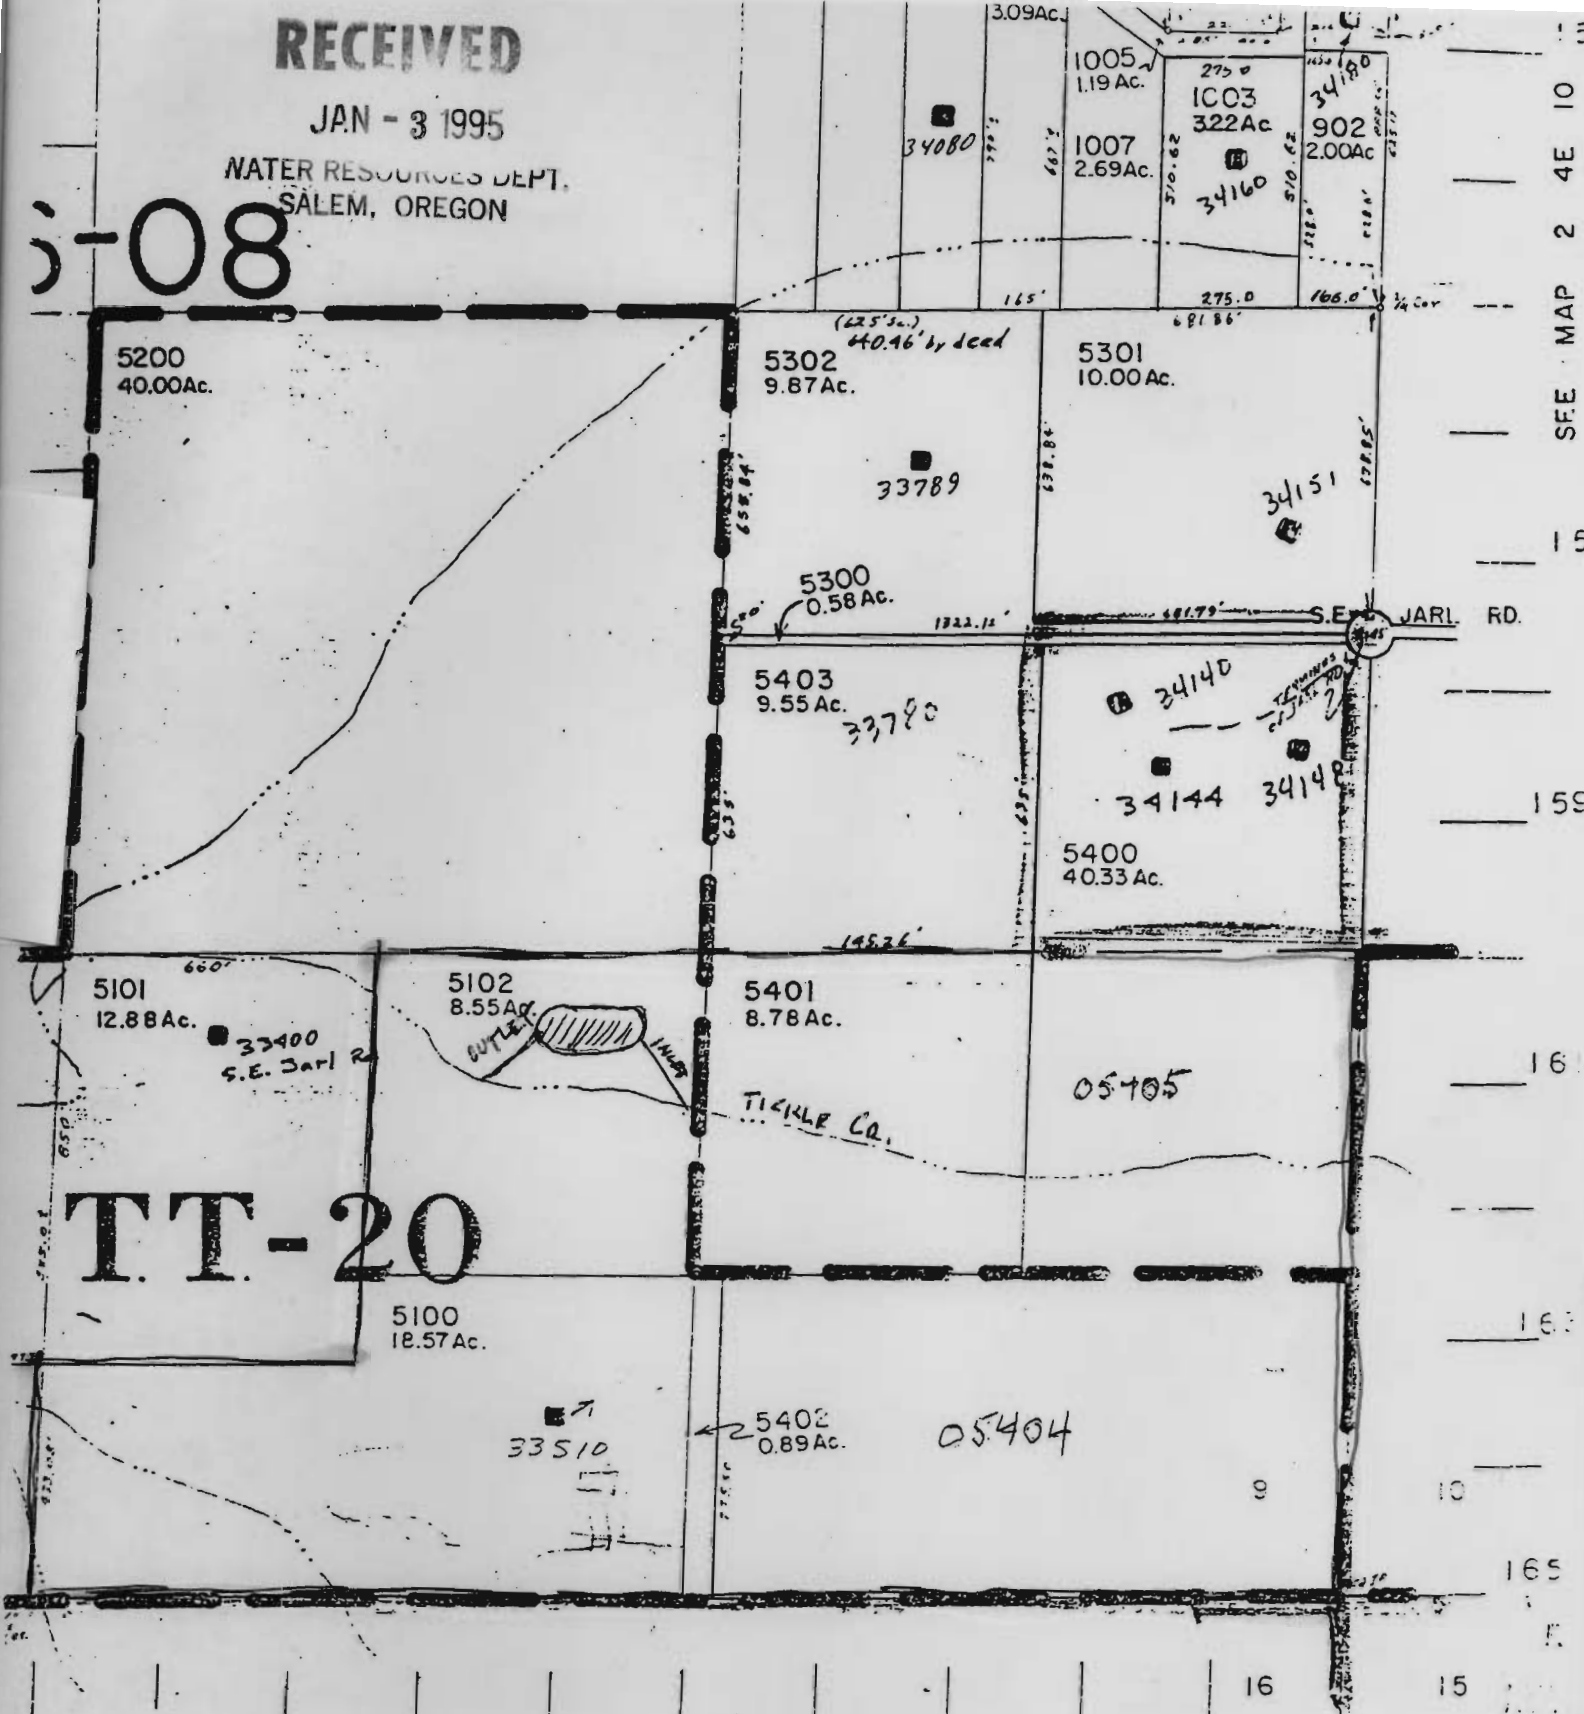

WE OWN PLOTS 5100, 5102, 5401, 5402, 5404 & 5405

Application No. R-76294

Permit No.