


Application No. R-76295
Permit No. 15

RECEIVED

JAN - 3 1995

WATER RESOURCES
SALEM, OREGON

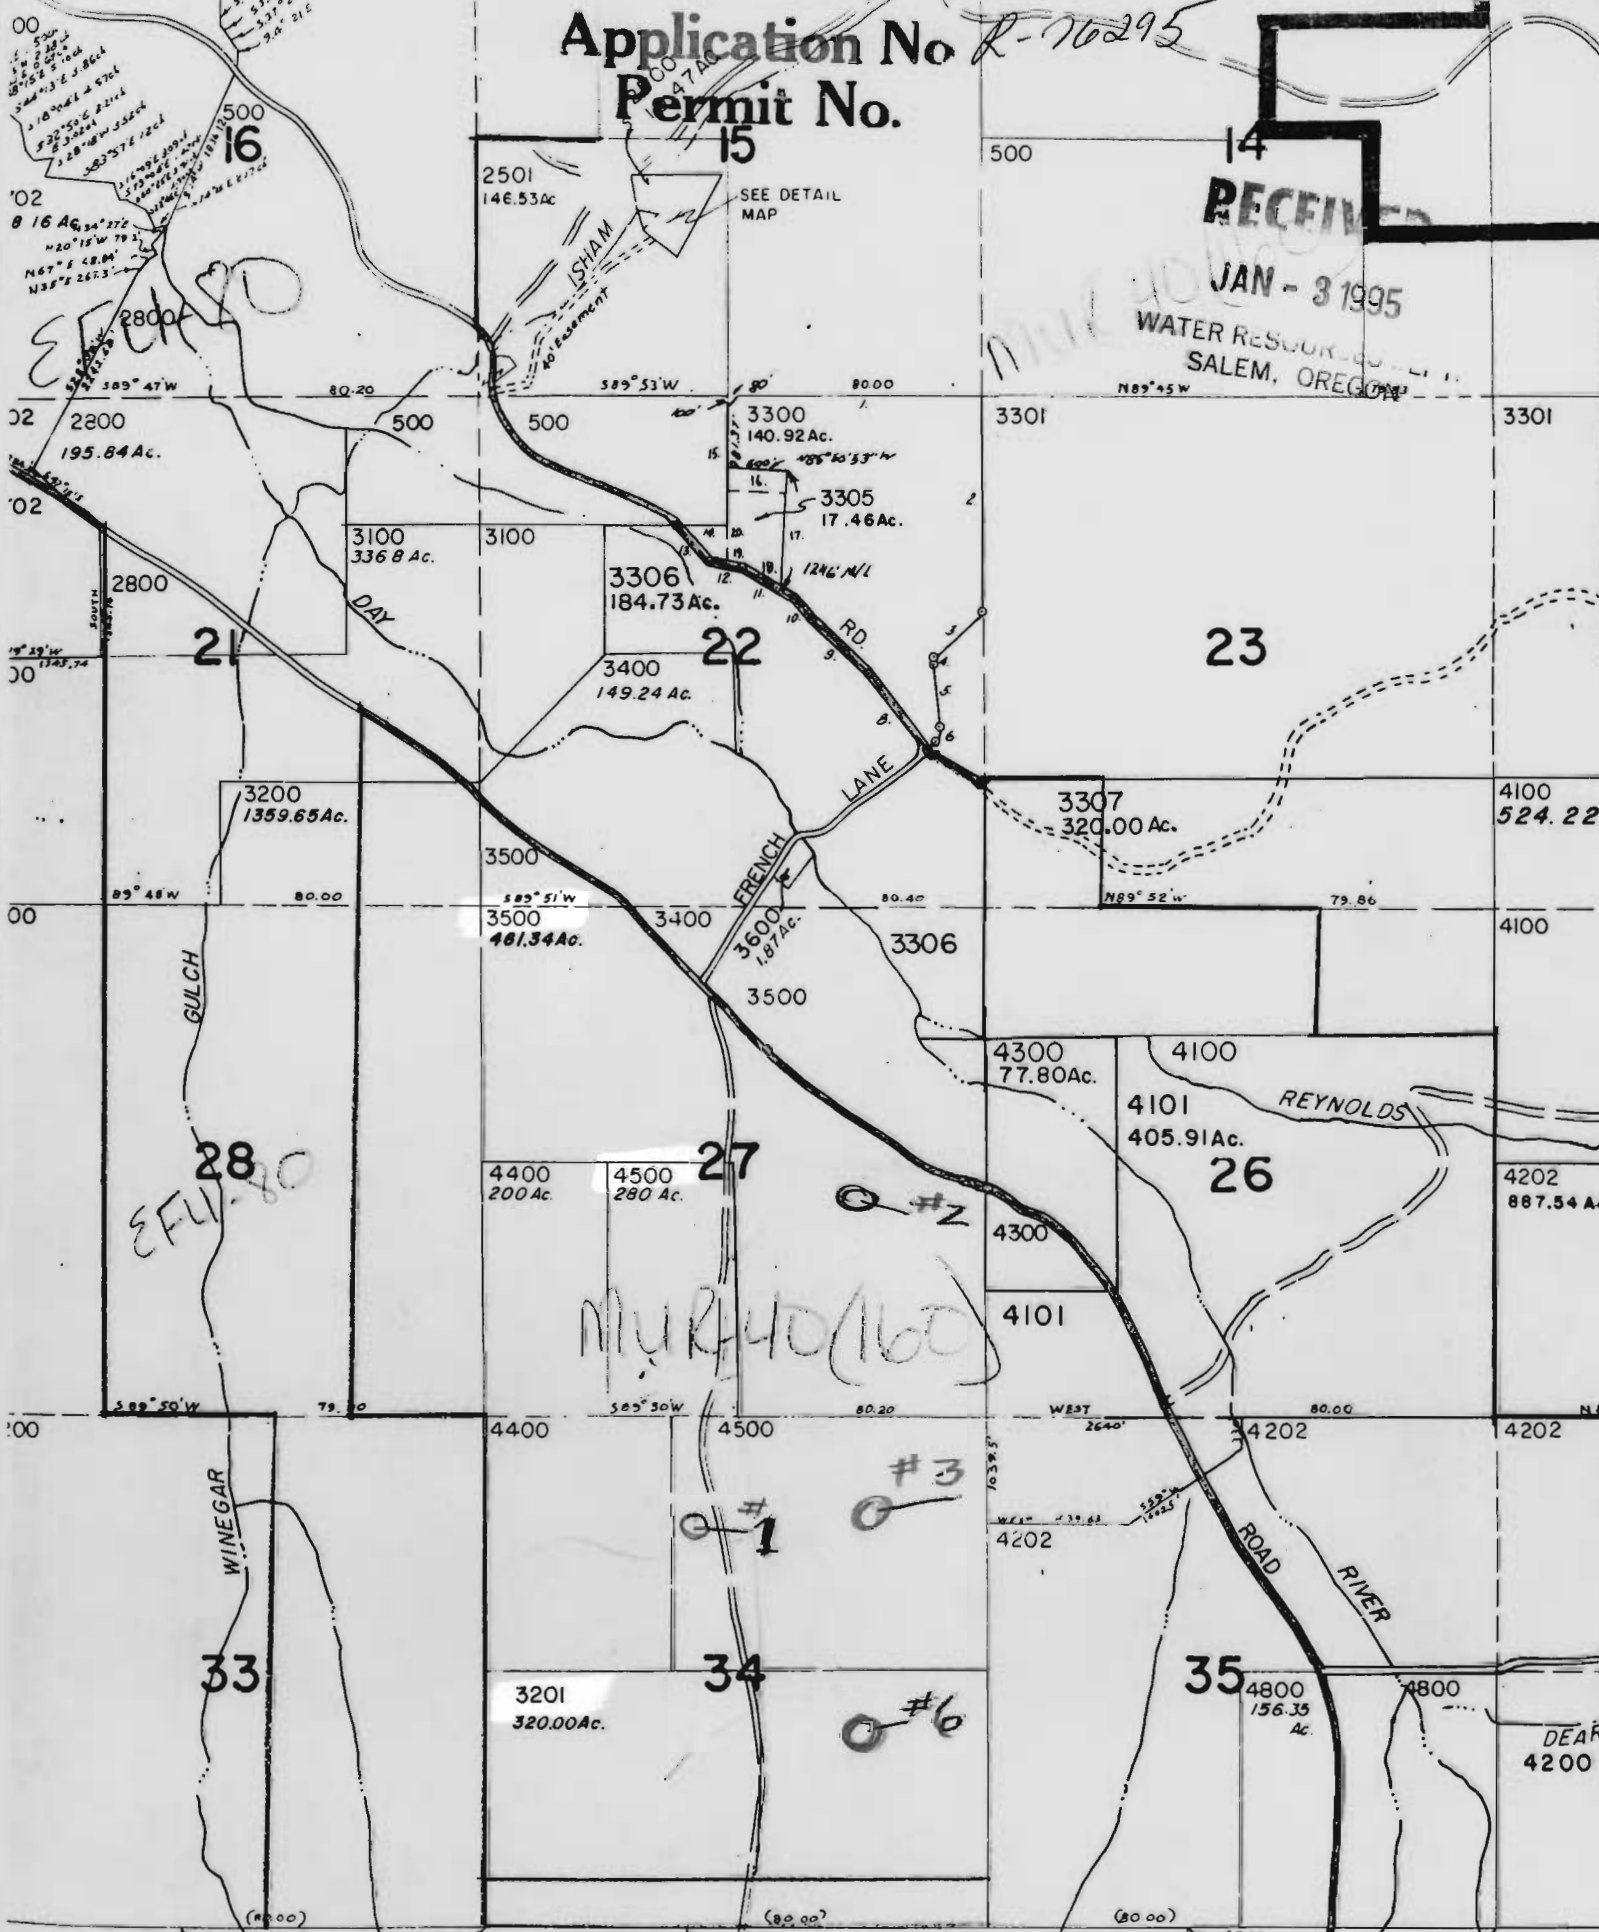

TOWNSHIP 13 34

THIS MAP WAS PREPARED FOR
ASSESSMENT PURPOSES ONLY

