SECTION 25 T.4 S. R.6 W. W.M.

Application No. R-76297
Permit No.

4 6 25

CANCELLED 1301

YAMHILL COUNTY

1" = 400'

Map was prepared for assessment purpose only.

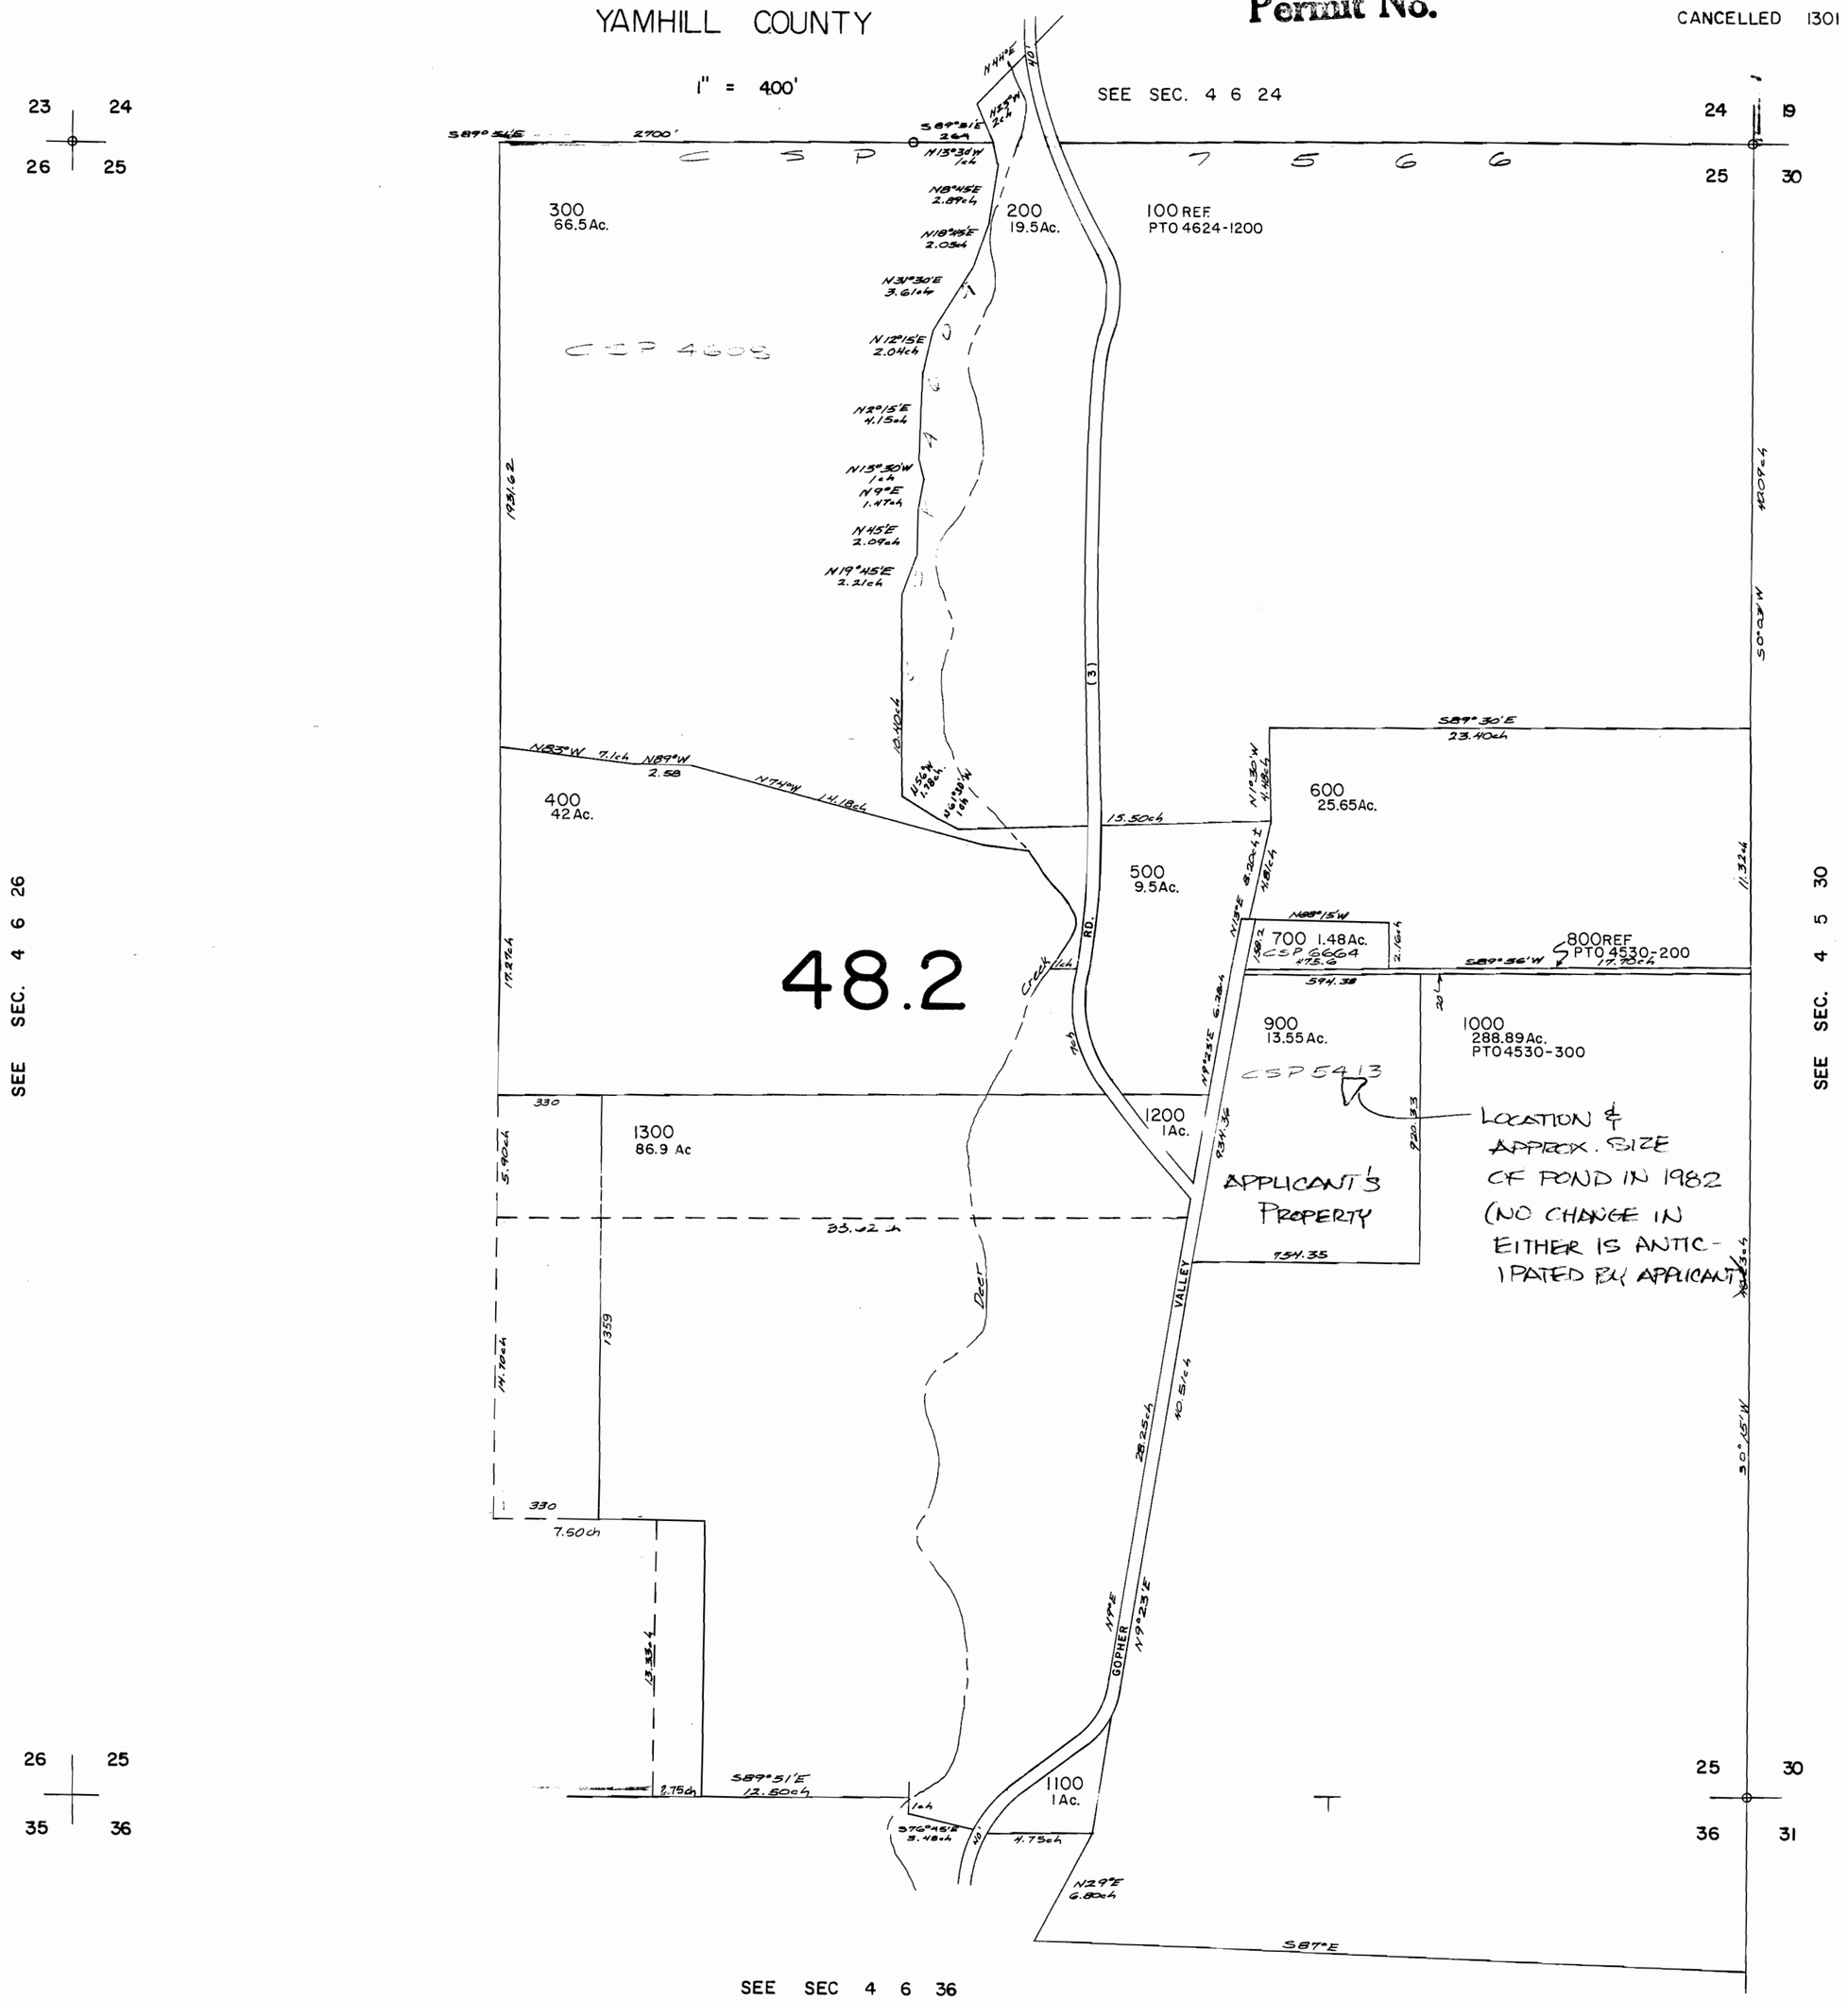

4 6 25