


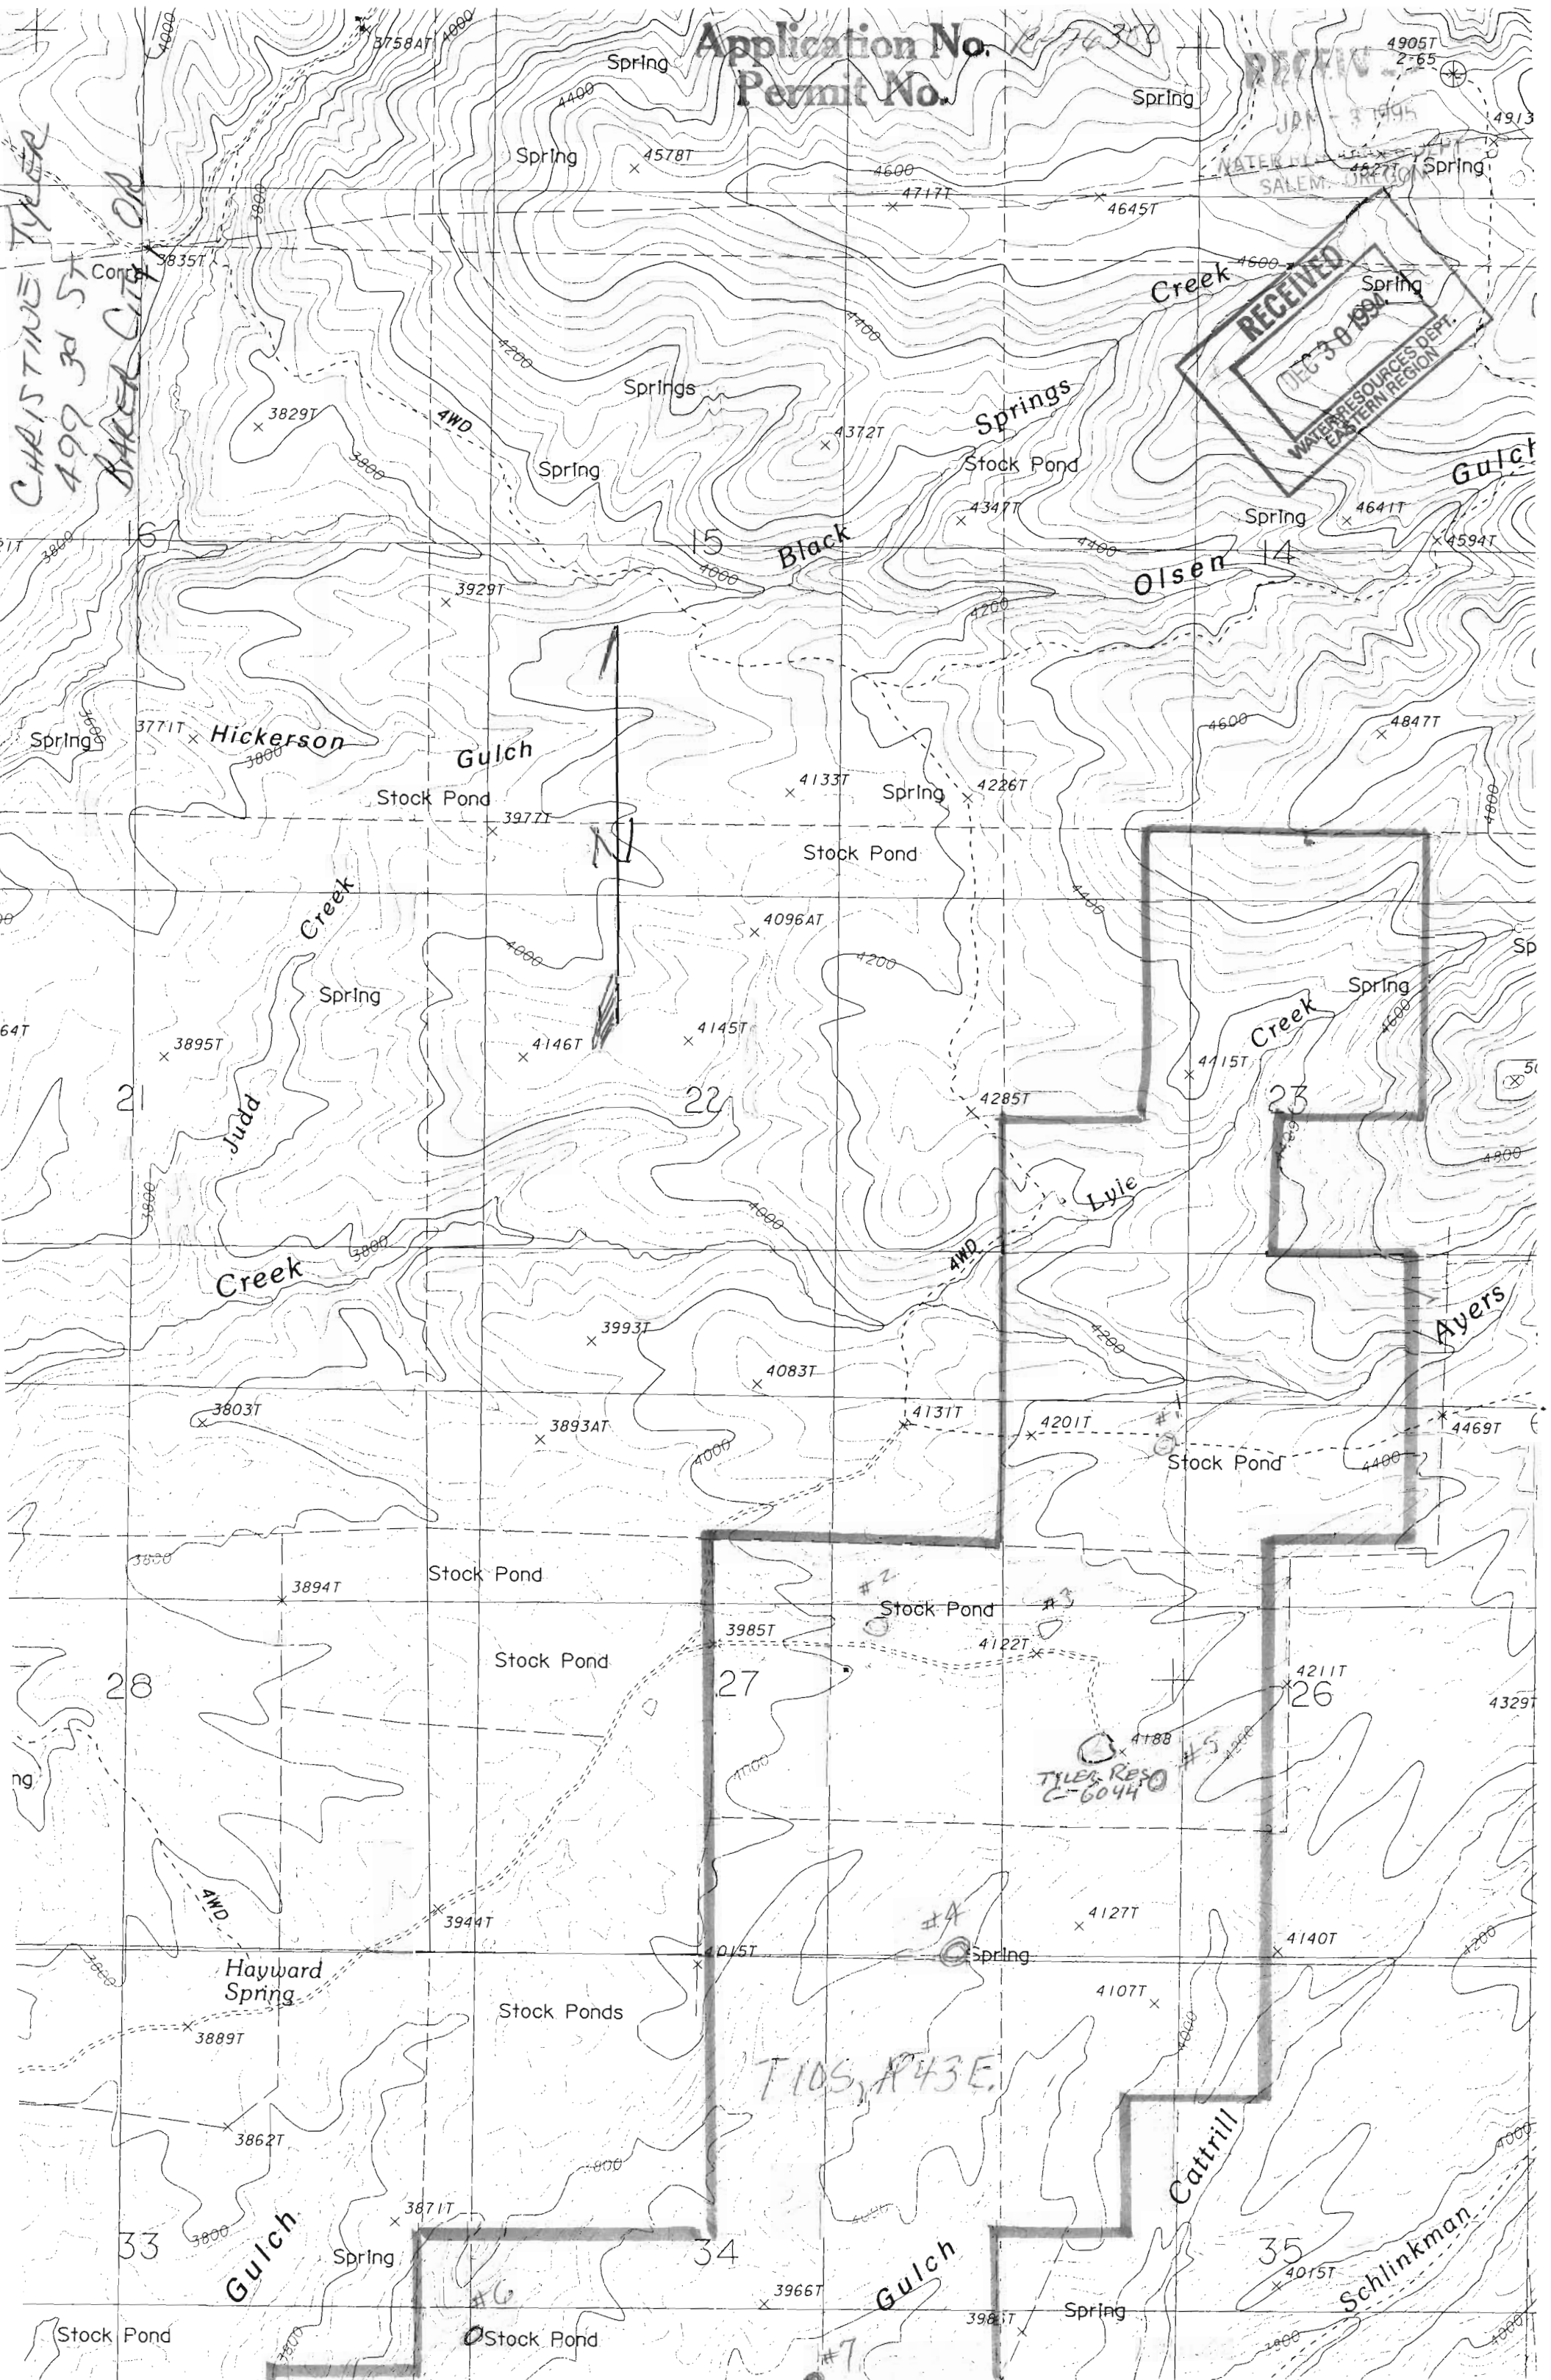

Application No. R-76303
Permit No.

RECEIVED
DEC 30 1991
WATER RESOURCES DEPT.
EASTERN REGION

CHRISTINE TYLER
499 3d ST
BAKER CITY, OR

TIDS, R43E

TYLER RES
C-6044