


RECEIVED
JAN - 3 1995
WATER RESOURCES DEPT.
SALEM, OREGON

SCALE 1"=9600'

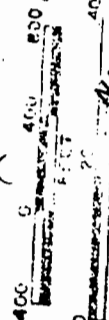

RECEIVED
JAN 10 1994

[Handwritten signature]

THIS MAP HAS BEEN
Scale: 1"

UMBIA COUNTY


PREPARED FOR ASSESSMENT PURPOSES ONLY

Current Revision Date: 03 / 11 / 87

Application No. *R-70304*
Permit No. *7424*

"CERTIFICATE NO. 70259"

SEE MAP 7 4 23

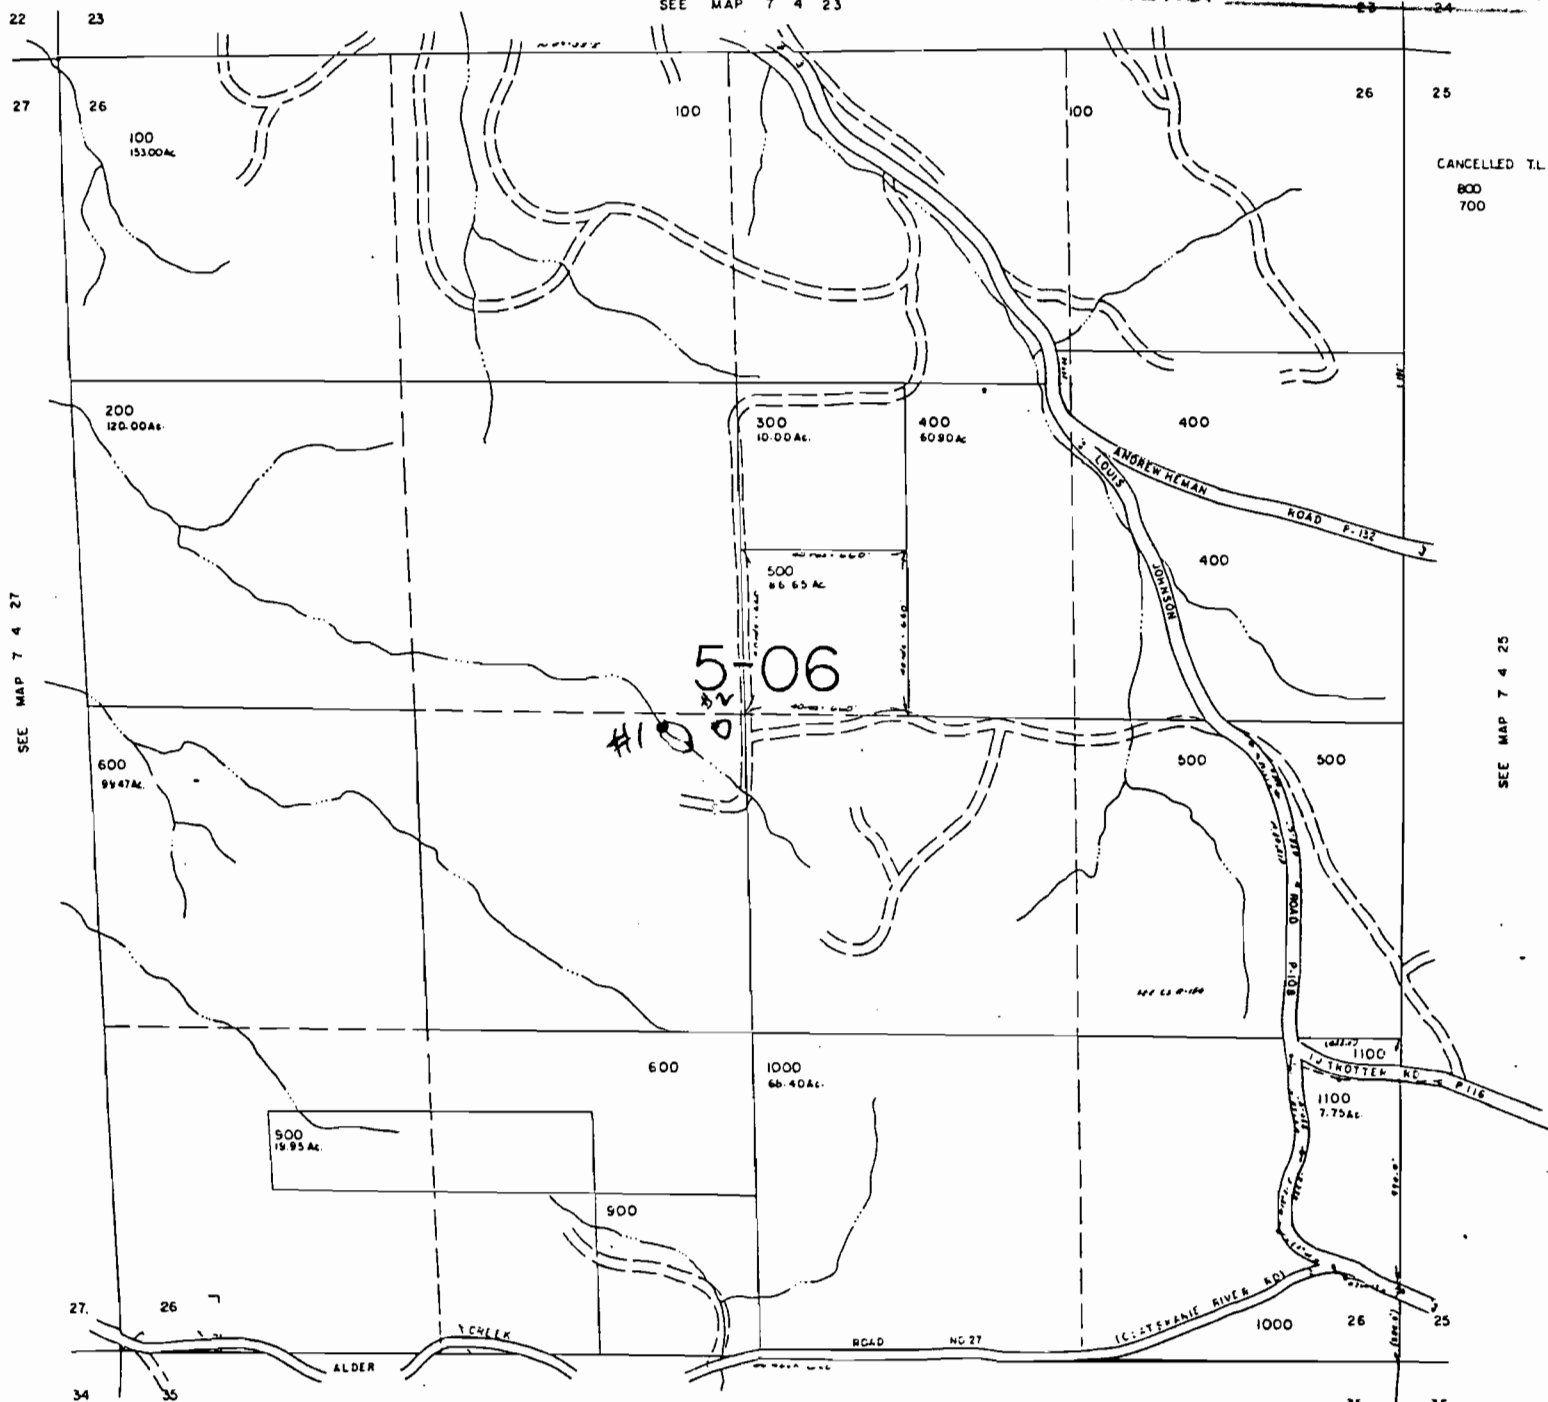

SEE MAP 7 4 27

SEE MAP 7 4 25