


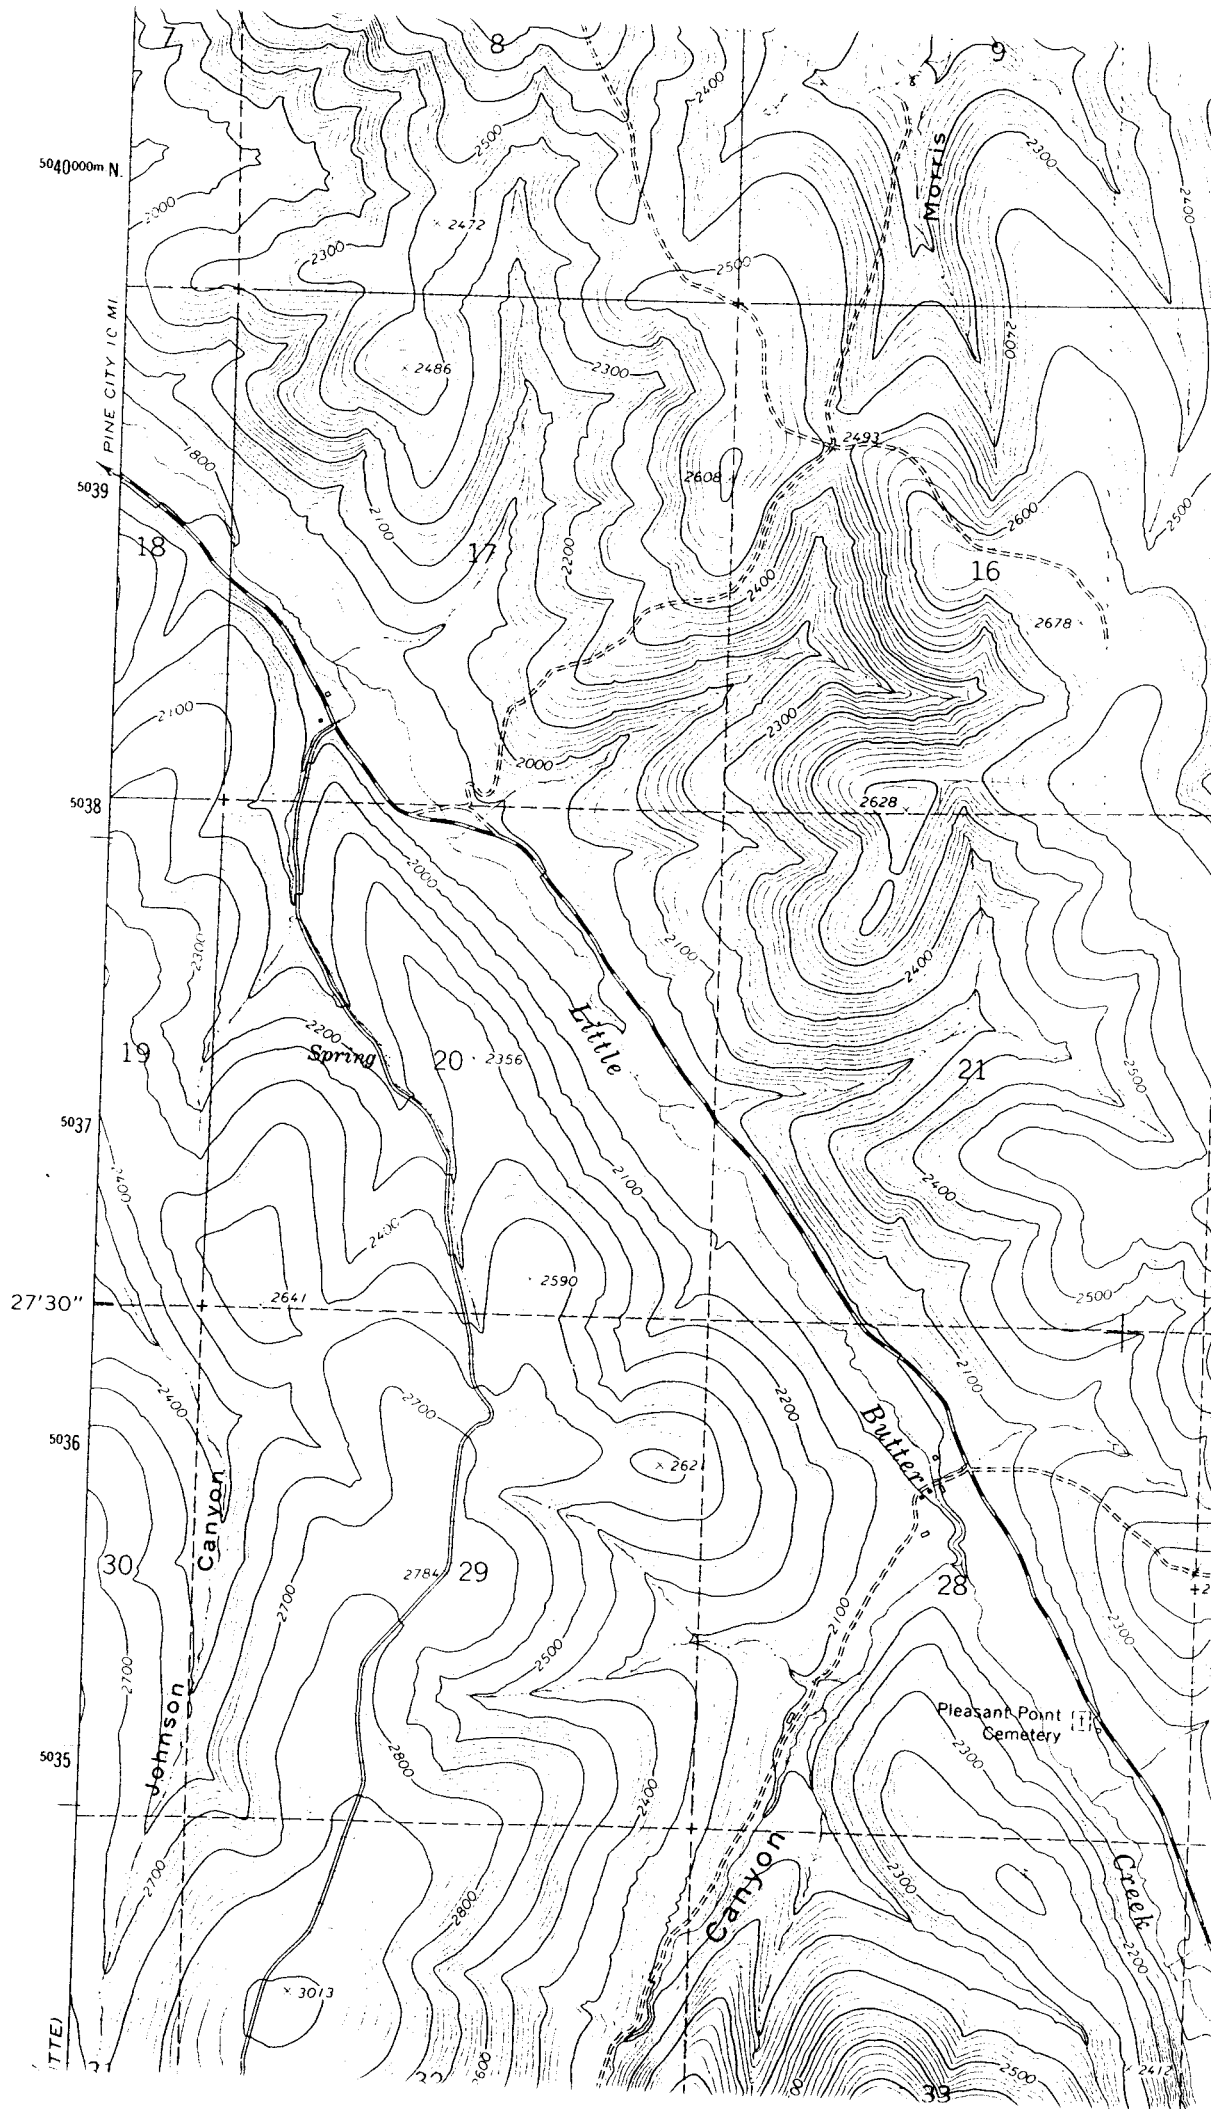


Application No. K-76315  
Permit No.

CERTIFICATE NO. 702770


RECEIVED

JAN - 3 1995


WATER RESOURCES  
SALEM, OREGON

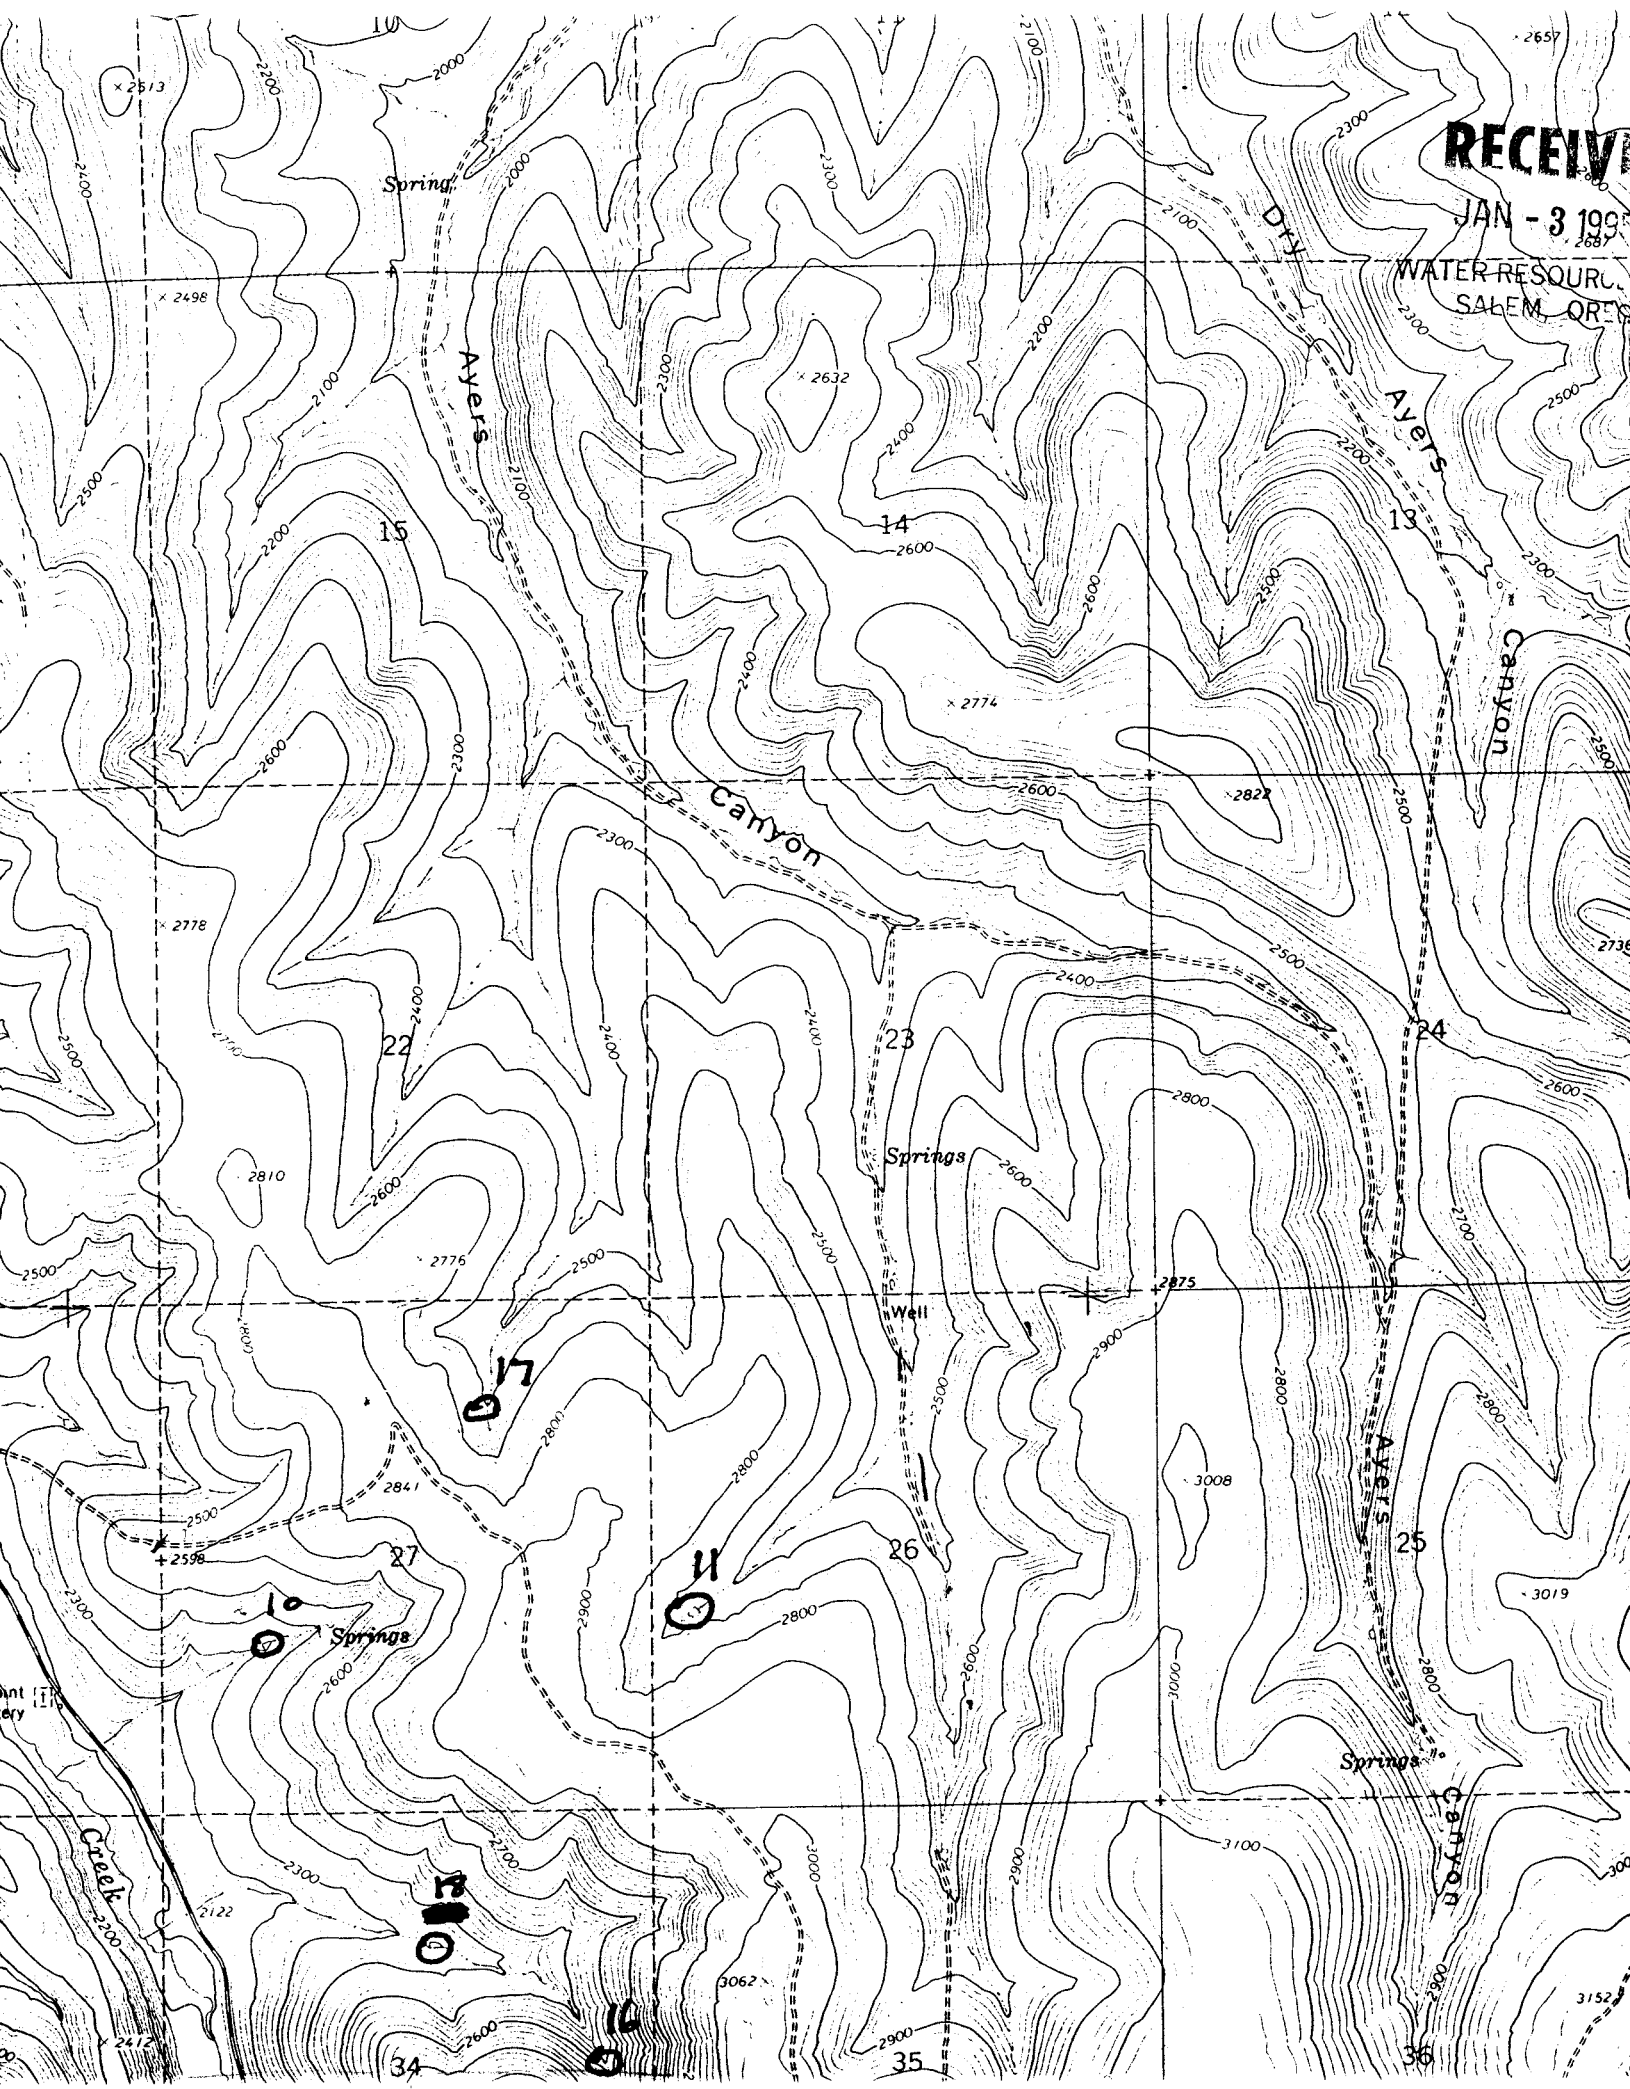

20 FEET  
3A LEVEL

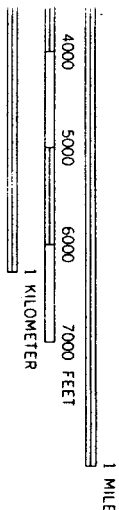

1 MILE

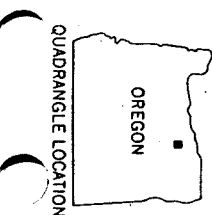

QUADRANGLE LOCATION

BUTTER CREEK JUNCTION, OREG.  
N4530—W11922.5

1068

Medium-duty


Unimproved dirt

Light-duty

State Route


ROAD CLASSIFICATION

INTERIOR GEOLOGICAL SURVEY, WASHINGTON, D. C. 20515  
LENA (OREG. 74) 9 MI.

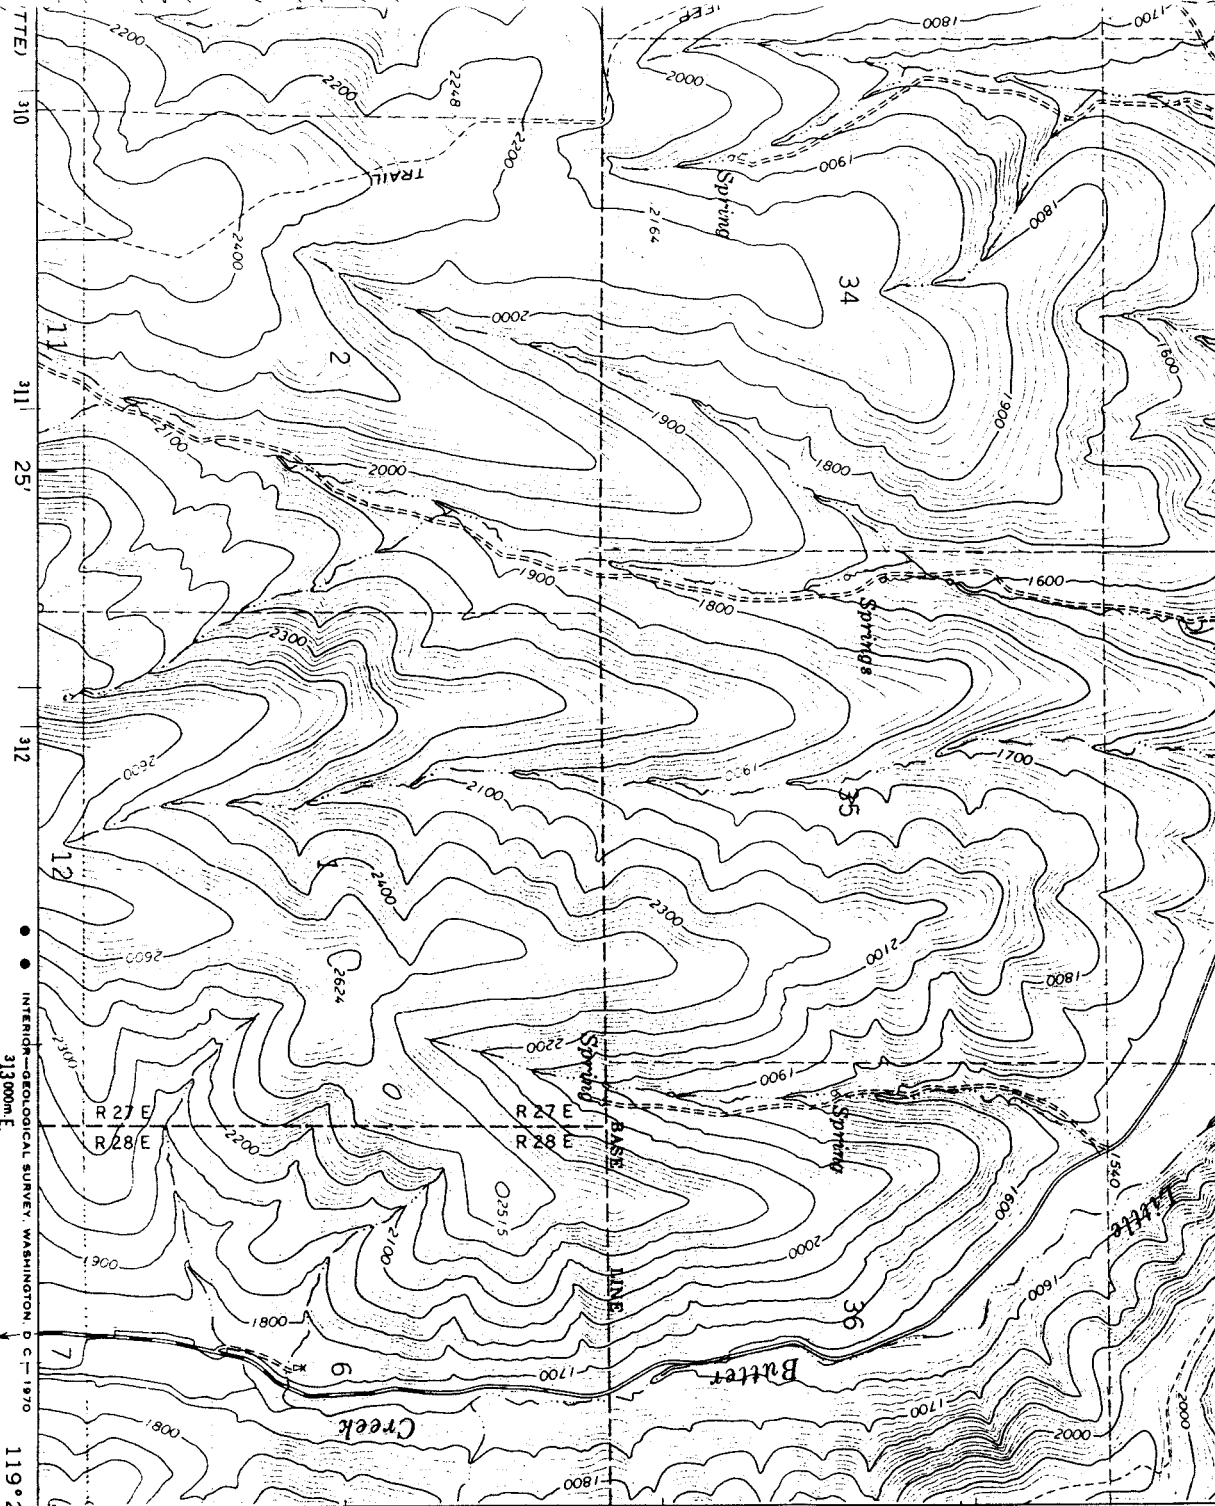

LENA  
2174 IV NE

Application No. R-76315  
Permit No.

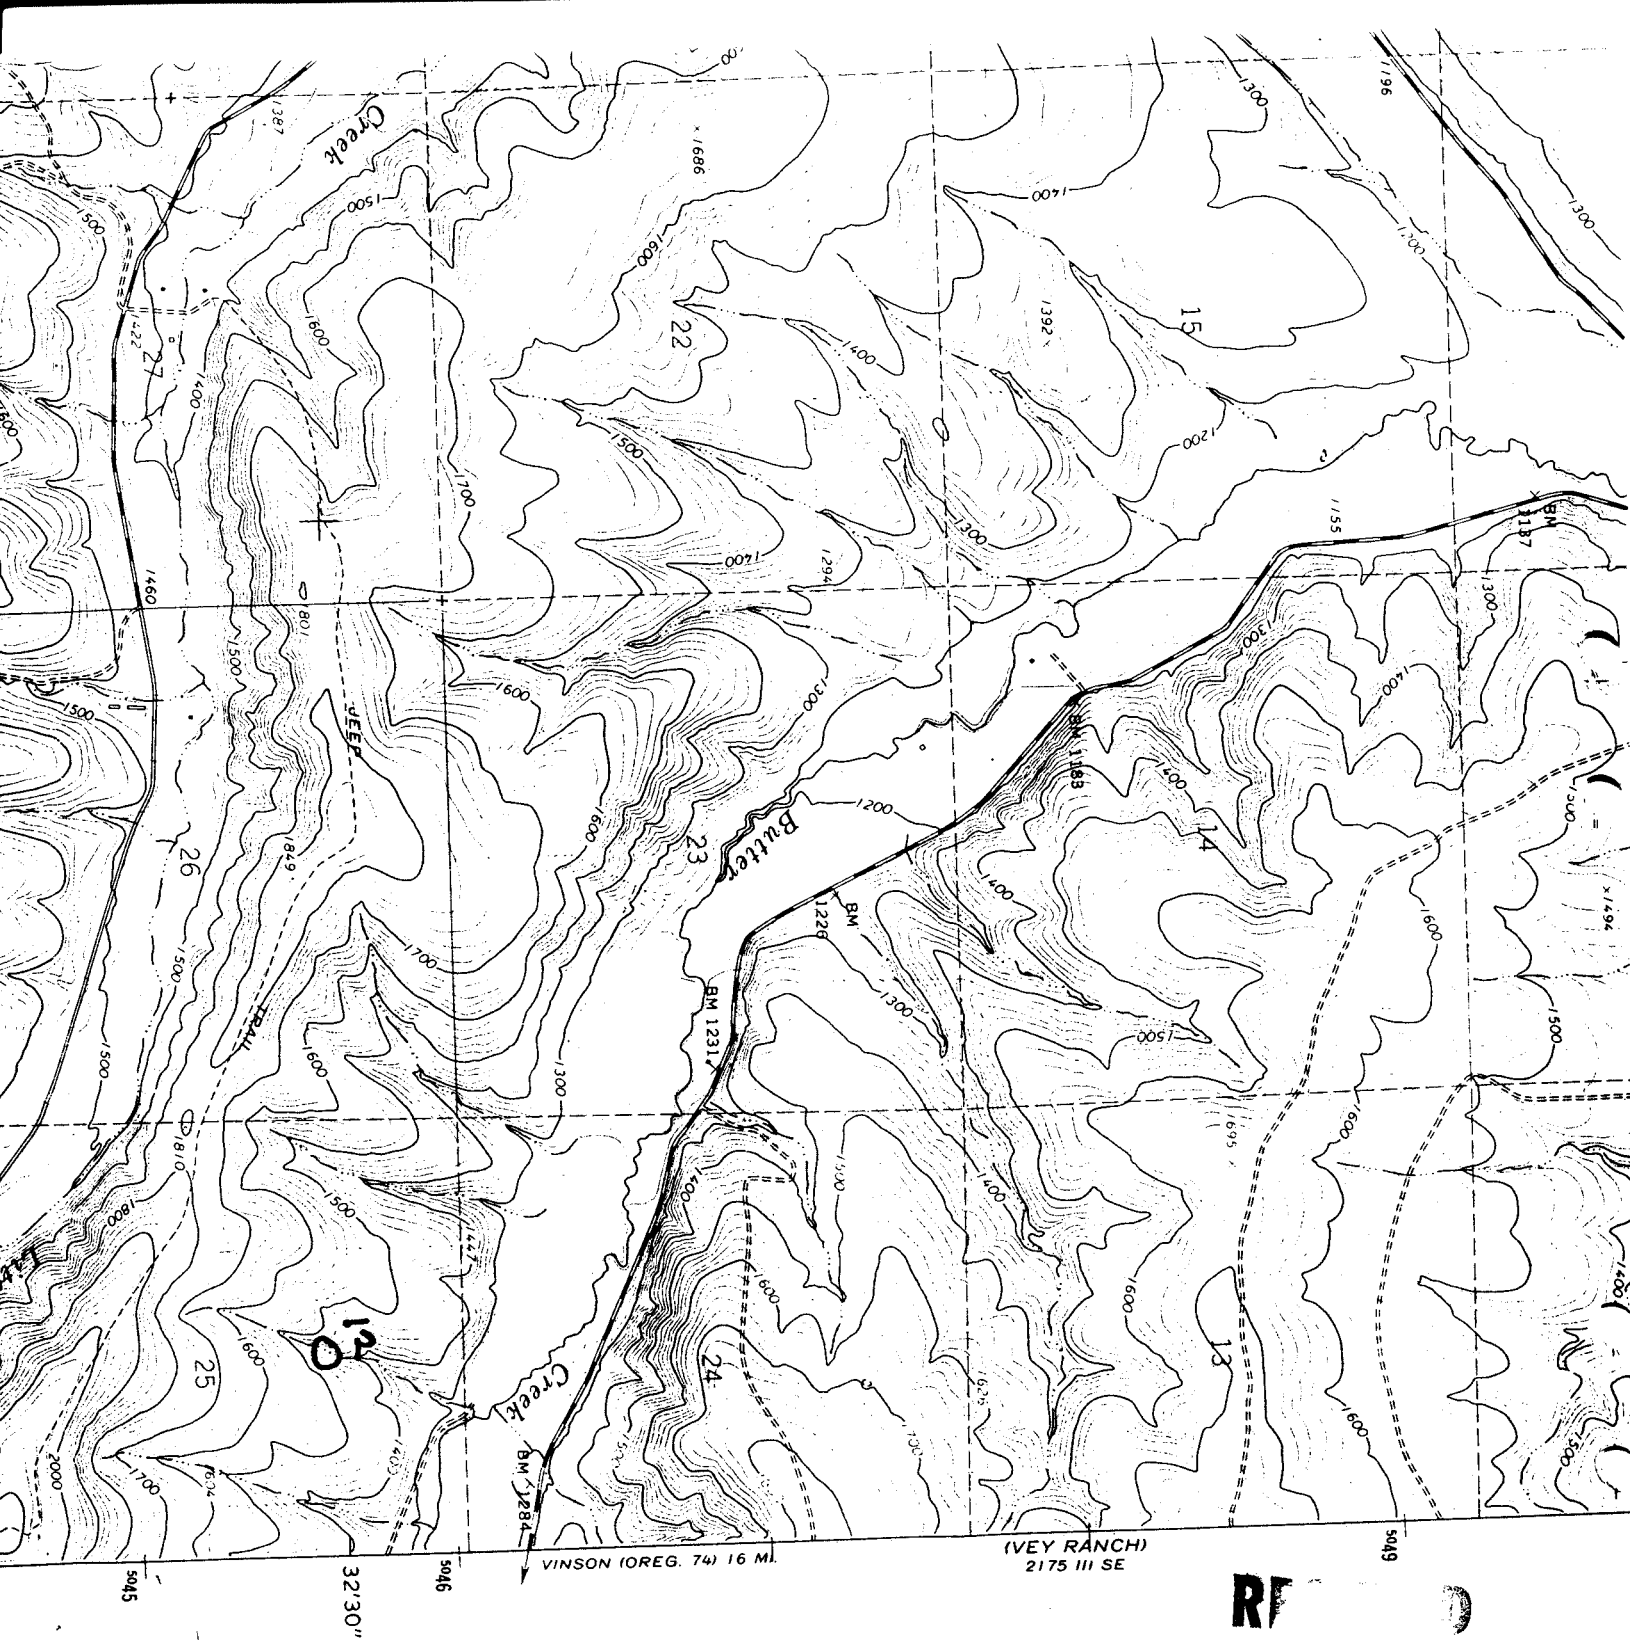

RF

JAN

WATER RESOURCES DEPT  
SALEM, OREGON


**RECEIVED**

JAN - 3 1995

WA. RESOURCES DEPT  
SALEM, OREGON

680 000  
FEET



45°30'  
119°22'30"

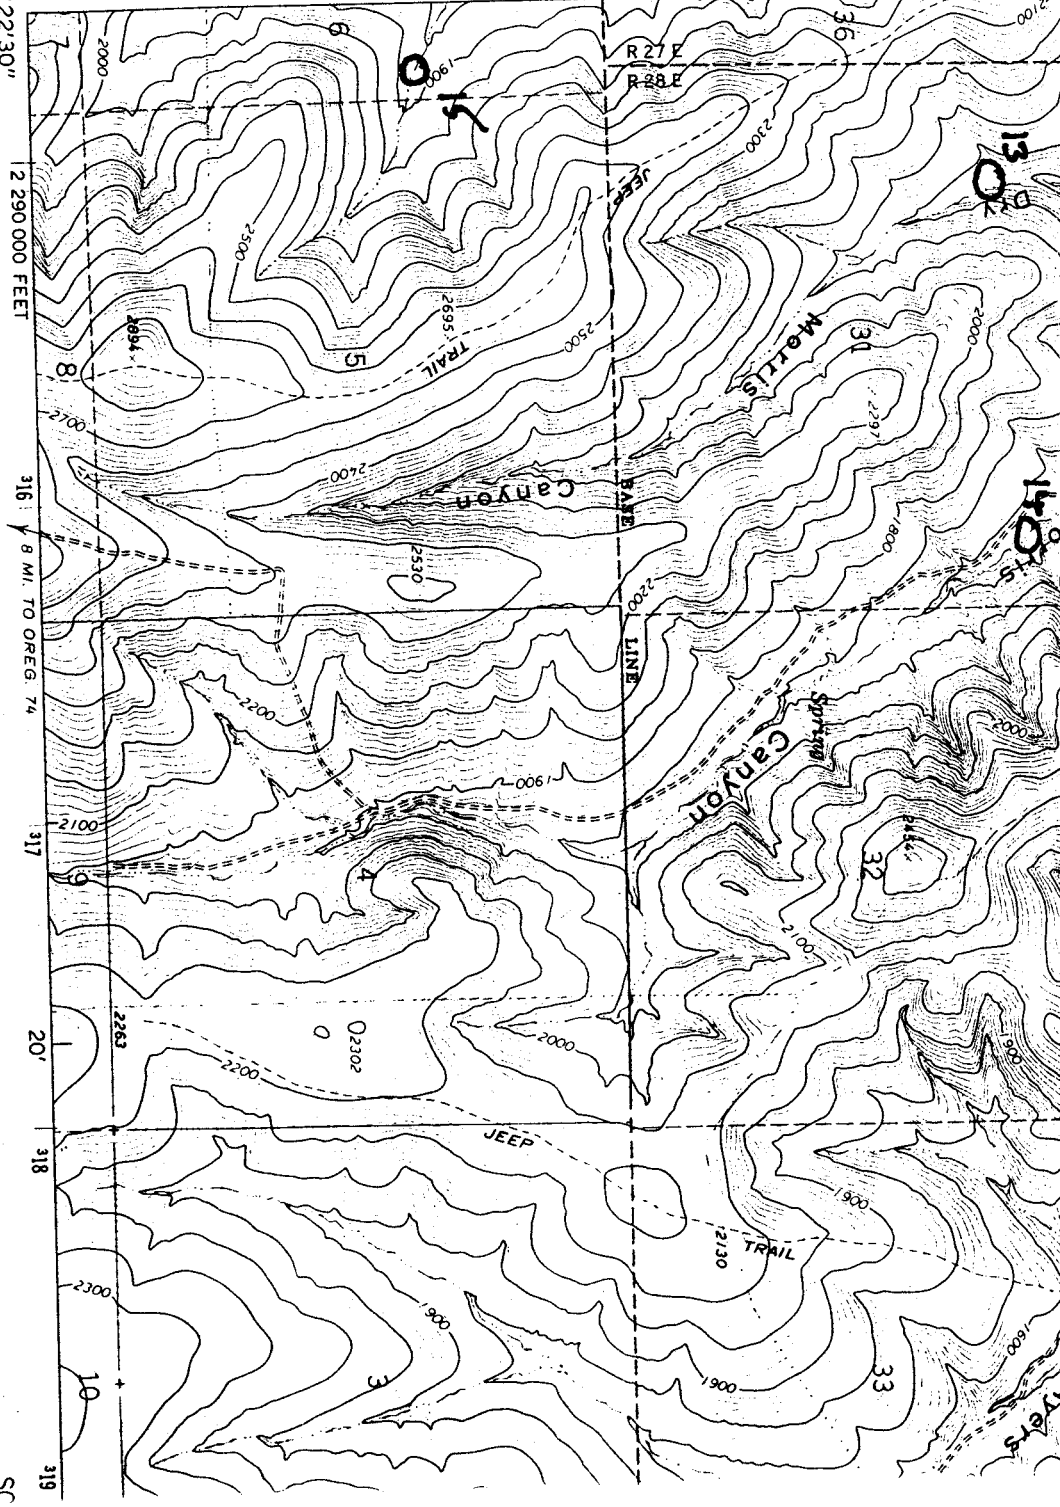

Mapped, edited, and published by the Geological Survey  
Control by USGS and USC&GS

Topography by photogrammetric methods from aerial  
photographs taken 1965. Field checked 1968  
Polyconic projection. 1927 North American datum,  
10,000-foot grid based on Oregon coordinate system,  
north zone  
1000-meter Universal Transverse Mercator grid ticks,  
zone 11, shown in blue  
Fine red dashed lines indicate selected fence lines

UTM GRID AND 1968 MAGNETIC NORTH  
DECLINATION AT CENTER OF SHEET

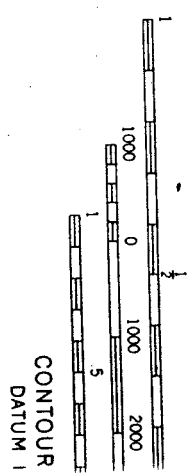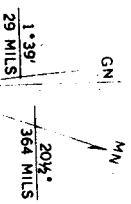

THIS MAP COMPLIES WITH  
FOR SALE BY U.S. GEOLOGICAL SURVEY  
A FOLDER DESCRIBING TOPOGRAPHIC

Application No. R-76315  
Permit No.

REC

JAN -

WATER RES.  
SALEM, C

