


Application No. **6-76314**
 Permit No.


RECEIVED
 JAN - 9 1995
 WASHINGTON
 SALEM, OREGON
 DEPT. OF LAND & FOREST
 2174 IV SW

Mapped, edited, and published by the Geological Survey
 Control by USGS and USC&GS
 Topography by photogrammetric methods from aerial
 photographs taken 1965. Field checked 1968
 Polyconic projection. 1927 North American datum
 10,000-foot grid based on Oregon coordinate system,
 north zone
 1000-meter Universal Transverse Mercator grid ticks,
 zone 11, shown in blue


UTM GRID AND 1988 MAGNETIC NORTH
 DECLINATION AT CENTER OF SHEET

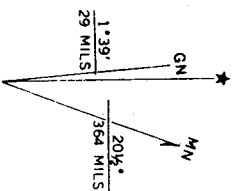

THIS MAP COMPLIES WITH
 FOR SALE BY U.S. GEOLOGICAL SURVEY, DE
 A FOLDER DESCRIBING TOPOGRAPHIC

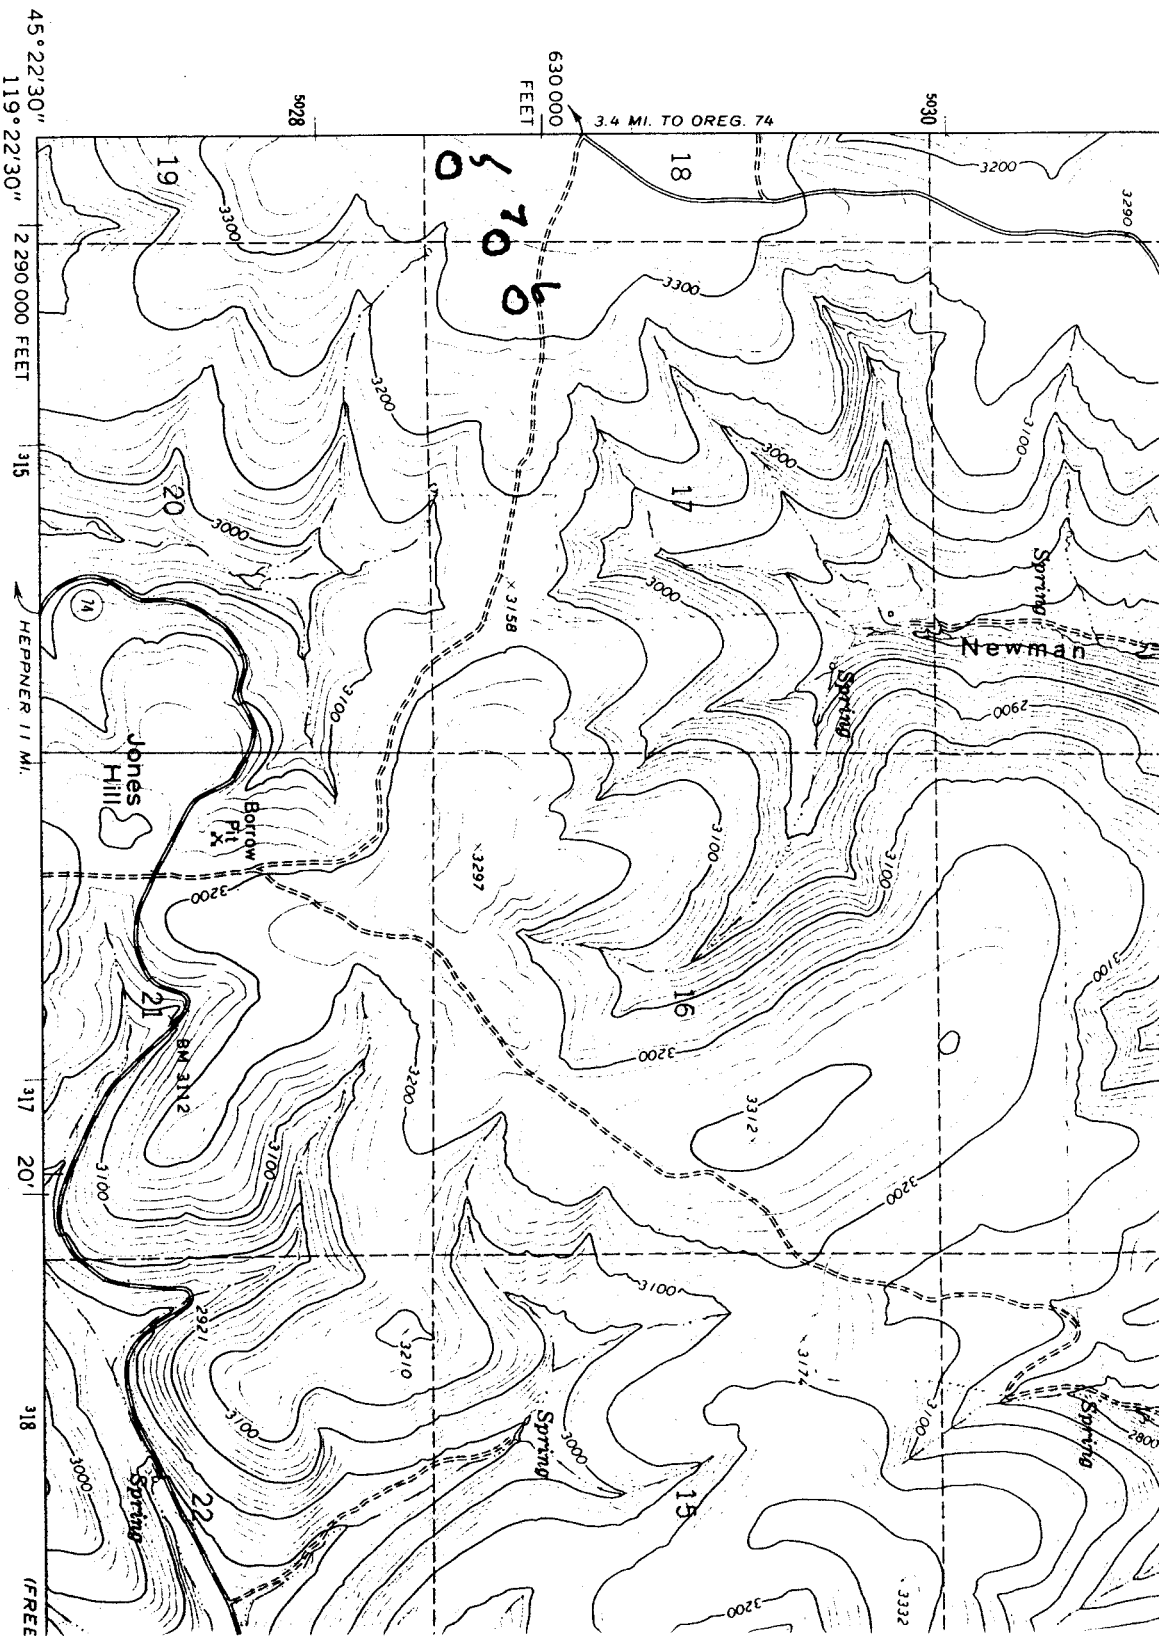

L 20 FEET
SEA LEVEL

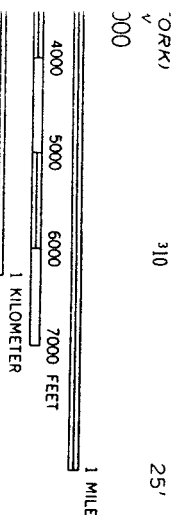

Application No.
Permit No.

Medium-duty

Light-duty
Unimproved dirt

ROAD CLASSIFICATION

GLEASON BUTTE, OREG.

N4522.5—W11922.5/7.5


WATERMASTER DIST. 5
County Courthouse — Reagent
Pendleton, Oregon

(FREEZEOUT RIDGE)
2174 IV SE

WALTON RESOURCES DEP.
SALEM, OREGON

JAN - 3 1995

RECEIVED

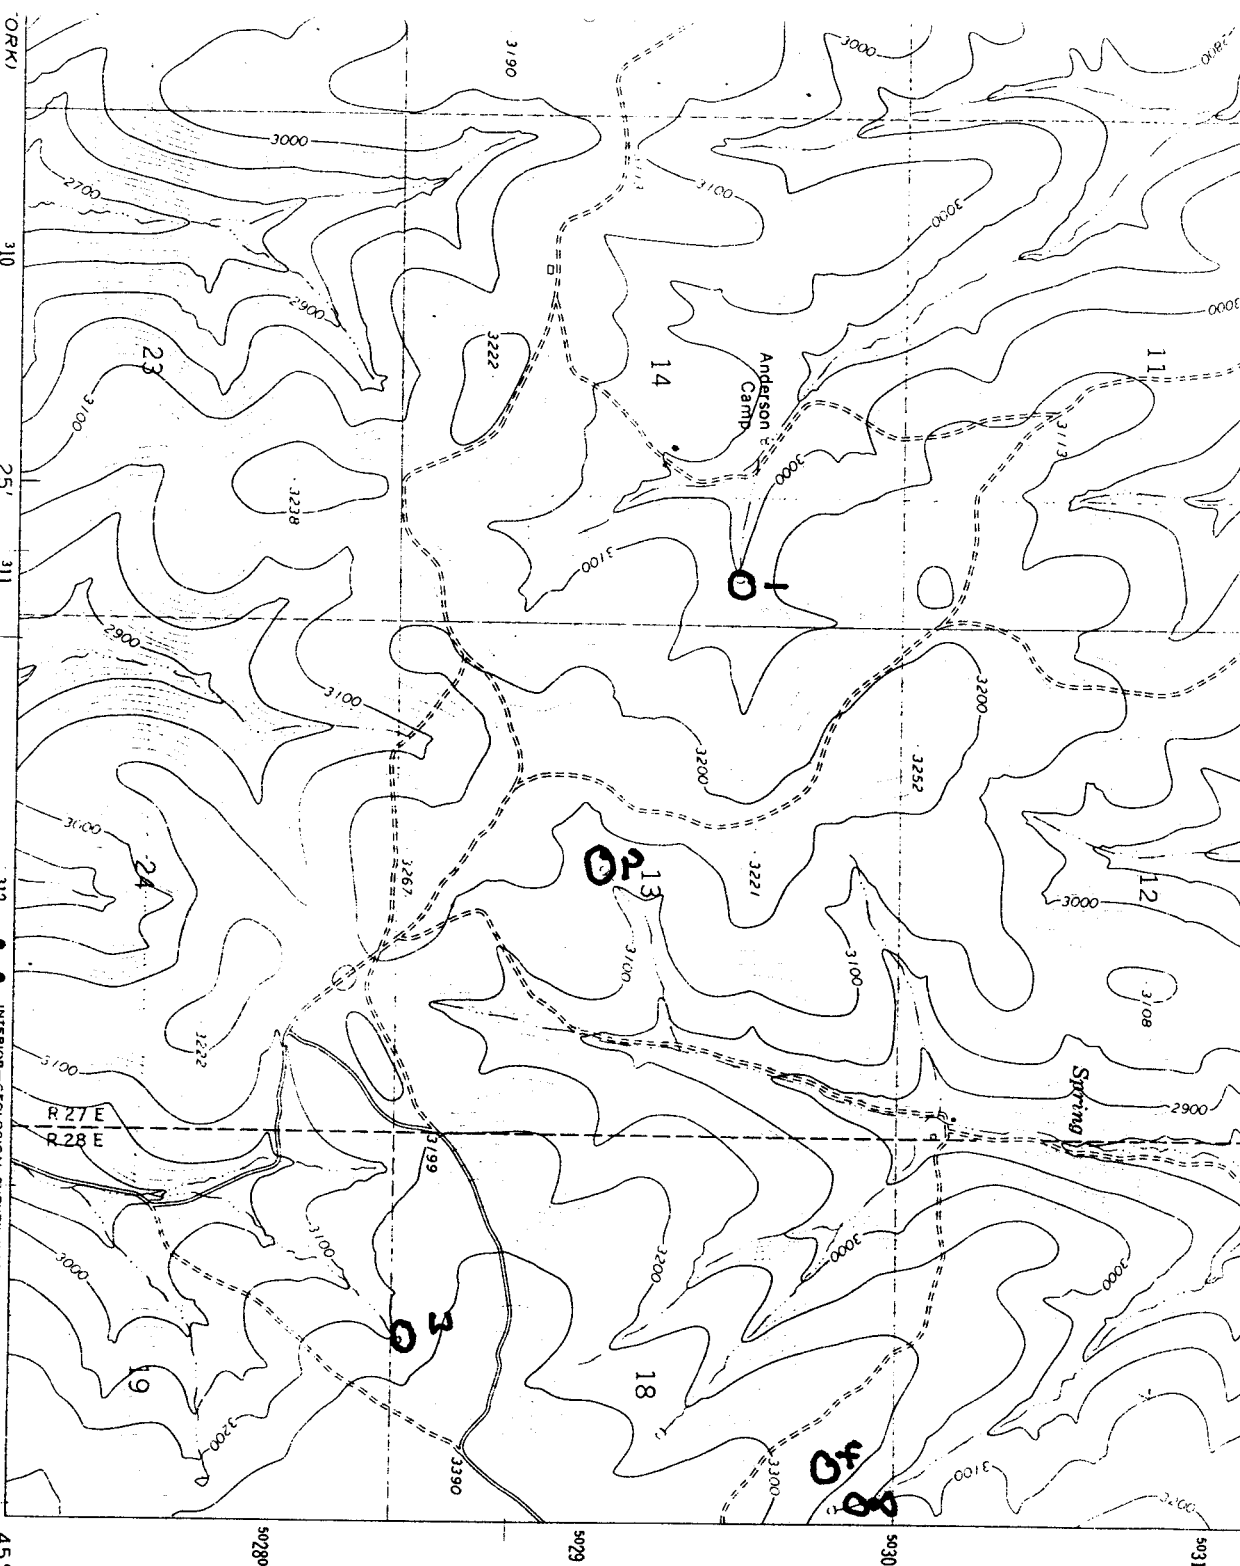

5040000m N

PINE CITY 10 MI

5039

18

17

16

5038

19

Spring

20

2356

21

5037

27'30"

5036

30

Johnson Canyon

29

2784

28

5035

Johnson Canyon

Butler Canyon

Pleasant Point Cemetery

Crazy Canyon

Application No. R-7631
Permit No.

RECEIVED
JAN - 3 1995
U.S. RESOURCES DEF
SALEM, OREGON

