


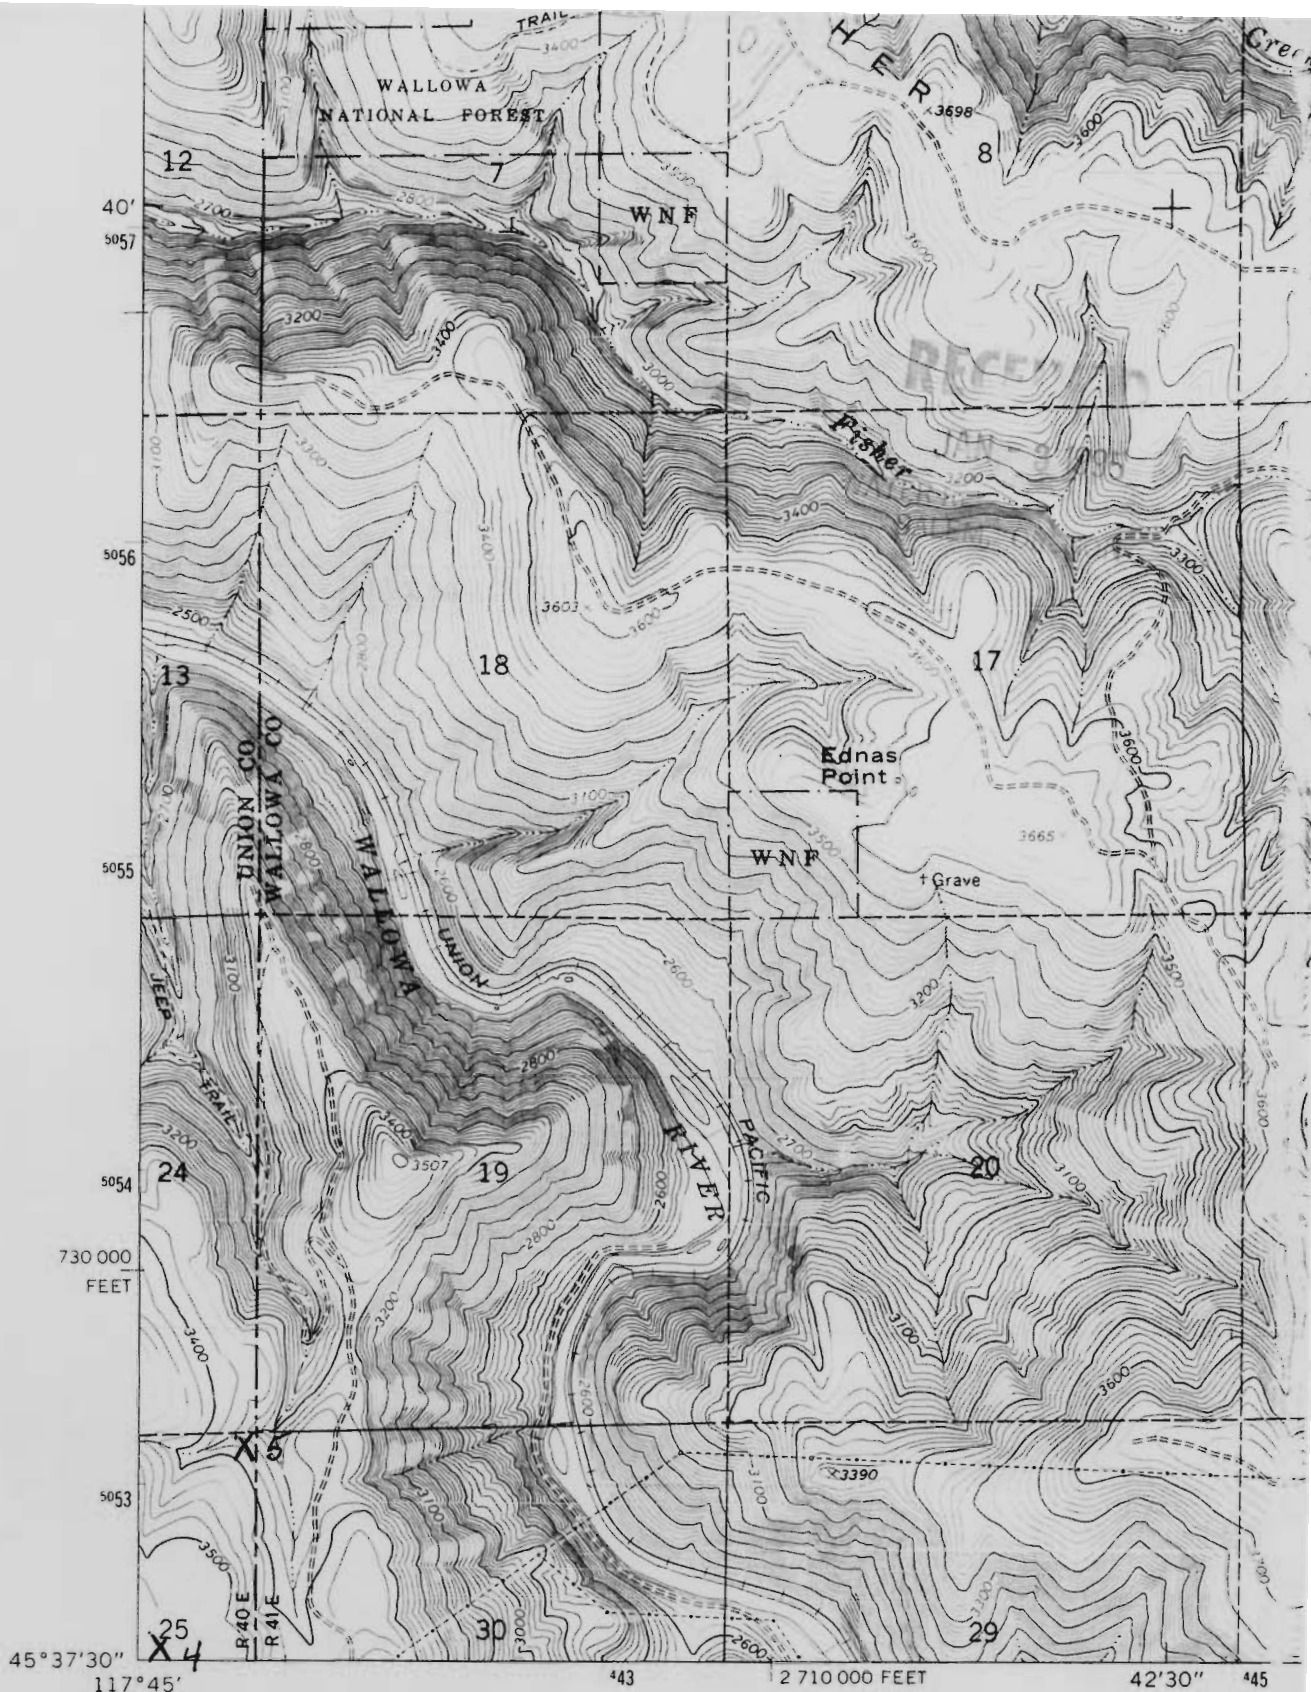


Mapped, edited, and published by the Geological Survey

Control by USGS and USC&GS

Topography by photogrammetric methods from aerial photographs taken 1959. Field checked 1964

Polyconic projection. 1927 North American datum
10,000-foot grid based on Oregon coordinate system;
north zone

1000-meter Universal Transverse Mercator grid ticks,
zone 11, shown in blue

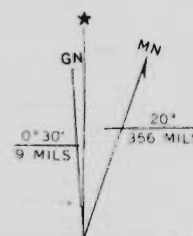

UTM GRID AND 1964 MAGNETIC NORTH
DECLINATION AT CENTER OF SHEET

Application No. **R-76318**
Permit No.

CERTIFICATE NO. **70273**

FOR SALE BY U

Application No. *R-76318*
Permit No.


CRICKET FLAT QUADRANGLE
OREGON-UNION CO.

2475 II NW
(HOWARD BUTTE)

36C

CERTIFICATE NO. **70273** 7.5 MINUTE SERIES (TOPOGRAPHIC)

47°30" 439 440 117°45' 45°37'30"

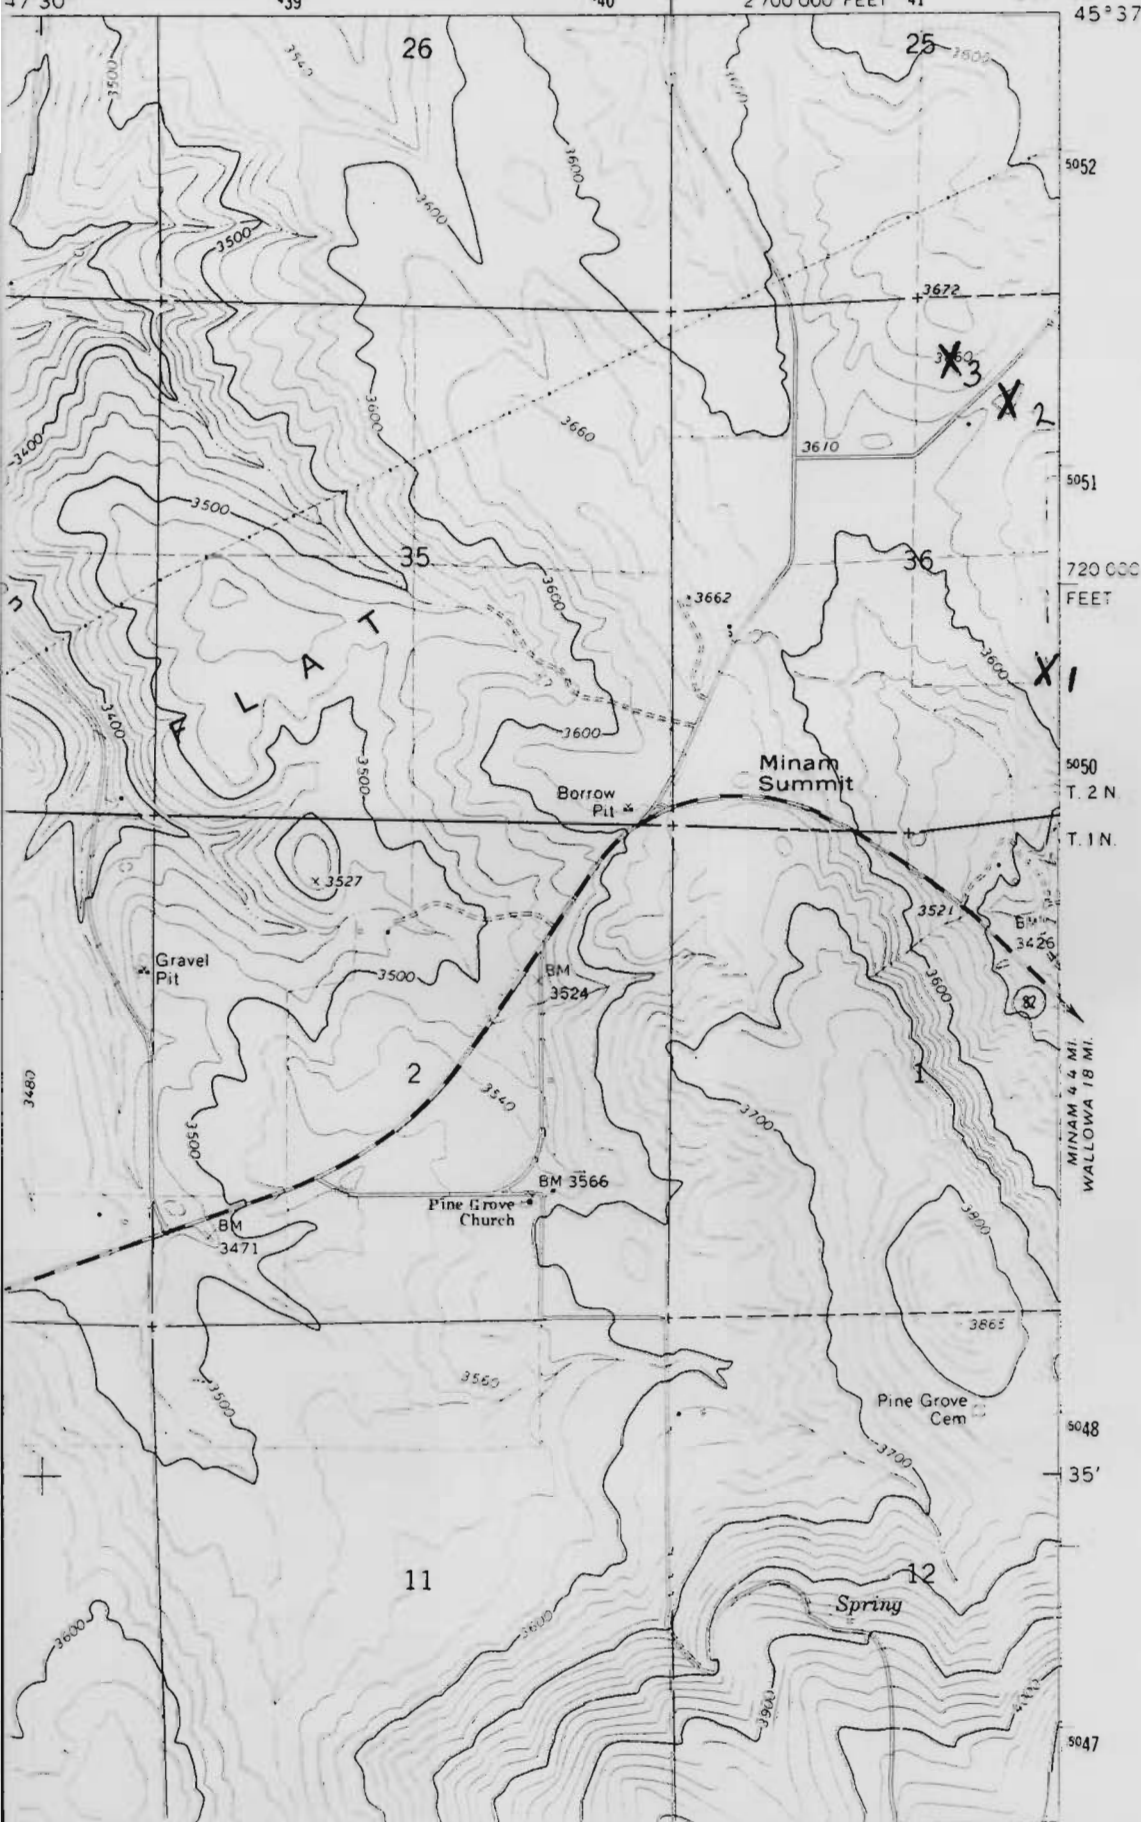

Range
40 E

REC
JAN - 3 1995
WATER R.
SALEM